



34  
22  
17  
11  
5.8  
8.5  
11  
17  
22

34  
22  
17  
11  
5.8  
8.5  
11  
17  
22

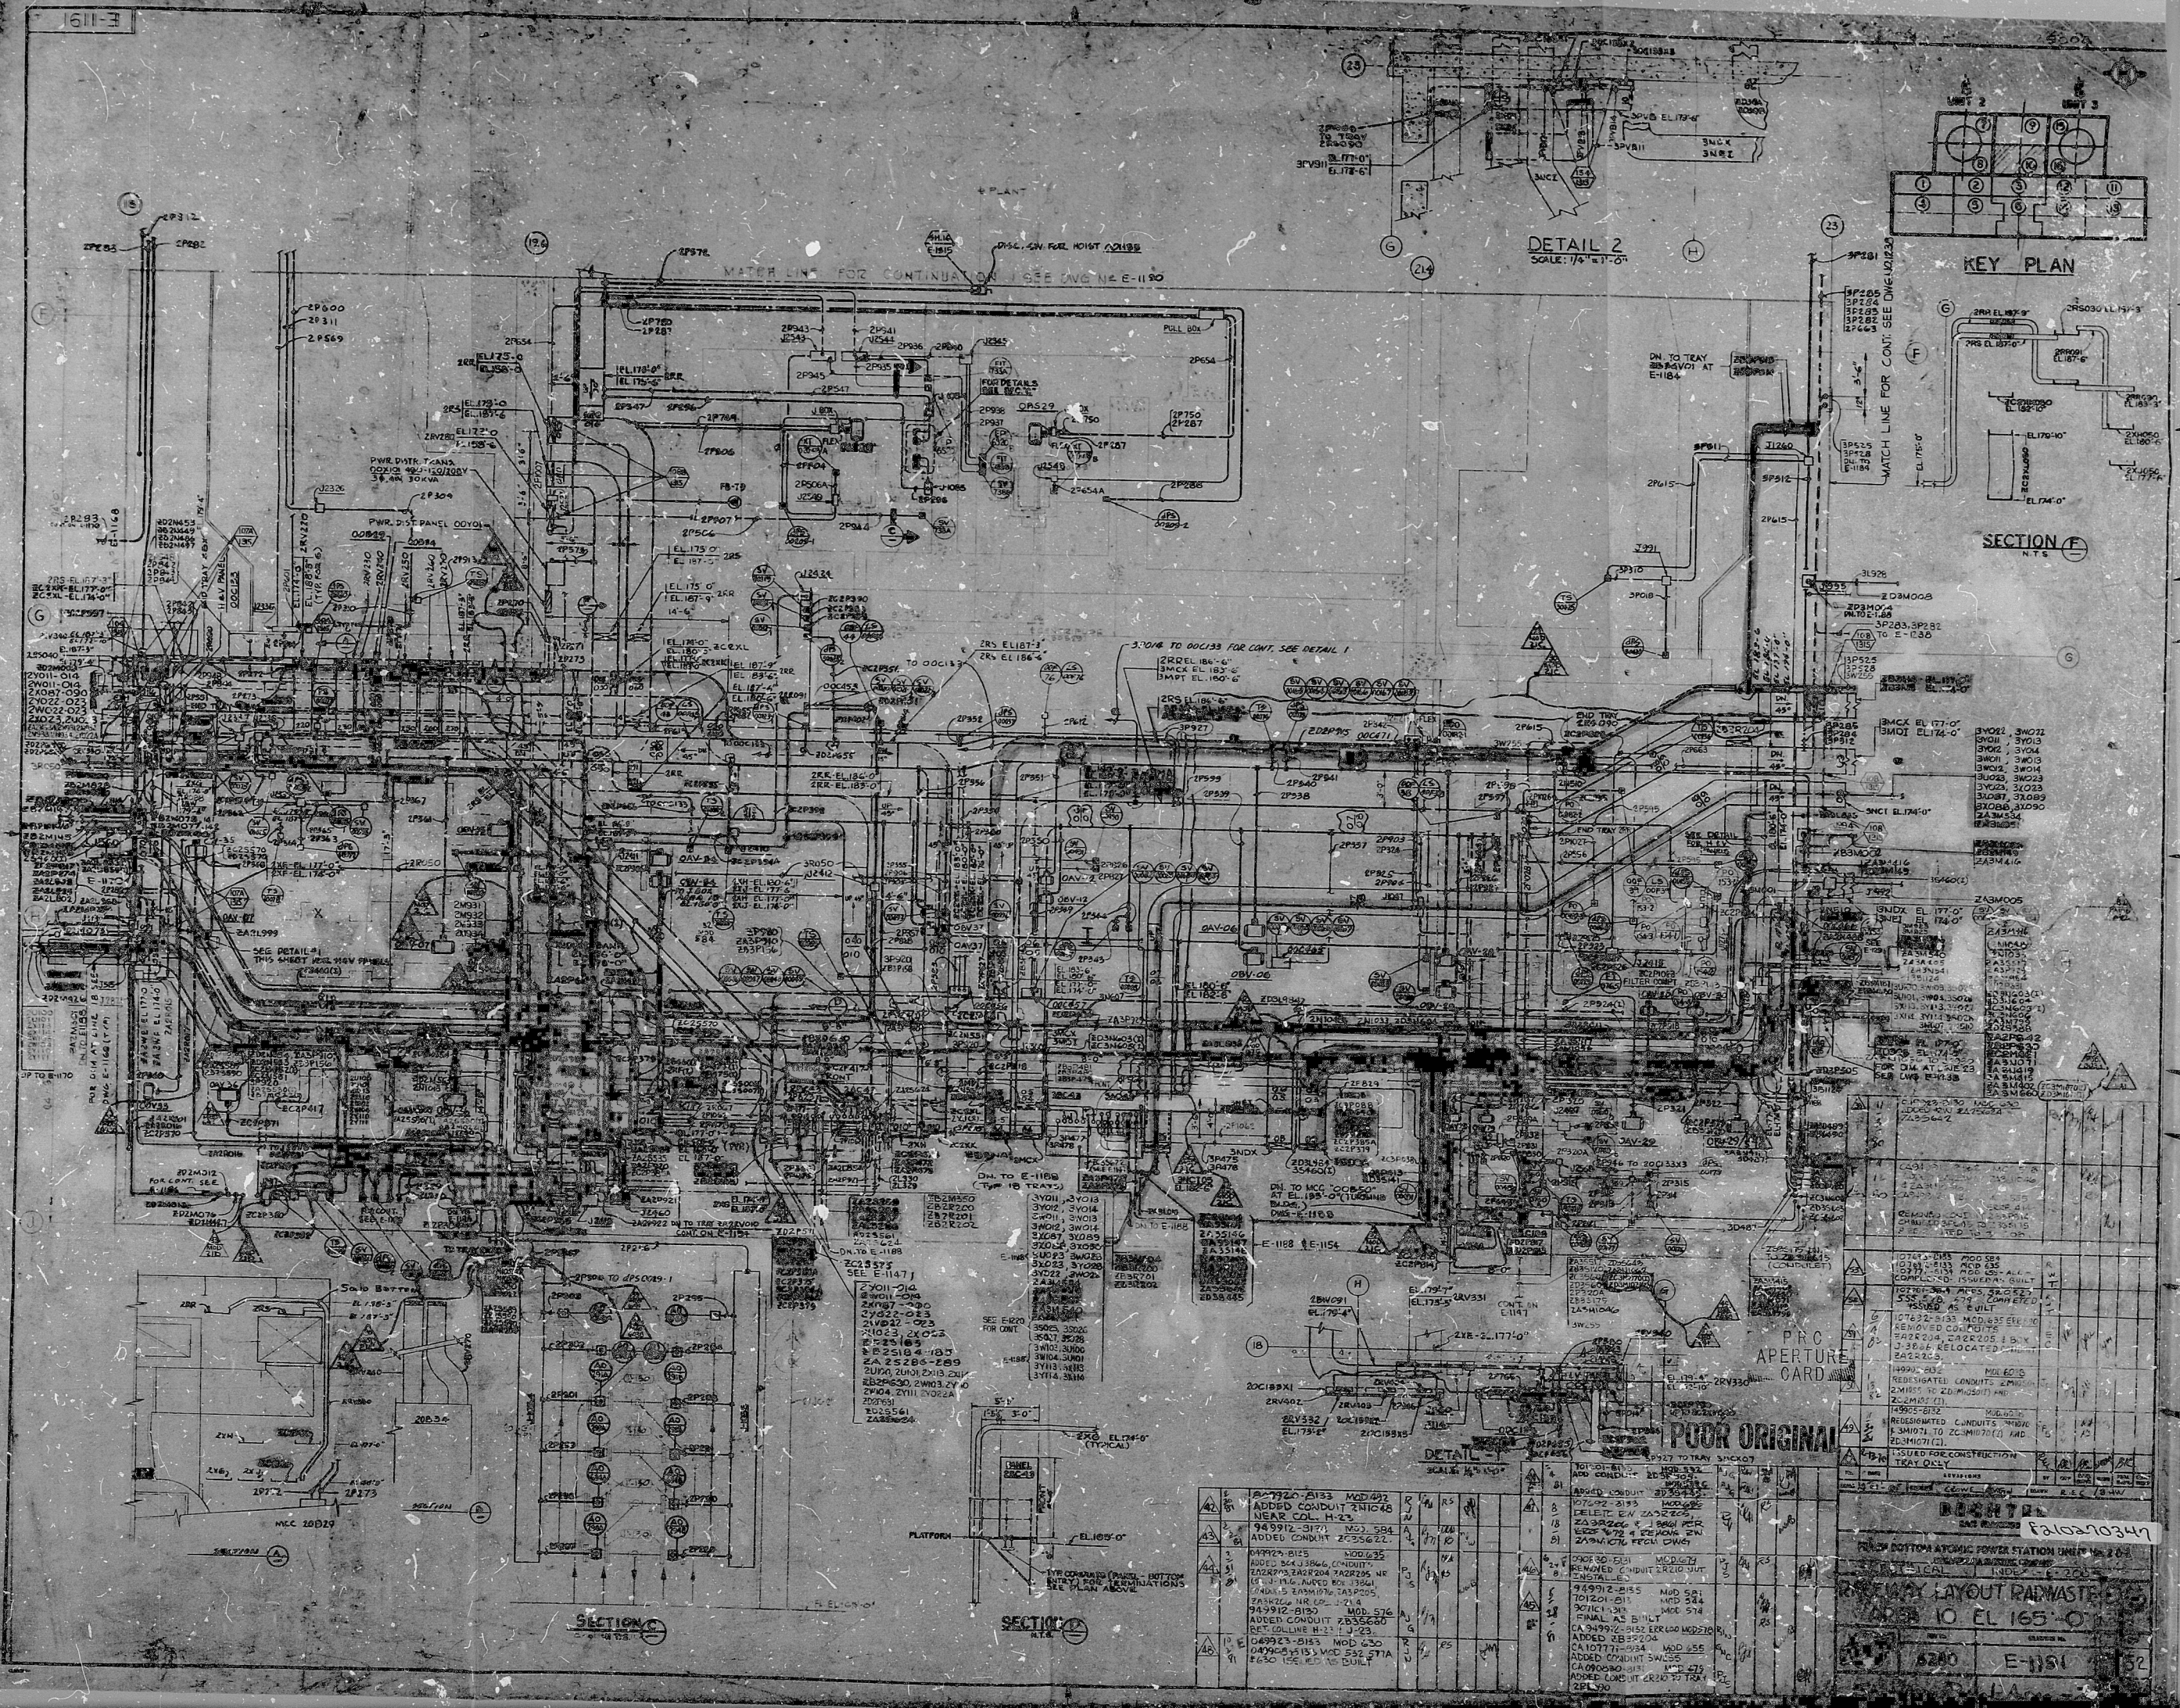

DETAIL 2  
SCALE: 1/4" = 1'-0"

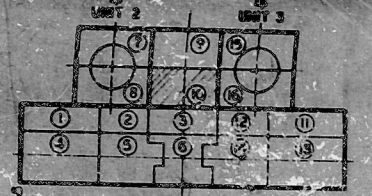

KEY PLAN

SECTION F  
N.T.S.

PRO APERTURE CARD


ISSUED FOR CONSTRUCTION  
TRAY ONLY

10 EL 165'-0"

5200 E-1191 32



RIDS

8210270347

