

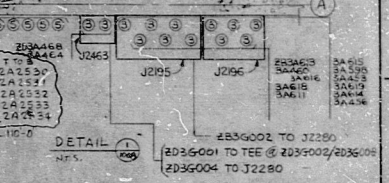
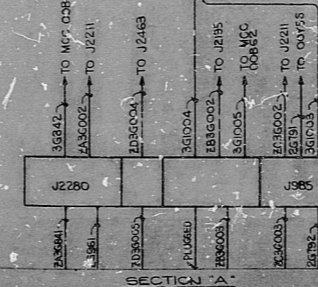


NOTE:
 1. FOR NOTES, TYPICAL DIMENSIONS & DETAILS SEE DWG E-1004.
 2. STUB UP DETAILS SEE DWG E-1006 DETAILS 4, 5 & 10.
 3. PROVIDE BARRIERS BETWEEN SAFEGUARD CONDUITS OF J2195, J2211, J2279 AND J2280.

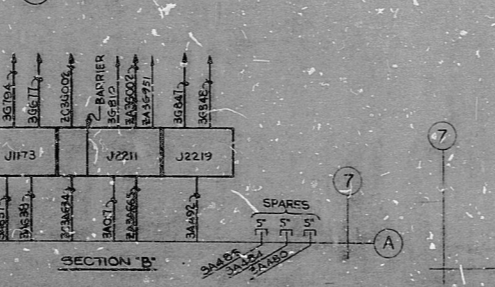

1	REMOVED JOINT FROM 30606 TO 30607	REVISED AS BUILT PER	

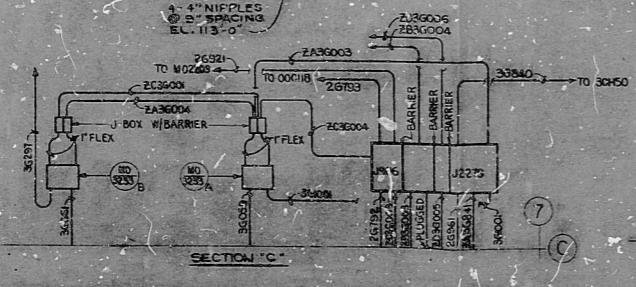

1	CA 2071-815 MOD 573	REVISED AS BUILT PER	

POOR ORIGINAL
PRC
APERTURE
CARD

CA 2071-815 MOD 573
 1. REMOVED JOINT FROM 30606 TO 30607

BECHTEL
 PEACH BOTTOM ATOMIC POWER STATION UNITS No. 2 & 3
 PHILADELPHIA ELECTRIC COMPANY
ELECTRICAL INDEX E-2008
RACEWAY & GROUNDING LAYOUT
PUMP STRUCTURE UNIT 3

NO.	REVISED BY	DATE
6280	E-1008	23

8202703d

R.D.S

8210270361

