


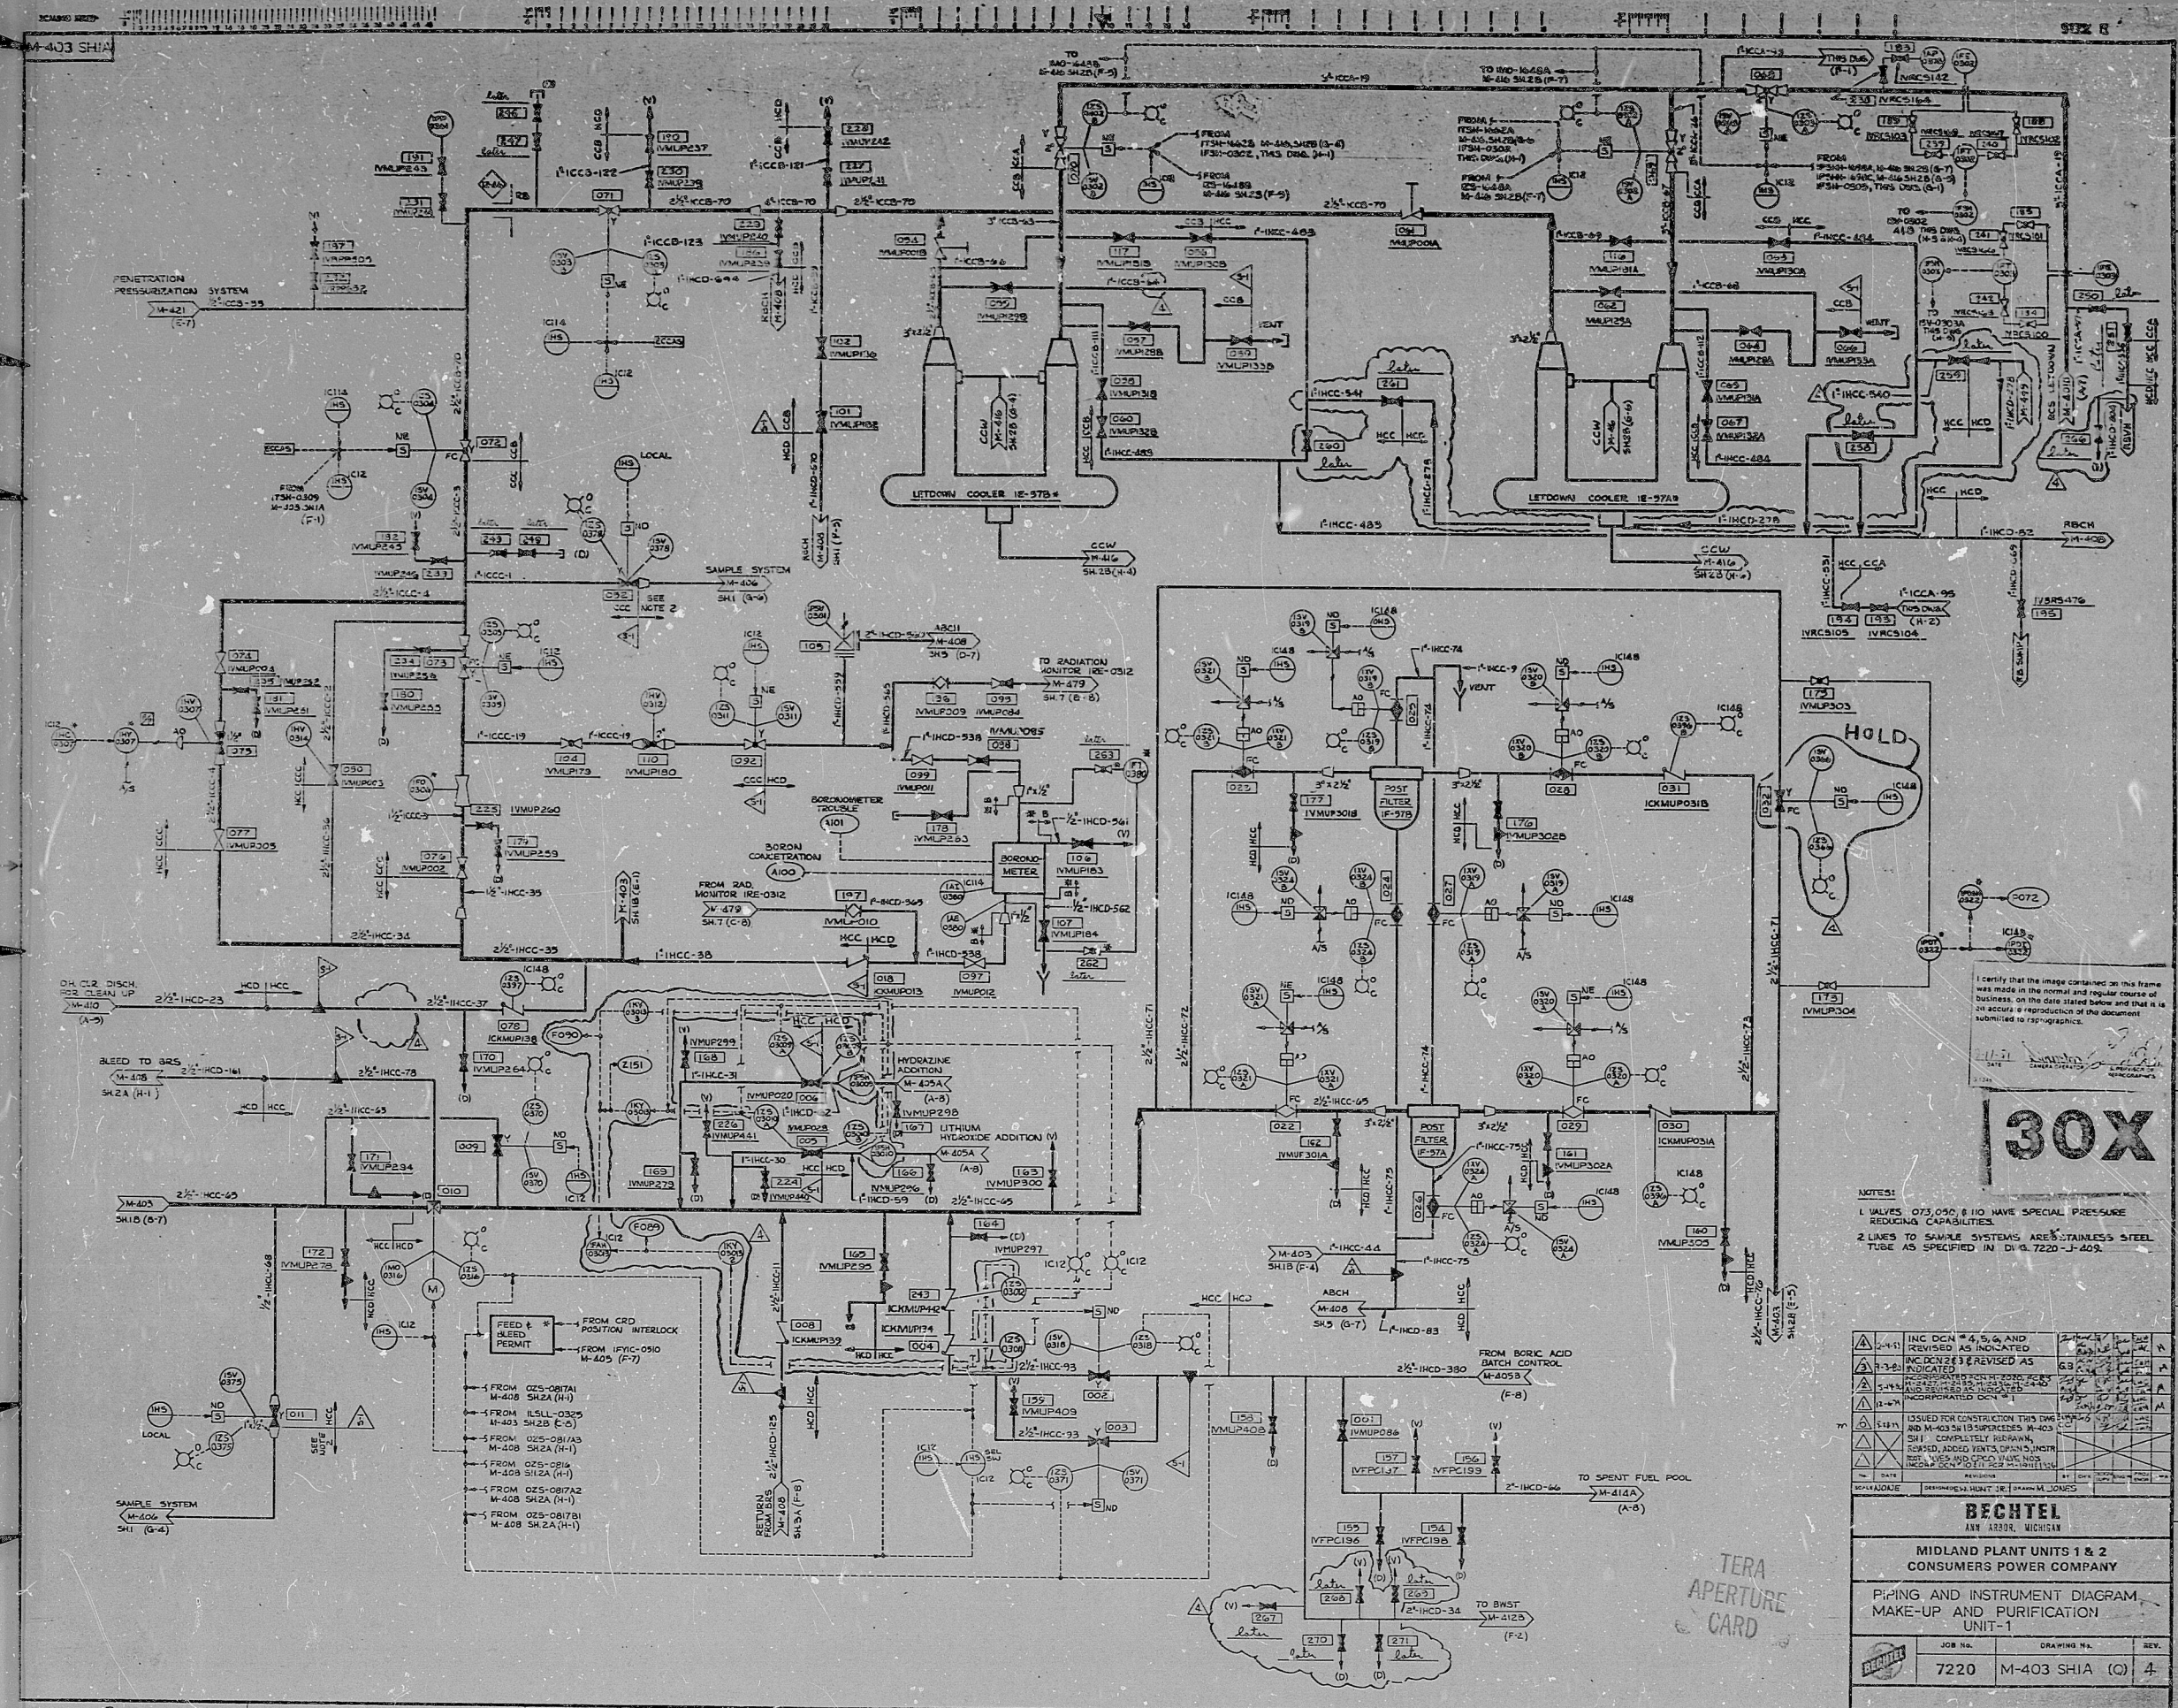

NOTES:


30X

NO.	DESCRIPTION	DATE	BY	CHKD.	APPD.
2	REVISIONS				

BECHTEL
ANN ARBOR, MICHIGAN

MIDLAND PLANT UNITS 1 & 2
CONSUMERS POWER COMPANY

PIPING AND INSTRUMENT DIAGRAM
MAKE-UP AND PURIFICATION
UNIT-1

JOB NO.	DRAWING NO.	REV.
7220	M-403 SHIA	(C) 4

RIDS

8106040024

