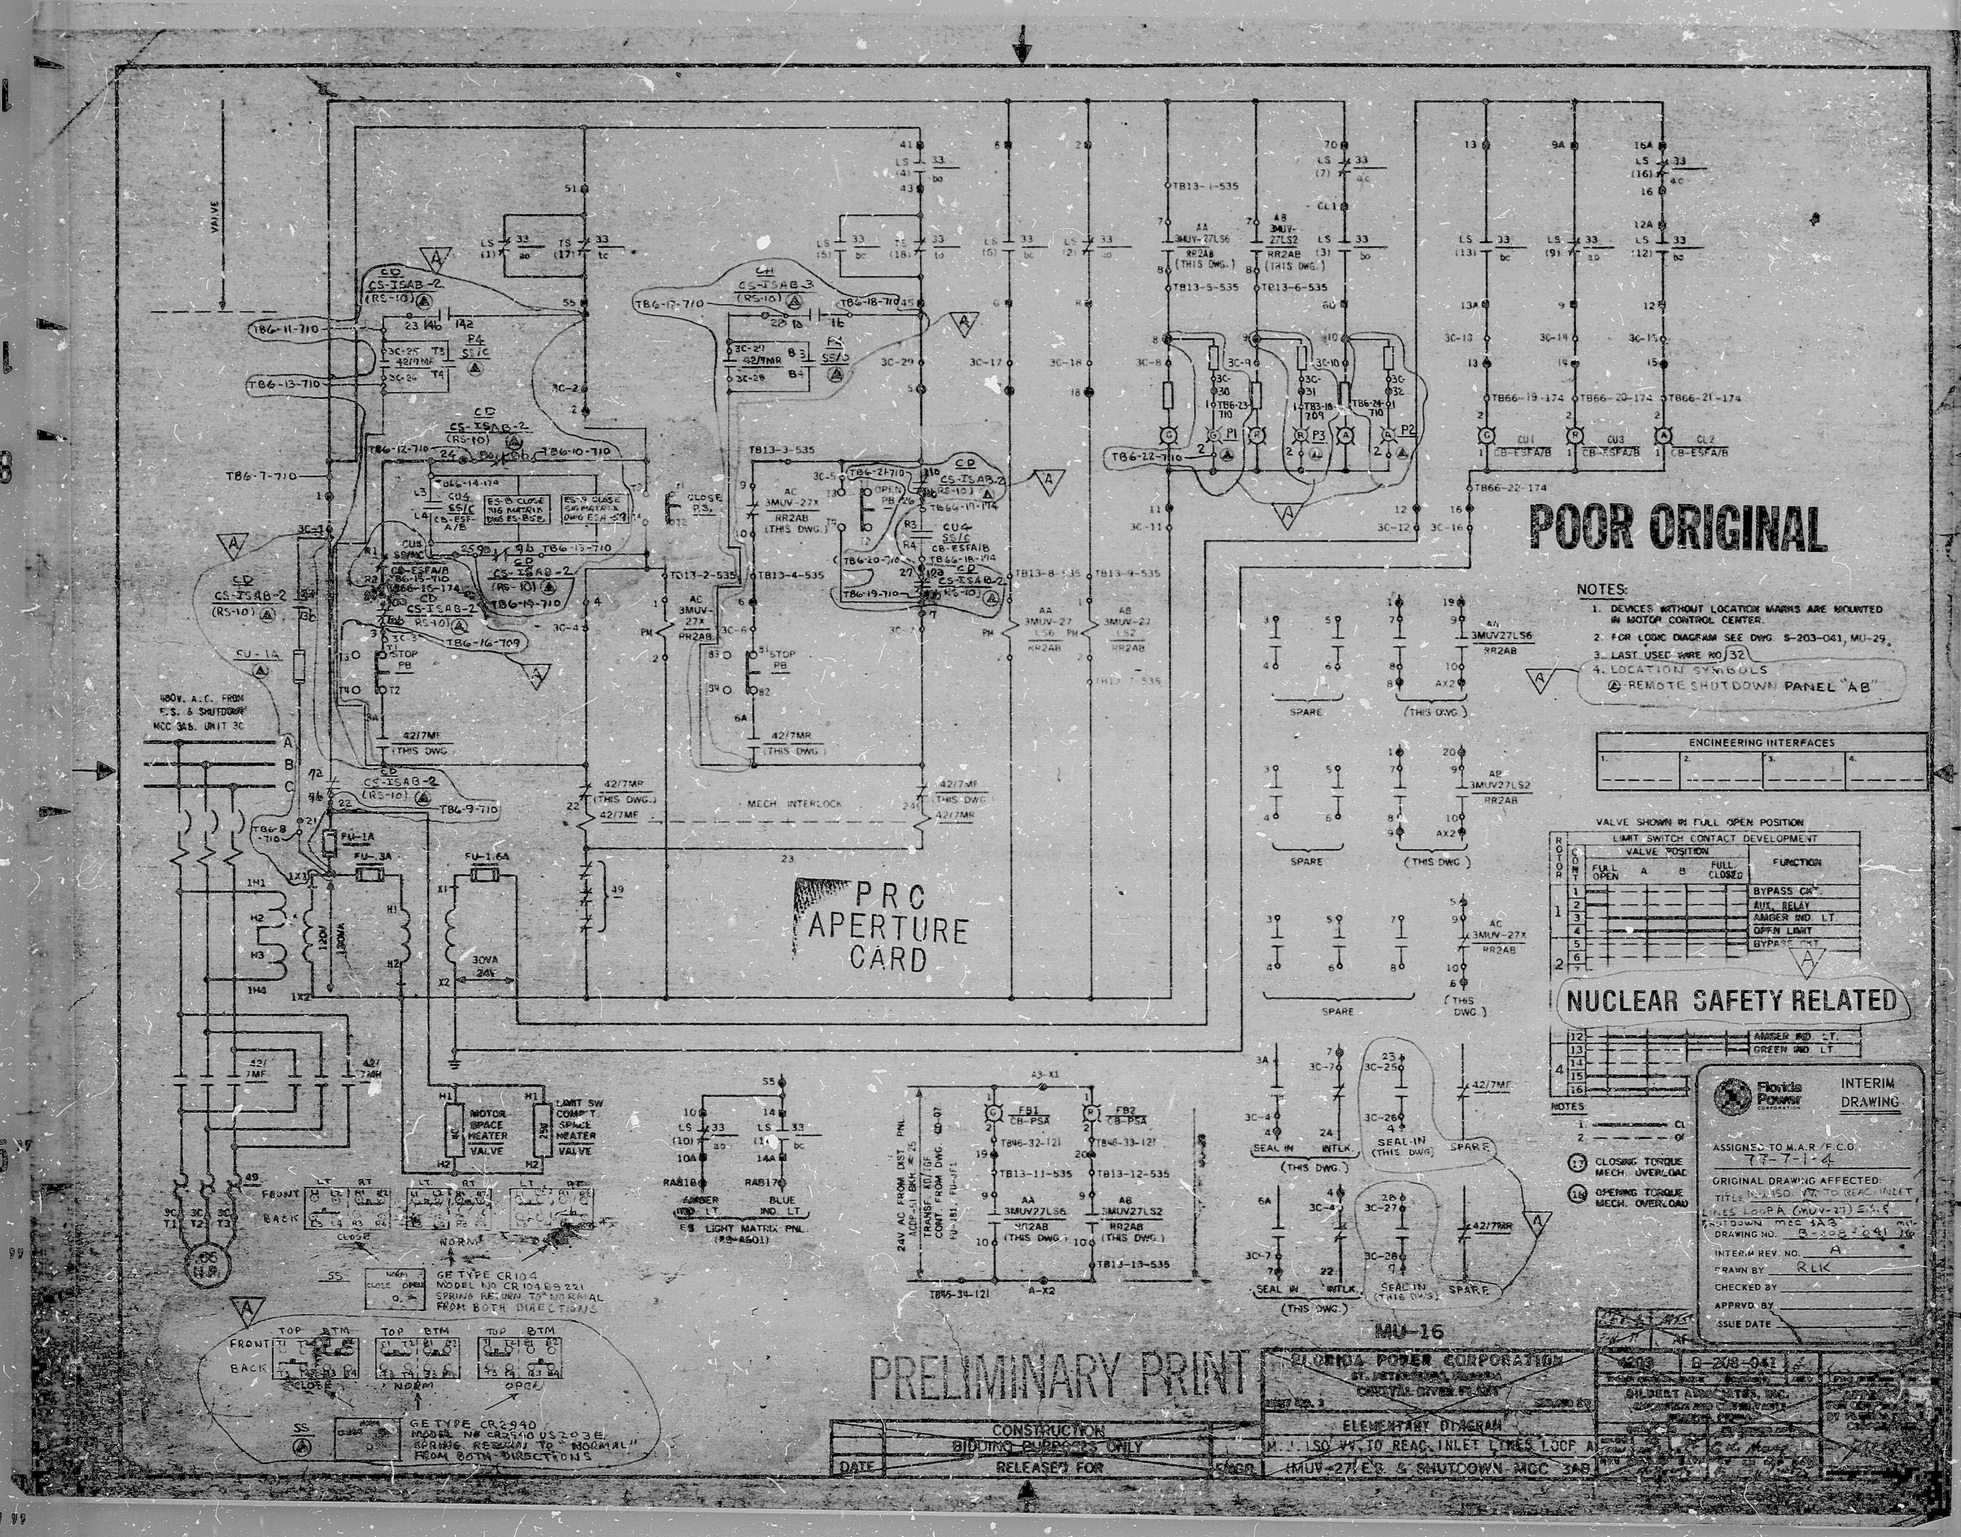

POOR ORIGINAL
NOTES:
1. DEVICES WITHOUT LOCATION MARKS ARE MOUNTED IN MOTOR CONTROL CENTER.
2. FOR LOGIC DIAGRAM SEE DWG. S-203-041, MU-29.
3. LAST USED WIRE NO. 32
4. LOCATION SYMBOLS
(A) REMOTE SHUTDOWN PANEL "AB"
ENGINEERING INTERFACES
VALVE SHOWN IN FULL OPEN POSITION
LIMIT SWITCH CONTACT DEVELOPMENT
FUNCTION
BYPASS CKT.
AUX. RELAY
AMBER IND. LT.
OPEN LIMIT
BYPASS CKT.
NUCLEAR SAFETY RELATED
AMBER IND. LT.
GREEN IND. LT.
NOTES
CLOSING TORQUE MECH. OVERLOAD
OPENING TORQUE MECH. OVERLOAD
Florida Power
INTERIM DRAWING
ASSIGNED TO M.A.R./F.C.O.
ORIGINAL DRAWING AFFECTED:
DRAWING NO. B-208-041
INTERIM REV. NO. A
DRAWN BY RLK
CHECKED BY
APPRVD. BY
ISSUE DATE
PRC APERTURE CARD
MECH. INTERLOCK
MOTOR SPACE HEATER VALVE
LIMIT SW COMPT. SPACE HEATER VALVE
GE TYPE CR104
GE TYPE CR2940
MU-16
PRELIMINARY PRINT
CONSTRUCTION
BIDDING PURPOSES ONLY
RELEASED FOR
DATE
ENGR.
FLORIDA POWER CORPORATION
ELEMENTARY DIAGRAM
M.U. ISO. VV. TO REAC. INLET LINES LOOP A
(MUV-27) E.S. & SHUTDOWN MCC 3AB
4203
B-208-041

RIDS

9211180343

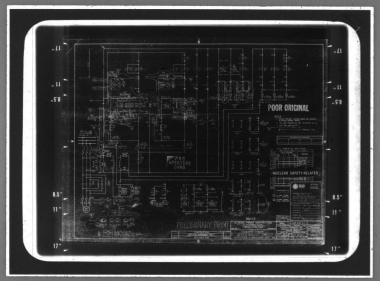

MMM 5824 — FILMSORT® Brand Aperture & Camera Cards and DUPLICARD® Brand Copy Cards — Product of 3M Company, St. Paul, Minn.