


PRELIMINARY PRINT

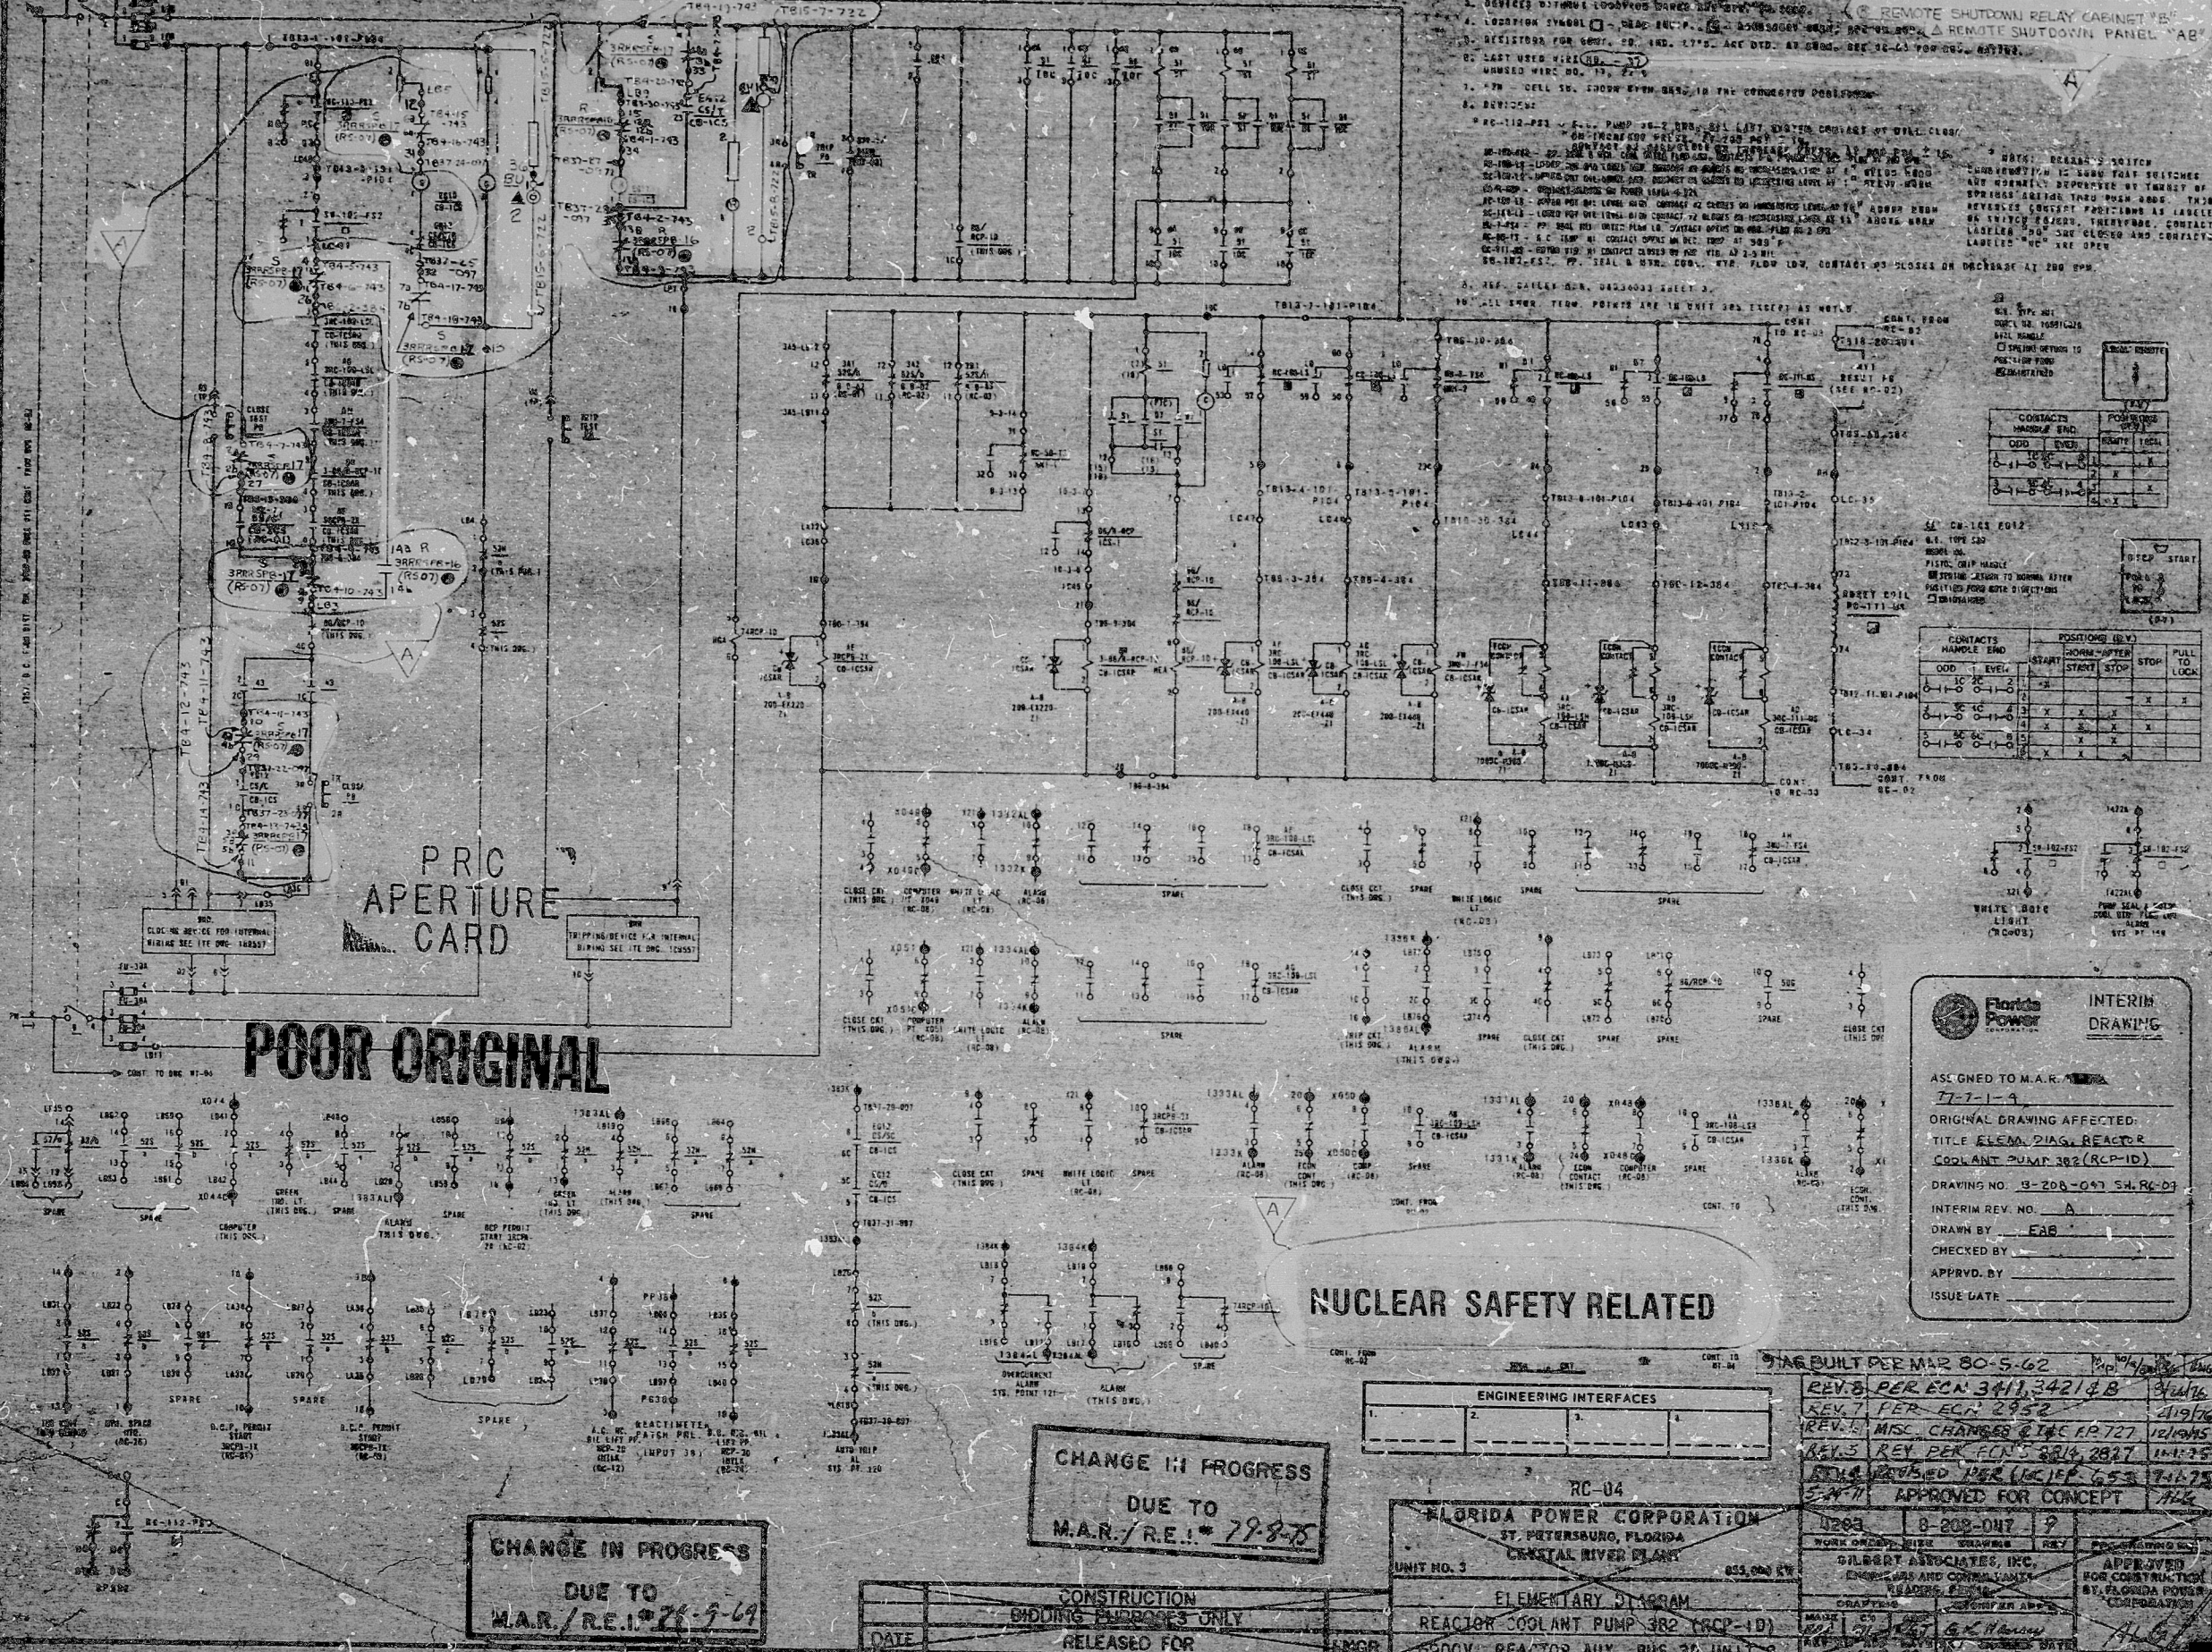

1. REMOTE SHUTDOWN RELAY CABINET 'B'
2. REMOTE SHUTDOWN PANEL 'AB'



FLORIDA POWER CORPORATION
INTERIM DRAWING

ASSIGNED TO M.A.R. 77-1-9

ORIGINAL DRAWING AFFECTED:
TITLE ELEMENTARY DIAGRAM
COOLANT PUMP 302 (RCP-10)

DRAWING NO. B-208-047 54-R-01

INTERIM REV. NO. 1

DRAWN BY: EAB

CHECKED BY:

APPROVED BY:

ISSUE DATE:

NUCLEAR SAFETY RELATED

CHANGE IN PROGRESS
DUE TO
M.A.R./R.E. 77-8-8

CHANGE IN PROGRESS
DUE TO
M.A.R./R.E. 77-9-69

ENGINEERING INTERFACES
1. 2. 3. 4.

RC-04
FLORIDA POWER CORPORATION
ST. PETERSBURG, FLORIDA
CRYSTAL RIVER PLANT

UNIT NO. 3
ELEMENTARY DIAGRAM
REACTOR COOLANT PUMP 302 (RCP-10)
6500V, REACTOR AUX. BUS 30 UNIT 3

REV.	REV. NO.	REV. DATE	REV. BY	REV. FOR

R.D.S

821180397

