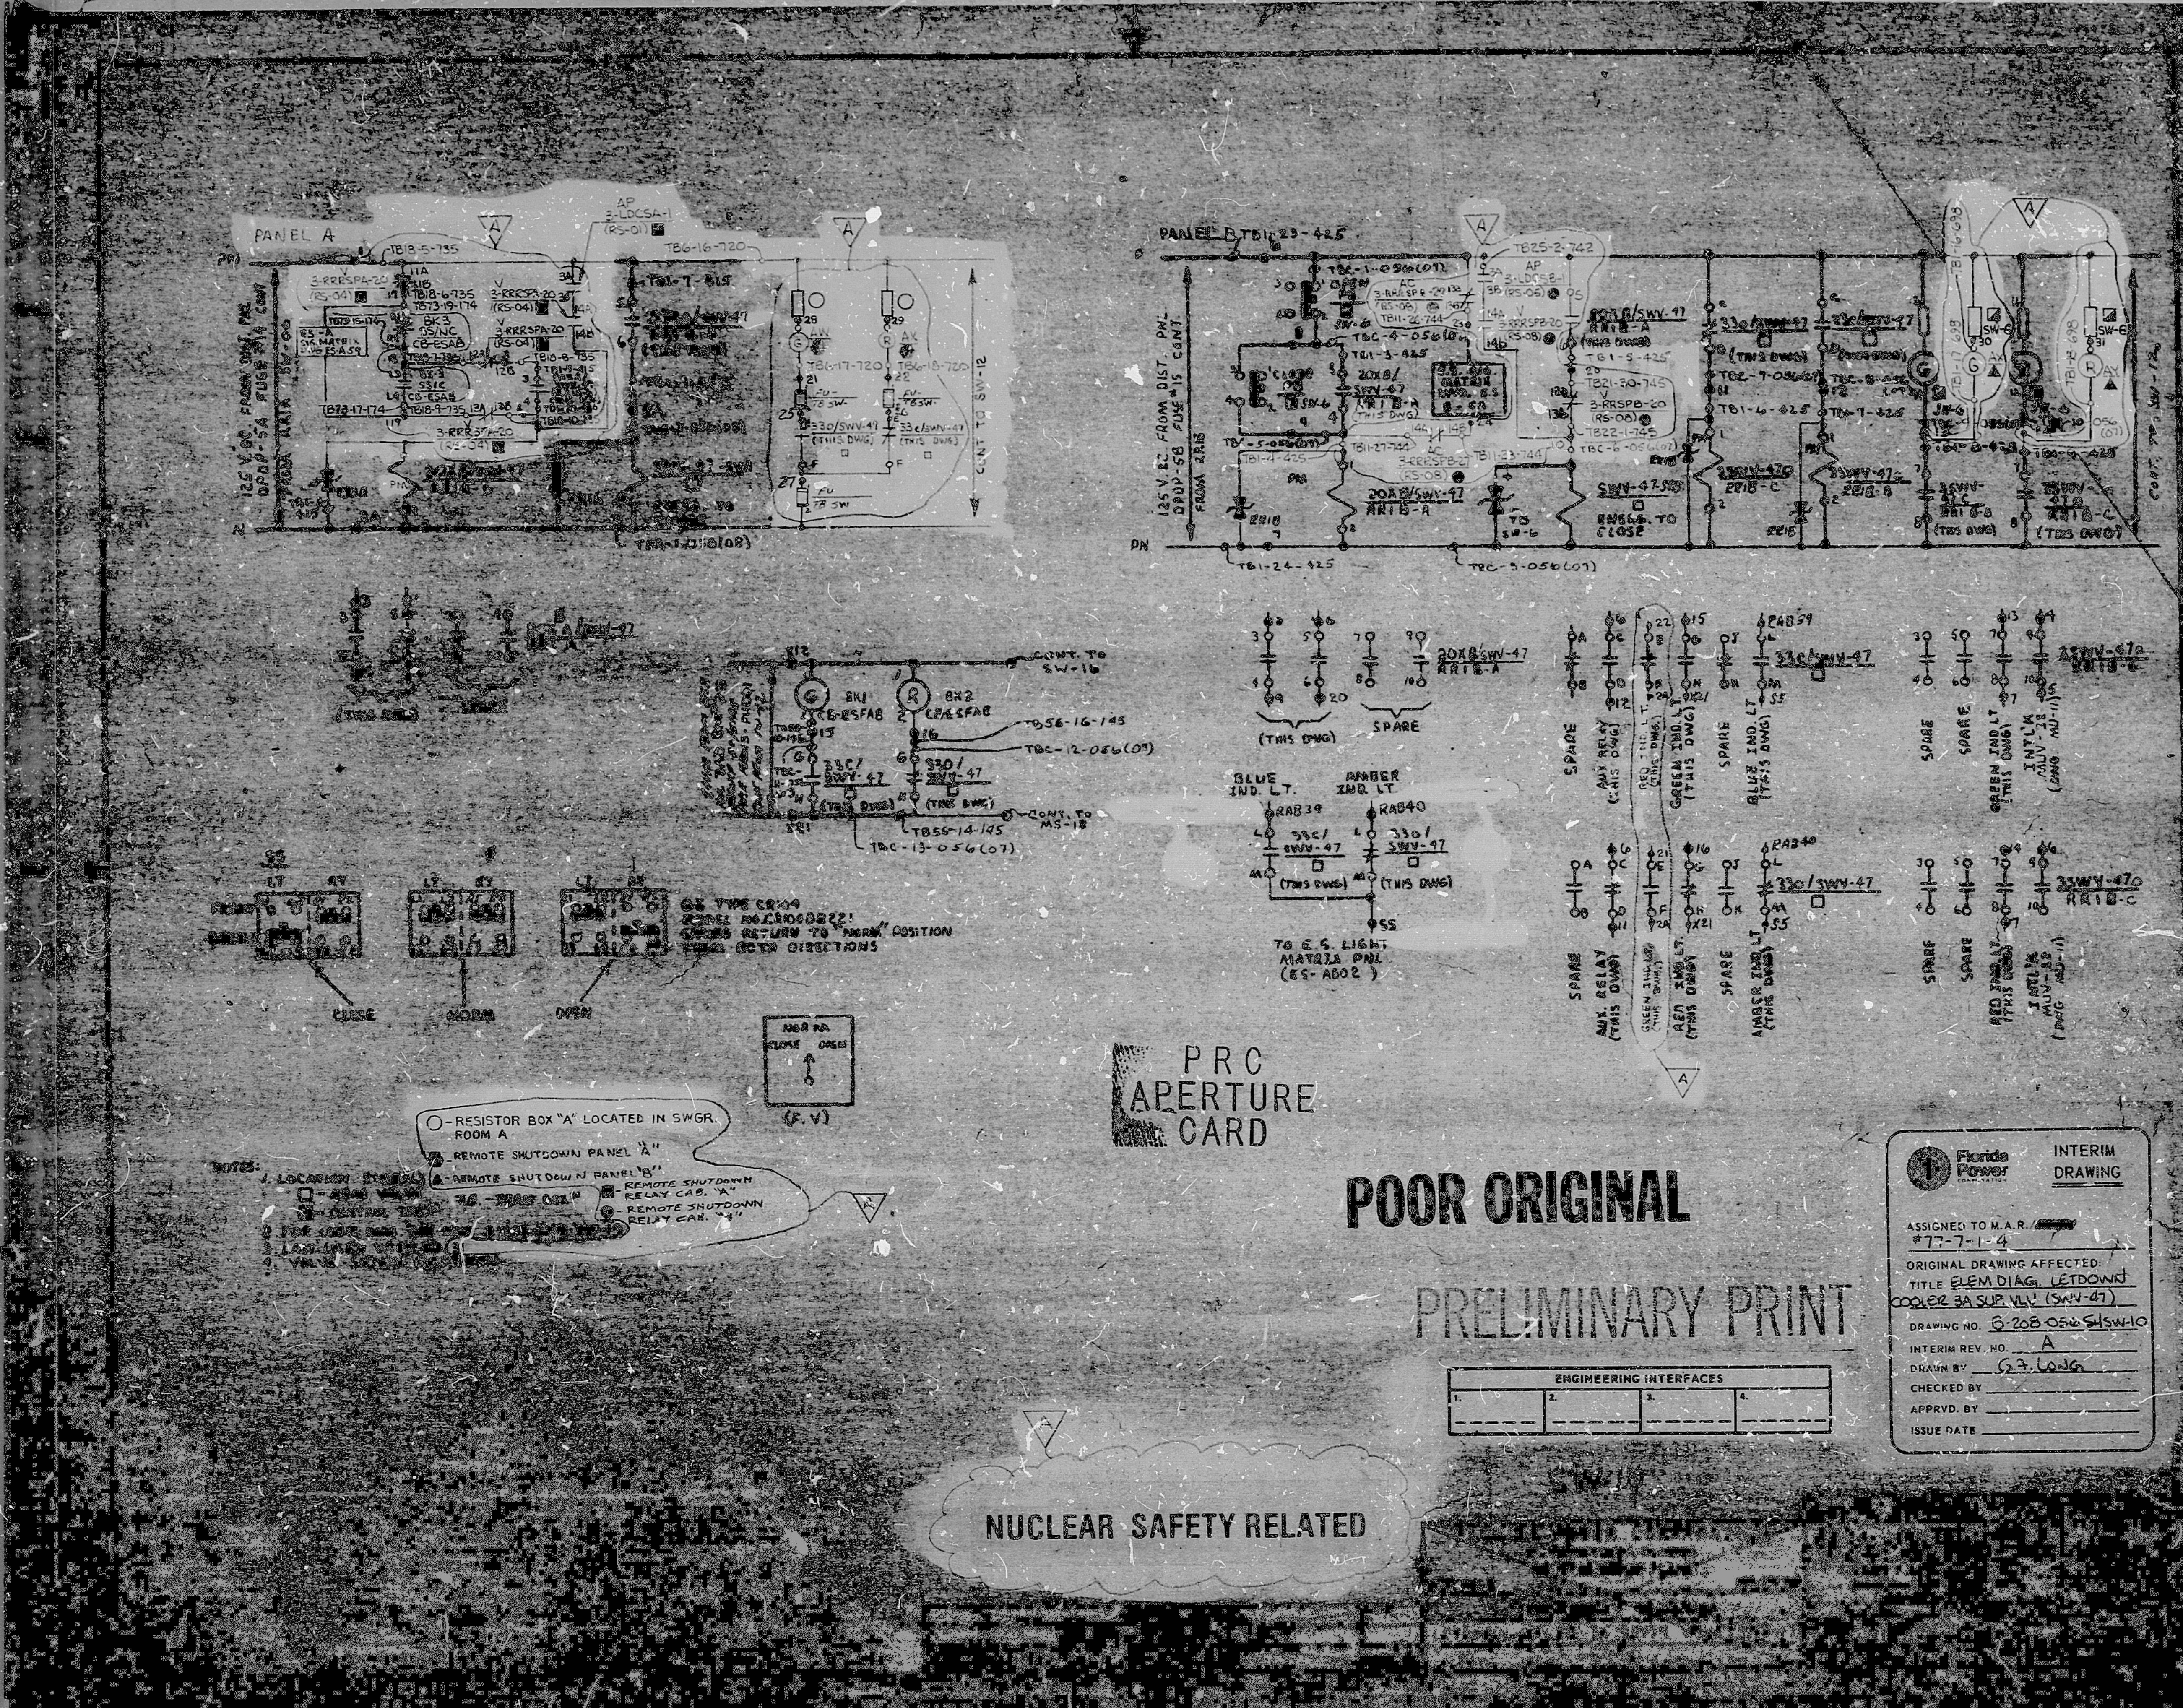

PRC APERTURE CARD

POOR ORIGINAL

PRELIMINARY PRINT

ENGINEERING INTERFACES			
1.	2.	3.	4.

NUCLEAR SAFETY RELATED

Florida Power

INTERIM DRAWING

ASSIGNED TO M.A.R. #77-7-1-4

ORIGINAL DRAWING AFFECTED:

TITLE ELEM DIAG. LETDOWN COOLER 3A SUP. VLV (SWV-47)

DRAWING NO. B-208-056 SHSW-10

INTERIM REV. NO. A

DRAWN BY G.T. LONG

CHECKED BY

APPRVD. BY

ISSUE DATE

RIDS

8211180482

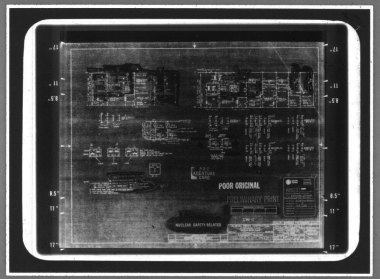

MMM 5824 — FILMSORT® Brand Aperture & Camera Cards and DUPLICARD® Brand Copy Cards — Product of 3M Company, St. Paul, Minn.