


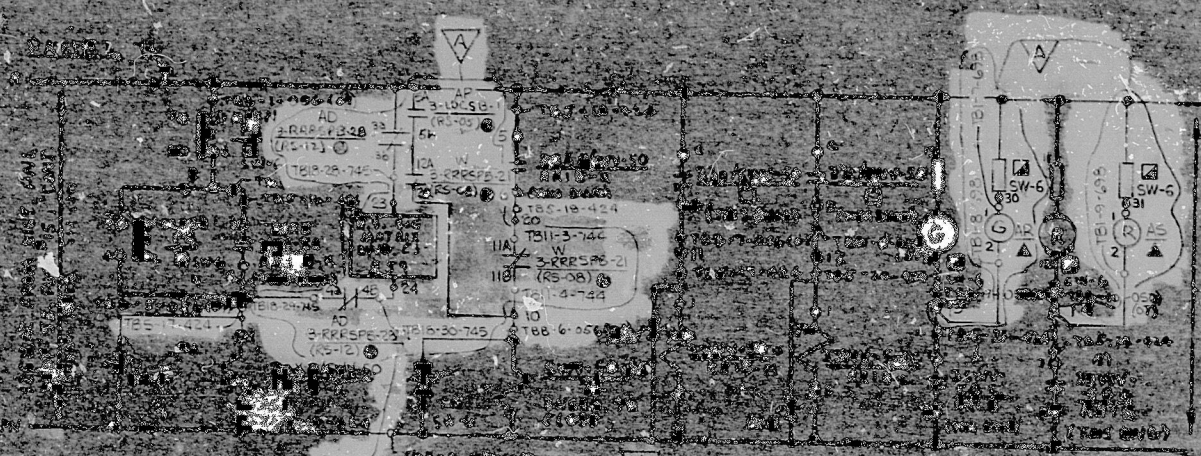

- RESISTOR BOX "A" LOCATED IN SWGR ROOM "A"
- △ REMOTE SHUTDOWN PANEL "A"
- REMOTE SHUTDOWN RELAY CAB "A"
- REMOTE SHUTDOWN RELAY CAB "B"

PRO APERTURE CARD

POOR ORIGINAL  
PRELIMINARY PRINT

|                                |  |
|--------------------------------|--|
| INTERIM DRAWING                |  |
| ASSIGNED TO M.A.R. 1000        |  |
| 877-7-1-4                      |  |
| ORIGINAL DRAWING AFFECTED:     |  |
| TITLE: ELEM DIAG LSTRJWJ       |  |
| POWER: 3A RETURN WLV (SWN-50)  |  |
| DRAWING NO: B-208-056-24 SW-12 |  |
| REVISION NO: 1                 |  |
| DESIGNED BY: G31/100           |  |
| CHECKED BY:                    |  |
| APPROVED BY:                   |  |

NUCLEAR SAFETY RELATED

|                                        |  |
|----------------------------------------|--|
| SW-12                                  |  |
| NUCLEAR POWER CORPORATION              |  |
| ST. PETE, FLORIDA                      |  |
| CRITICAL SYSTEMS                       |  |
| LET DOWN COOLER 3A RETURN WLV (SWN-50) |  |

RIDS

821180490

