


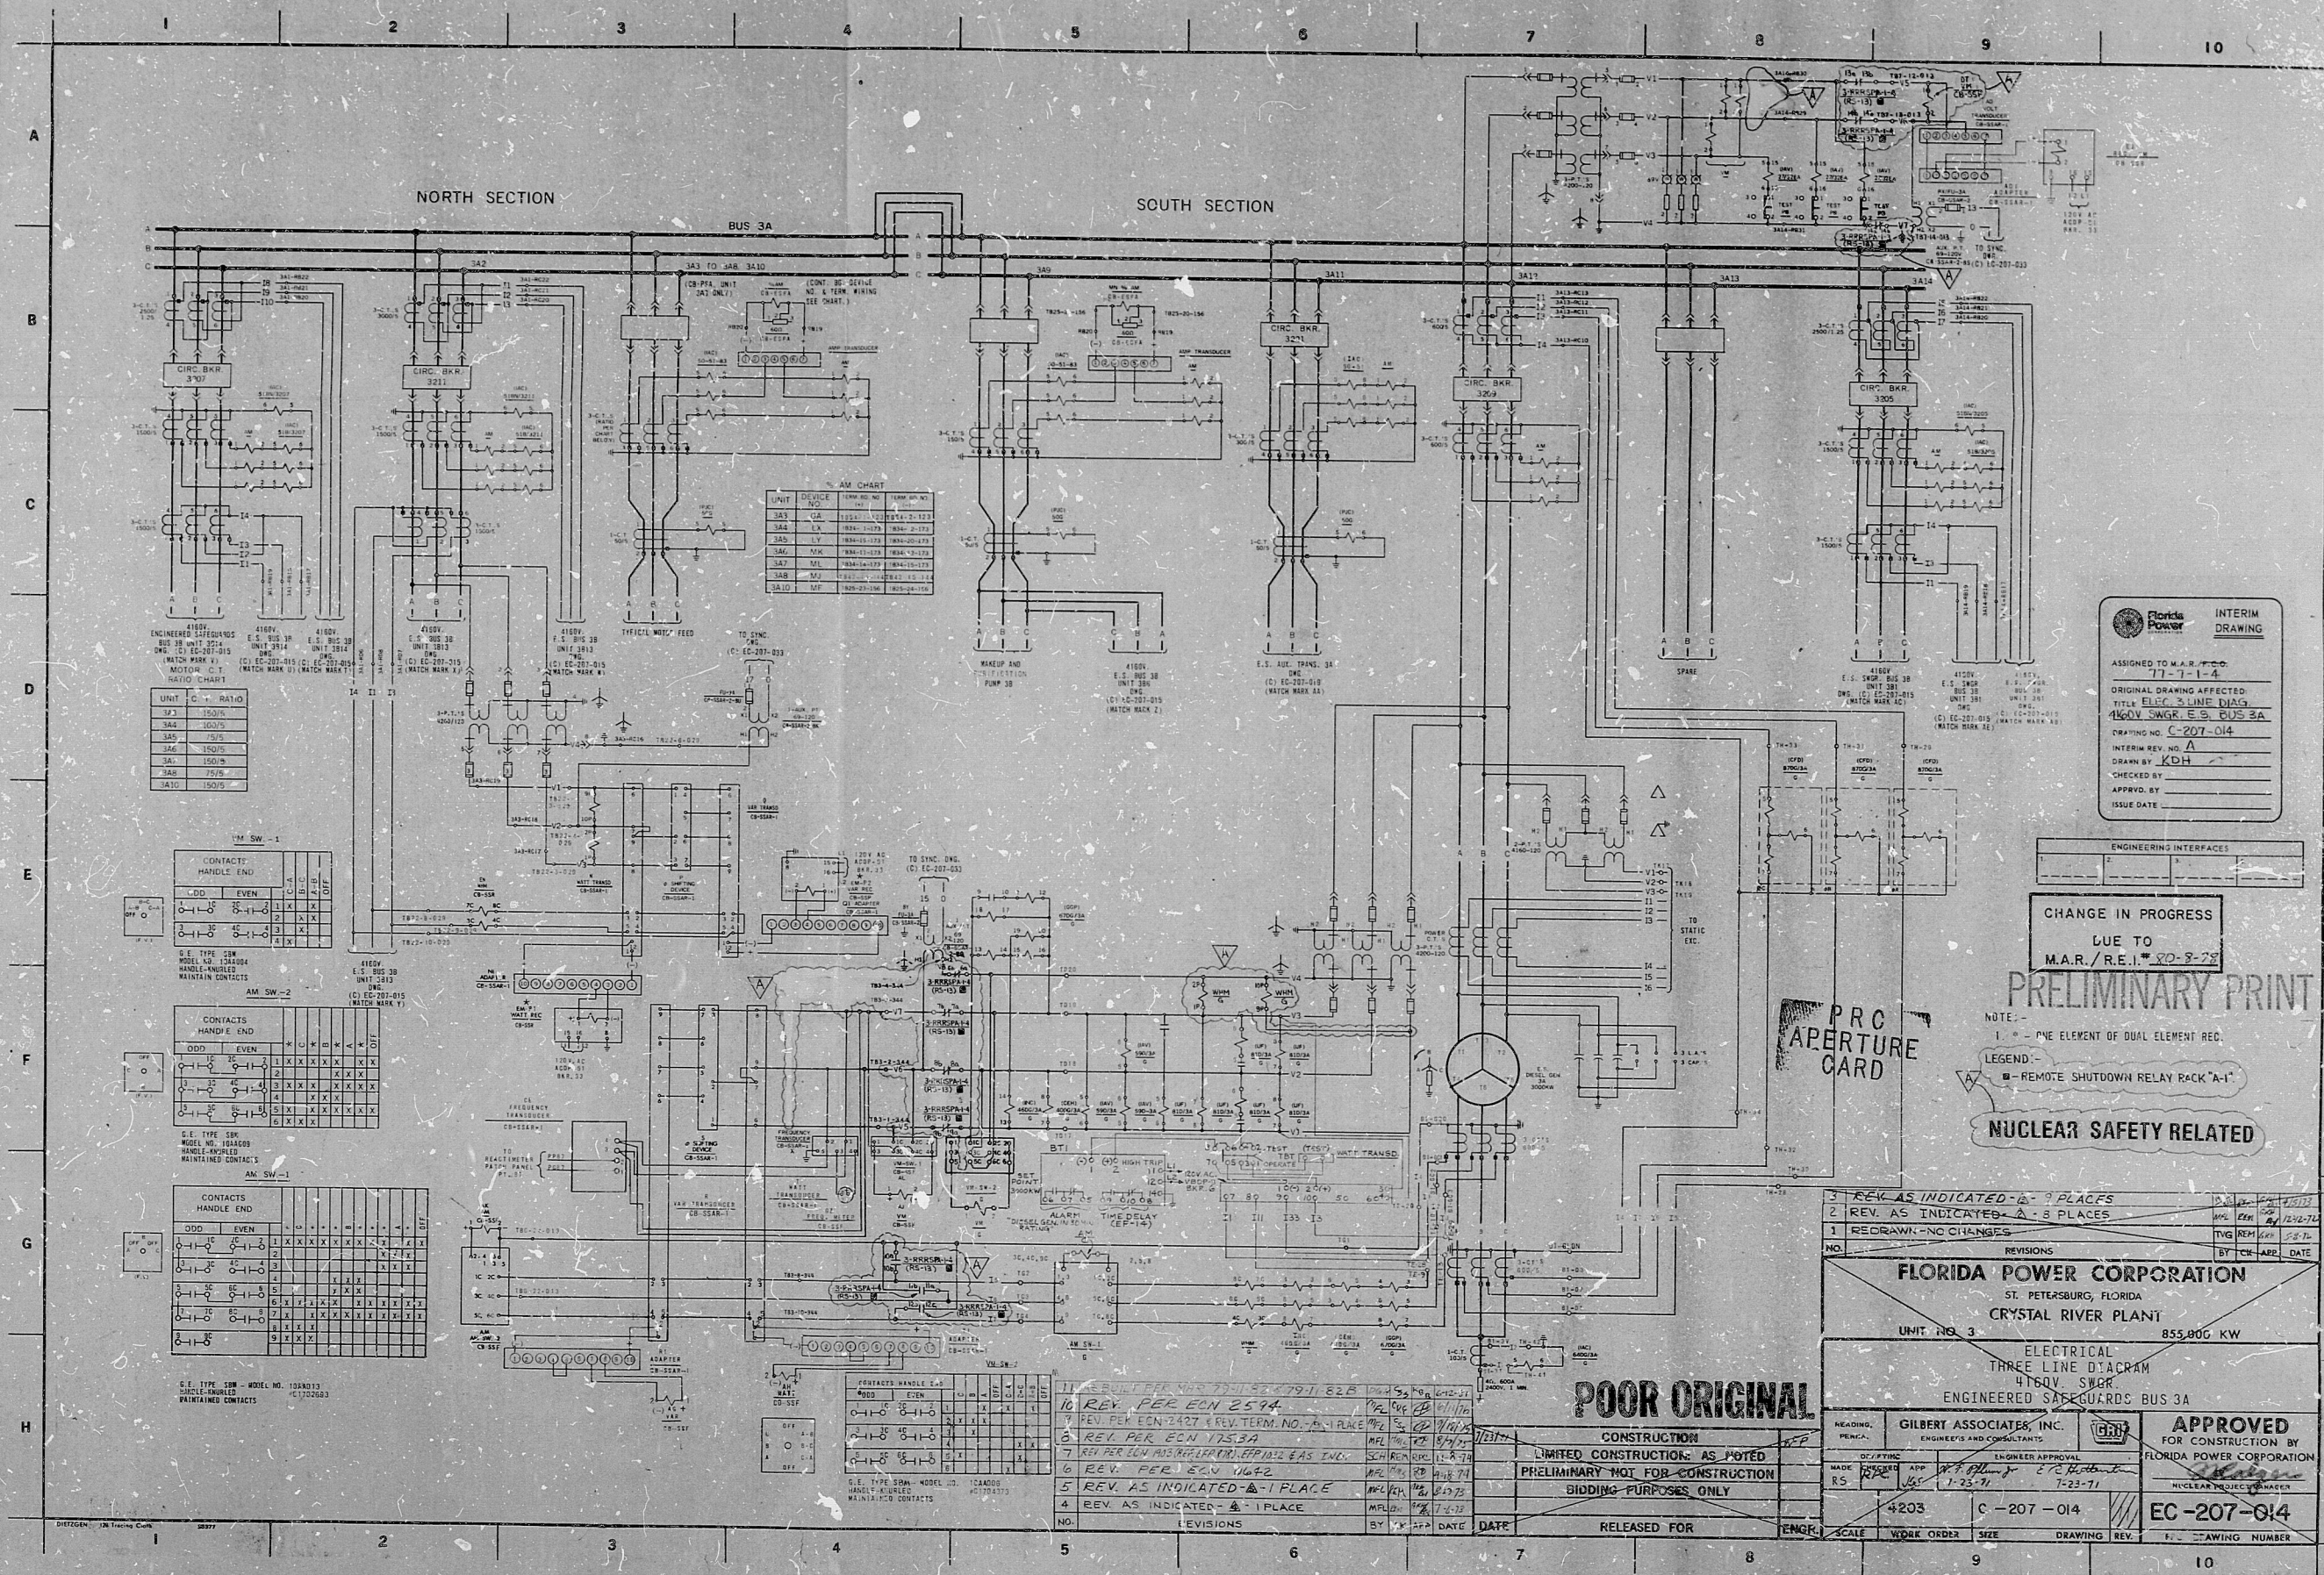

Florida POWER INTERIM DRAWING
ASSIGNED TO M.A.R. 77-1-1-4
ORIGINAL DRAWING AFFECTED:
TITLE: ELEC. 3 LINE DIAG.
4160V SWGR. E.S. BUS 3A
DRAWING NO. C-207-014
INTERIM REV. NO. A
DRAWN BY: KDH
CHECKED BY:
APPROVED BY:
ISSUE DATE:

CHANGE IN PROGRESS
DUE TO
M.A.R./R.E.I. 77-2-2-2

PRELIMINARY PRINT

NOTE: 1" = ONE ELEMENT OF DUAL ELEMENT REL.

LEGEND: 1" = REMOTE SHUTDOWN RELAY RACK "A-1"

NUCLEAR SAFETY RELATED

REV. AS INDICATED - 6 PLACES
2 REV. AS INDICATED - 3 PLACES
1 REDRAWN - NO CHANGES

FLORIDA POWER CORPORATION
ST. PETERSBURG, FLORIDA
CRYSTAL RIVER PLANT

UNIT NO. 3 855,000 KW
ELECTRICAL
THREE LINE DIAGRAM
4160V SWGR.
ENGINEERED SAFEGUARDS BUS 3A

POOR ORIGINAL

CONSTRUCTION
LIMITED CONSTRUCTION: AS NOTED
PRELIMINARY NOT FOR CONSTRUCTION
BIDDING PURPOSES ONLY

APPROVED FOR CONSTRUCTION BY
FLORIDA POWER CORPORATION
NUCLEAR PROJECT MANAGER

4203 C-207-014 EC-207-014

RIDS

821190306

