


22"  
17"  
11"  
8.5"  
8.5"  
11"  
17"  
22"

22"  
17"  
11"  
8.5"  
8.5"  
11"  
17"  
22"

— Piping to be replaced Unit Cycle outage  
— Piping to be replace the first practical outage

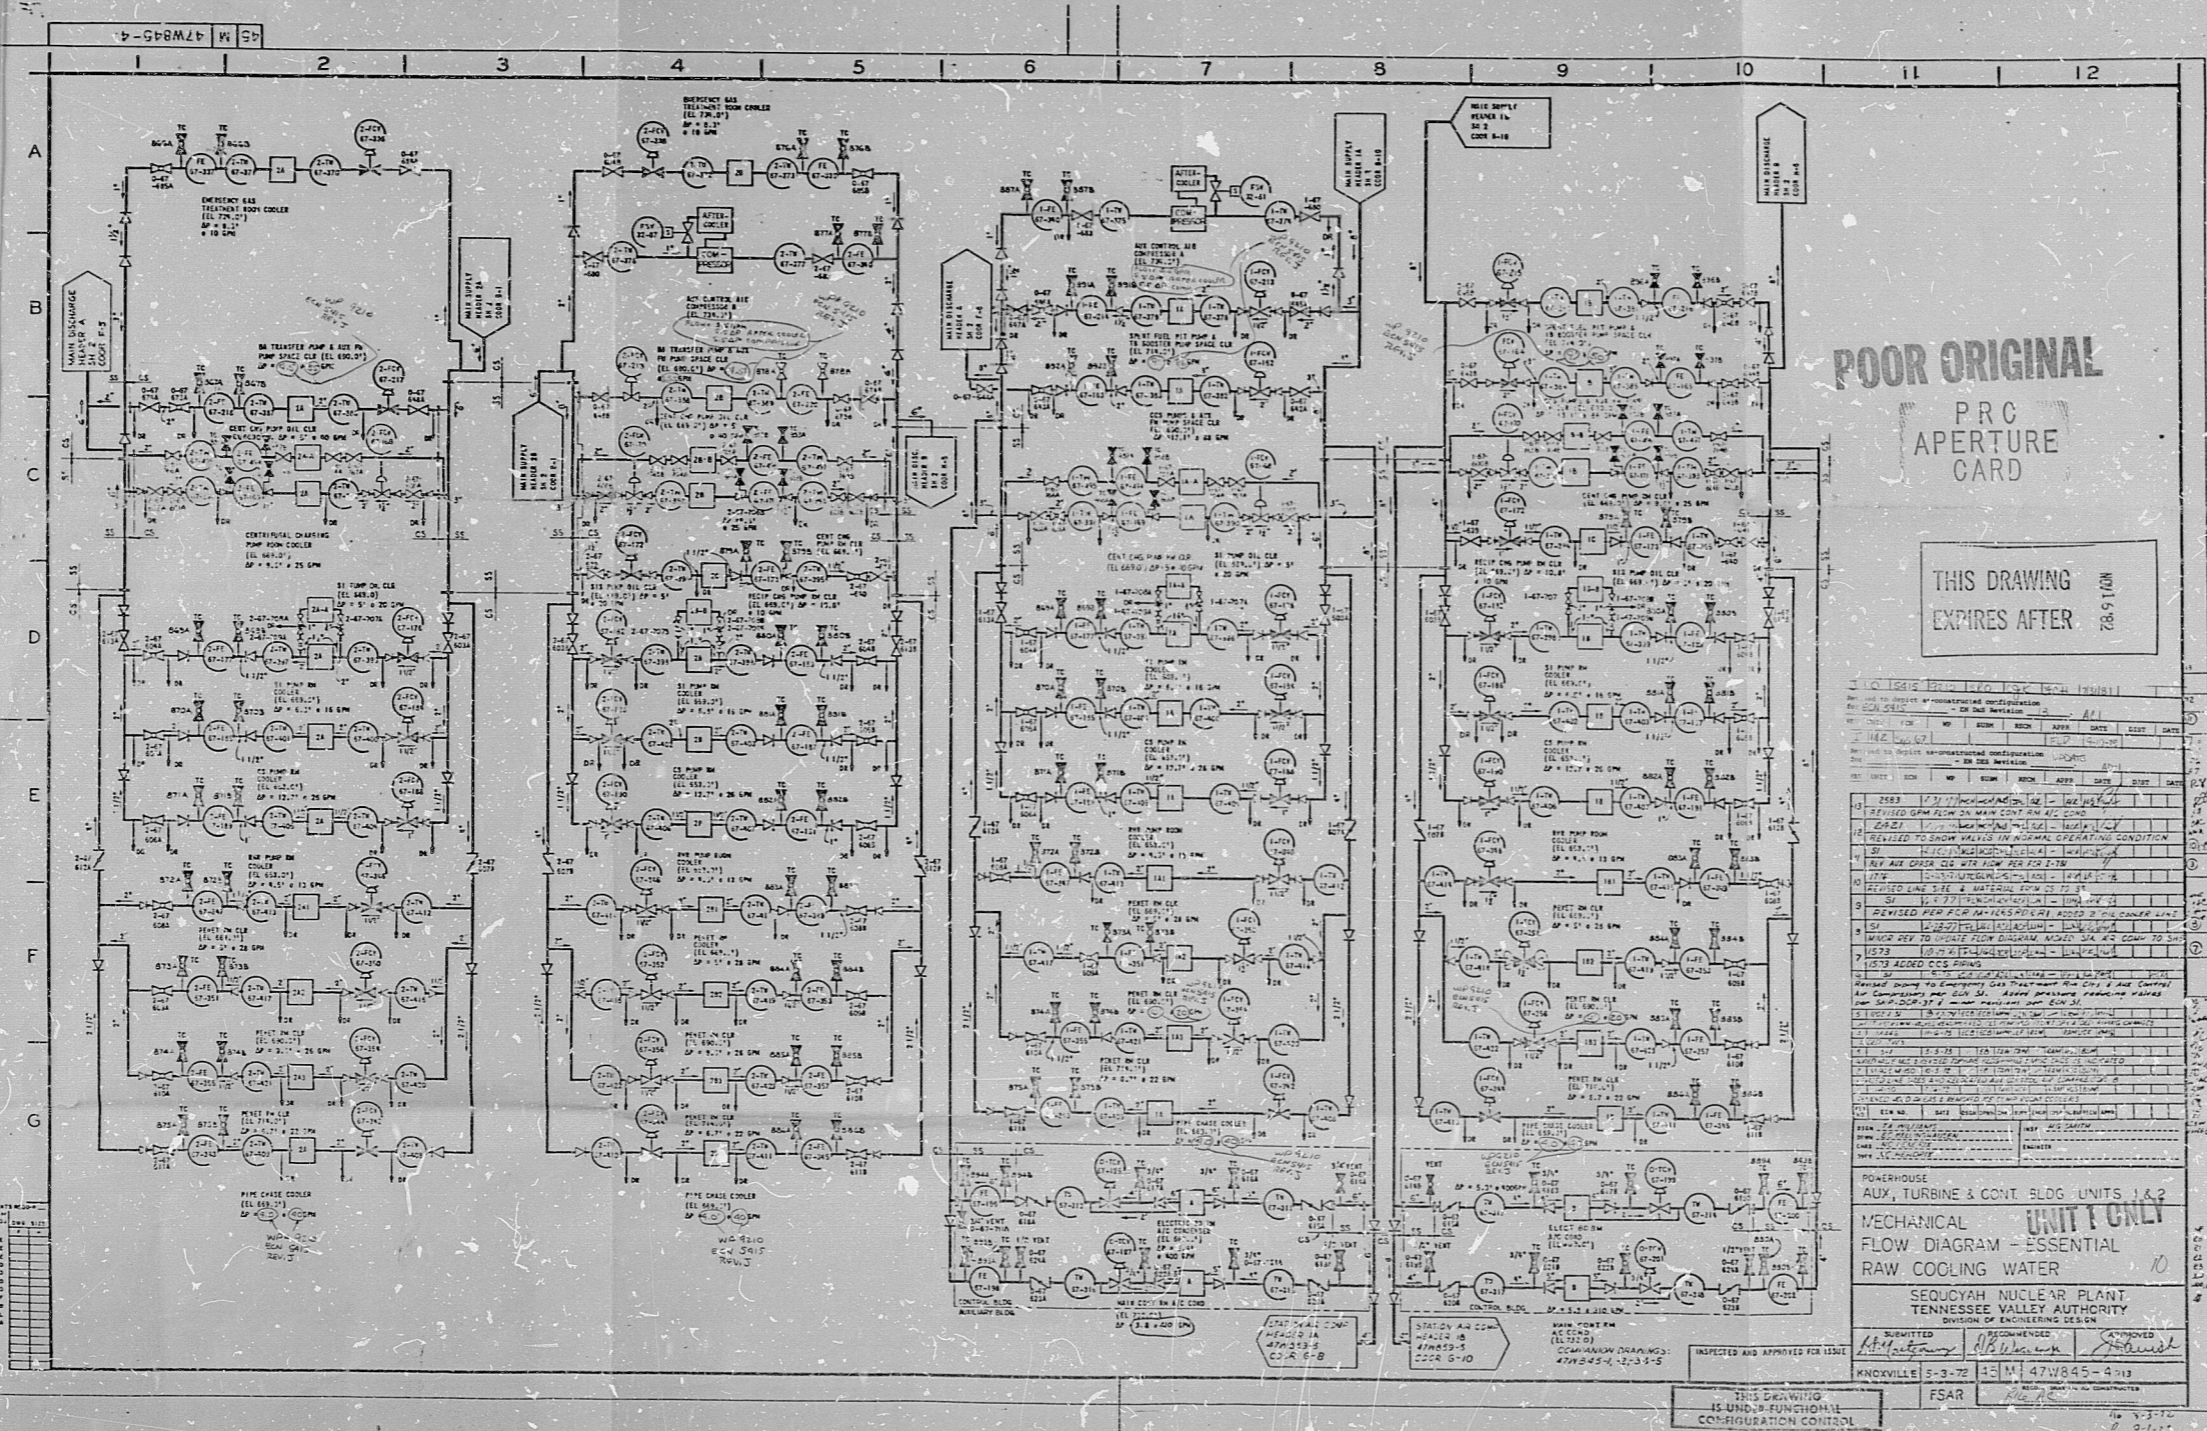

8211230229

Rid's

8211230229

