


11
8.5"
11"
17"

11
8.5"
11"
17"

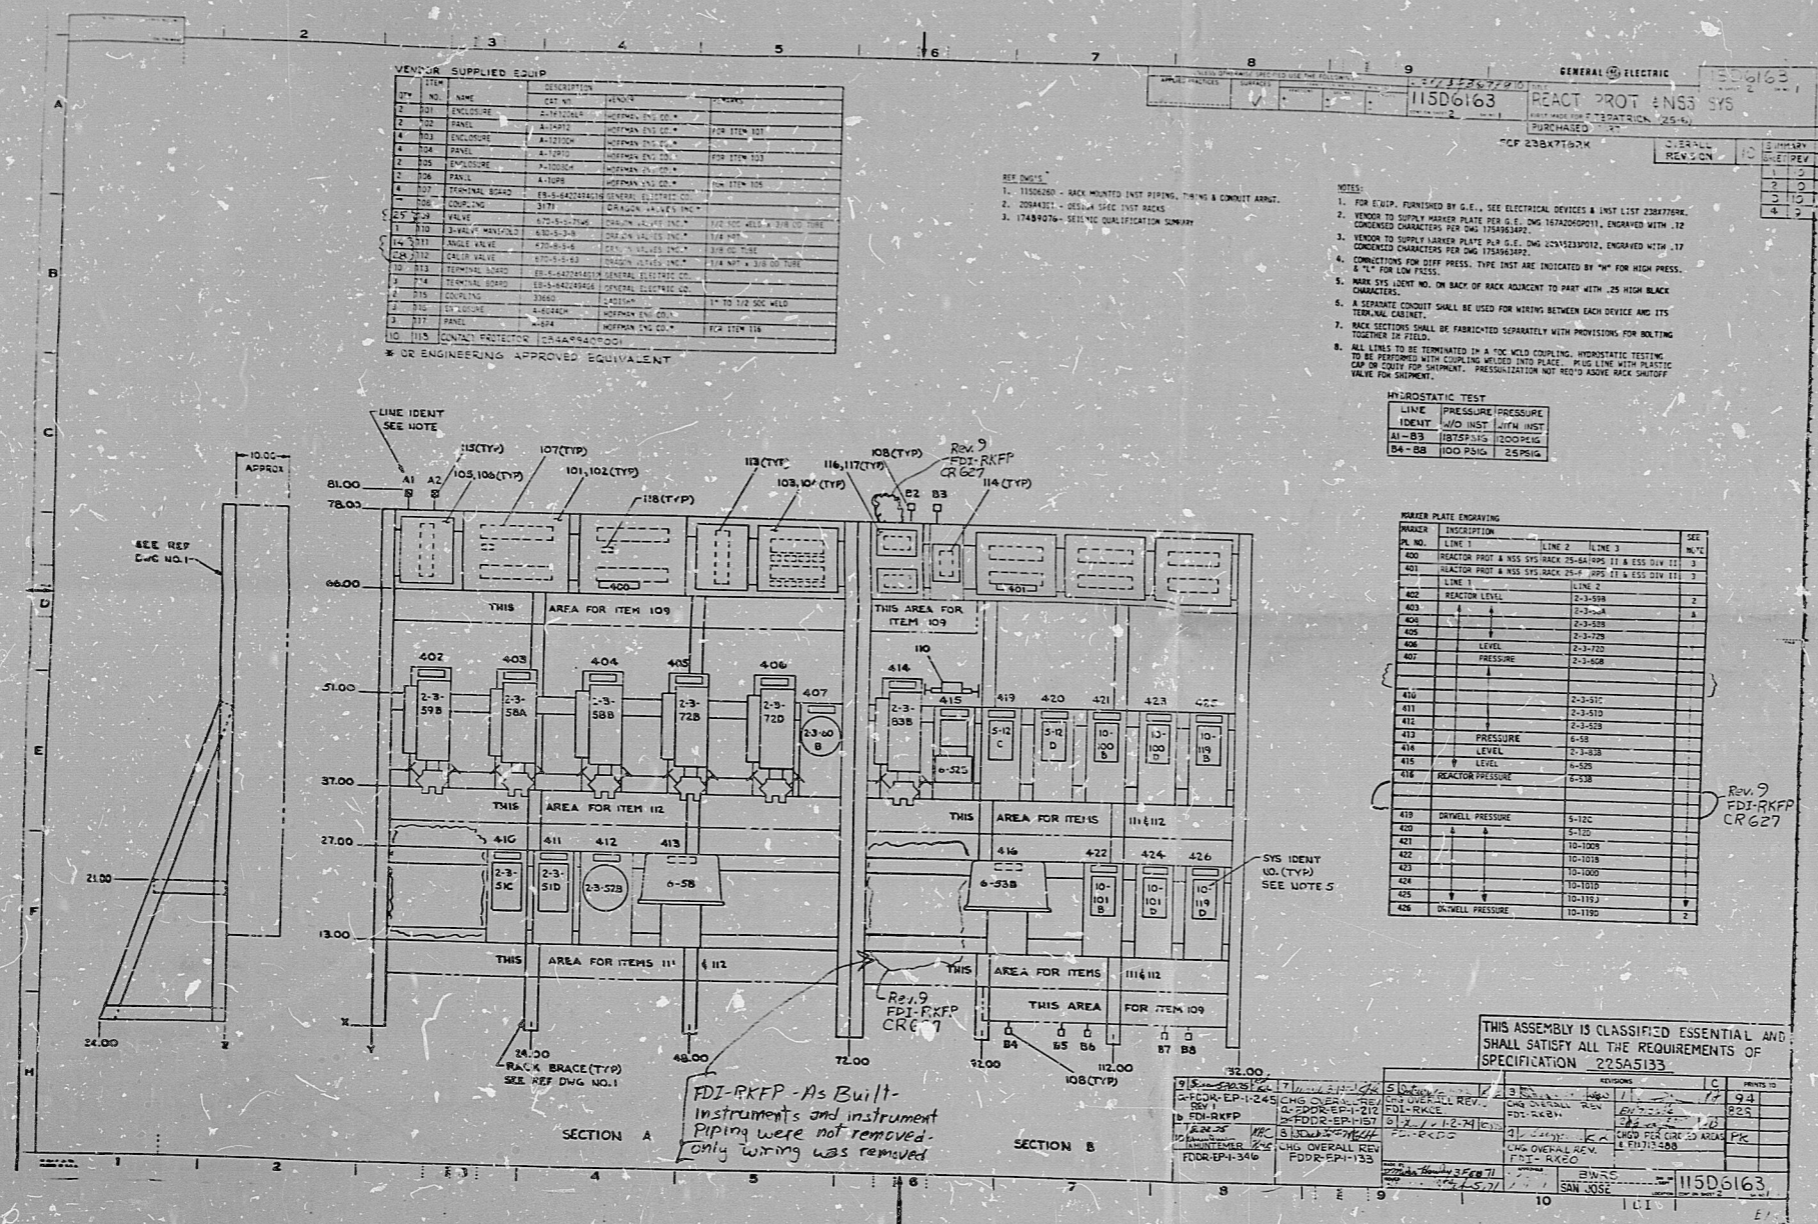

REACTOR VESSEL INST. RACK

JAMES A. FITZPATRICK NUCLEAR POWER PLANT
 POWER AUTHORITY OF THE STATE OF NEW YORK
 File No. 11825-7.70-179 B
 THE INSTRUMENT RACK - Reactor
 Ref. # NSS SYS. MPL # 25-6 Sh. 1
 Vendor - GE
 P. O. No. AP-1
 Project D. E.
 Design Distribution
 Mechanical NOTED OCT 11 1977
 Electrical NOTED OCT 11 1977
 Concrete
 Steel
 Architectural
 Pipe, Service
 Insulation
 Hangers
 Vessels

DRAWING STATUS (✓)
 APPROVED AS DEFINED IN SPECIFICATION
 APPROVED AS REVISED, AS DEFINED IN SPECIFICATION
 FOR INFORMATION ONLY
 RELEASED FOR MATERIAL PURCHASE
 RELEASED FOR FABRICATION
 BYONE & WESTER ENGINEERING CORP.
 DATE 11/17/77 BY JPM/MLC

REVIEW REQUIRED	REVIEWED BY	DATE
R. SPENCE	NOTED JAN 7 1977	
G. LEVIN	NOTED JAN 6 1977	
G. BANKO	NOTED JAN 6 1977	

EXTRA PRINTS REQUESTS
 Design Distribution
 Mechanical
 Electrical
 Concrete
 Steel
 Archt. Structural
 Pipe Service
 Insulation
 Hangers
 Vessels
 NOTED JAN 7 1977

11825-7.70-179B

FOR INFORMATION ONLY

8211240331

PRC APERTURE CARD

POOR ORIGINAL

Rids

8211240331

