
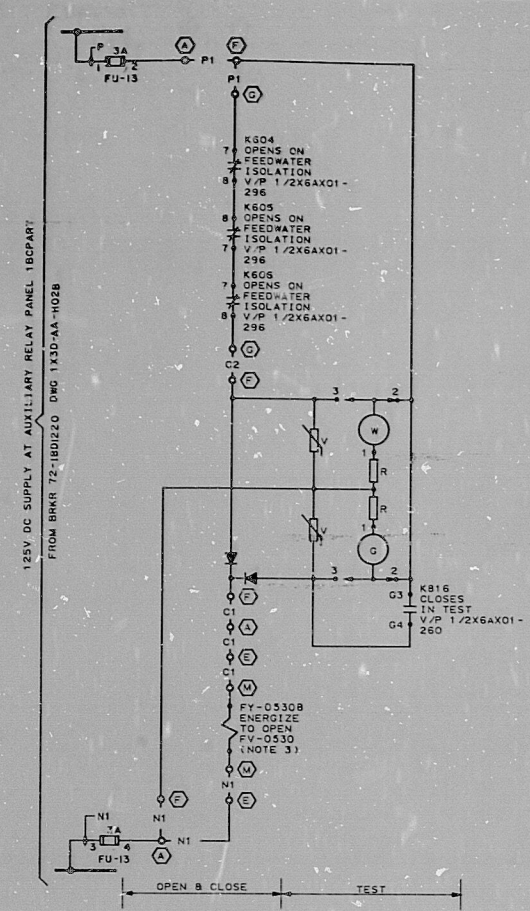



This drawing and the design it covers are the property of BECHTEL. They are loaned to you for your use only and are not to be reproduced, copied, loaned, exhibited, or used except in the limited way and under the conditions specified herein. If they are not to be reproduced, copied, loaned, exhibited, or used except in the limited way and under the conditions specified herein.

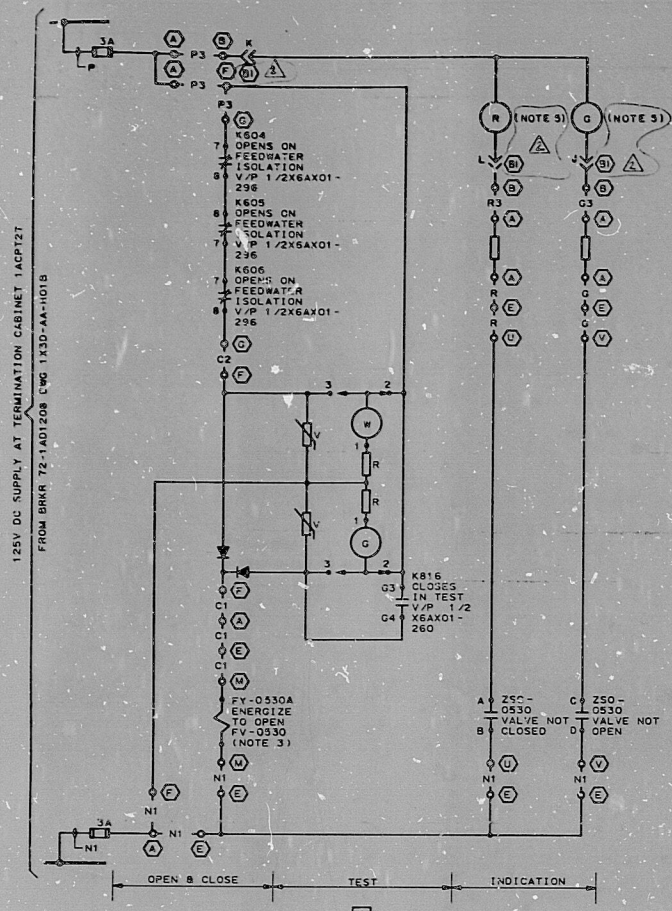

SET	TERMINALS	STEM MOUNTED LIMIT SWITCH DEVELOPMENT	VALVE POSITION	SP
A-B	C-D	OPEN	CLOSED	3P
Z50	C-D	OPEN	CLOSED	3P
Z50	C-D	OPEN	CLOSED	3P
DEVICE	MFR	TYPE	MODEL NO	REFERENCE QWOS	NUMBER	DESCRIPTION	REV
					1X40B16-3	P & I DIAGRAM	
					N/A	ONE LINE DIAGRAM	
					N/A	LOGIC DIAGRAM	
					1/2XBA05-10	BECHTEL V/P	

NO.	REVISIONS	DATE	DR.	CHK.	SUPV.	EQS	CHK.	P.E.	Q.A.E.	NO.	REVISIONS	DATE	DR.	CHK.	SUPV.	EQS	CHK.	P.E.	Q.A.E.	NO.

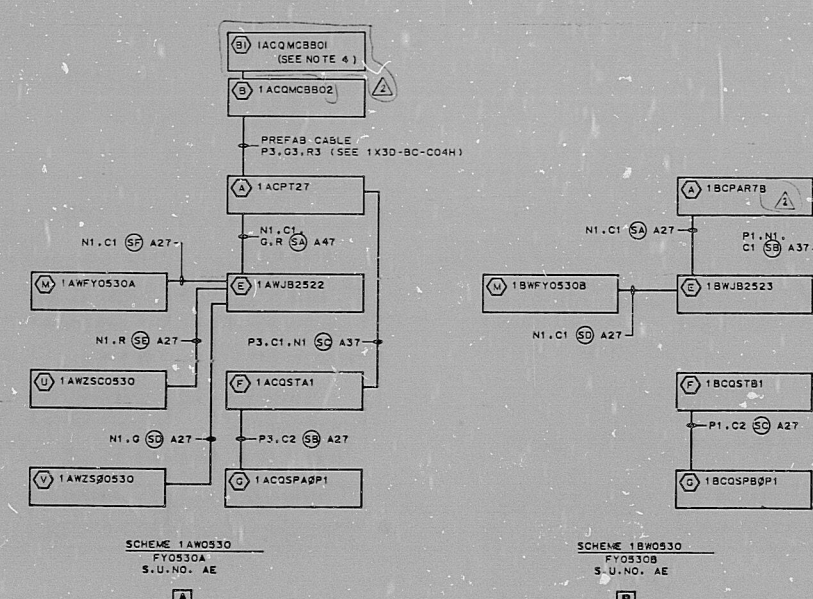

- NOTES:
1. FOR SPECIAL NOTES AND SYMBOLS REFER TO D/L 1X30-AA-AC04A.C.D.F. THRU N.
 2. DENOTES EQUIPMENT LOCATION NUMBER. FOR COMPLETE EQUIPMENT LOCATION NUMBER REFER TO CABLING BLOCK DIAGRAM.
 3. BOTH SOLENOID VALVES FY-0530A & B MUST BE ENERGIZED TO OPEN FY-0530.
 4. LIGHTS ARE LOCATED AT (B). INTERNAL CONNECTION BETWEEN (B) AND (B) IS BY WESTINGHOUSE. THE PREFAB. CABLE CONNECTOR IS LOCATED AT (B).
 5. LIGHTS ARE PART OF ZLB-4.

PRO APERTURE CARD

NUCLEAR SAFETY RELATED [A] [B]

STEAM GEN. LOOP 3 FEEDWATER CONTROL VALVE	
BECHTEL LOS ANGELES	
GEORGIA POWER COMPANY ALVIN W. VOGTLE NUCLEAR PLANT	
ELEMENTARY DIAGRAM CONDENSATE & FEEDWATER SYSTEM FY-0530A & FY-0530B	
SCALE: NONE	DRAWING NO. 1X30-BC-C04F
JOB NO. 910	REV. 2

RIDS,

8309290486

