


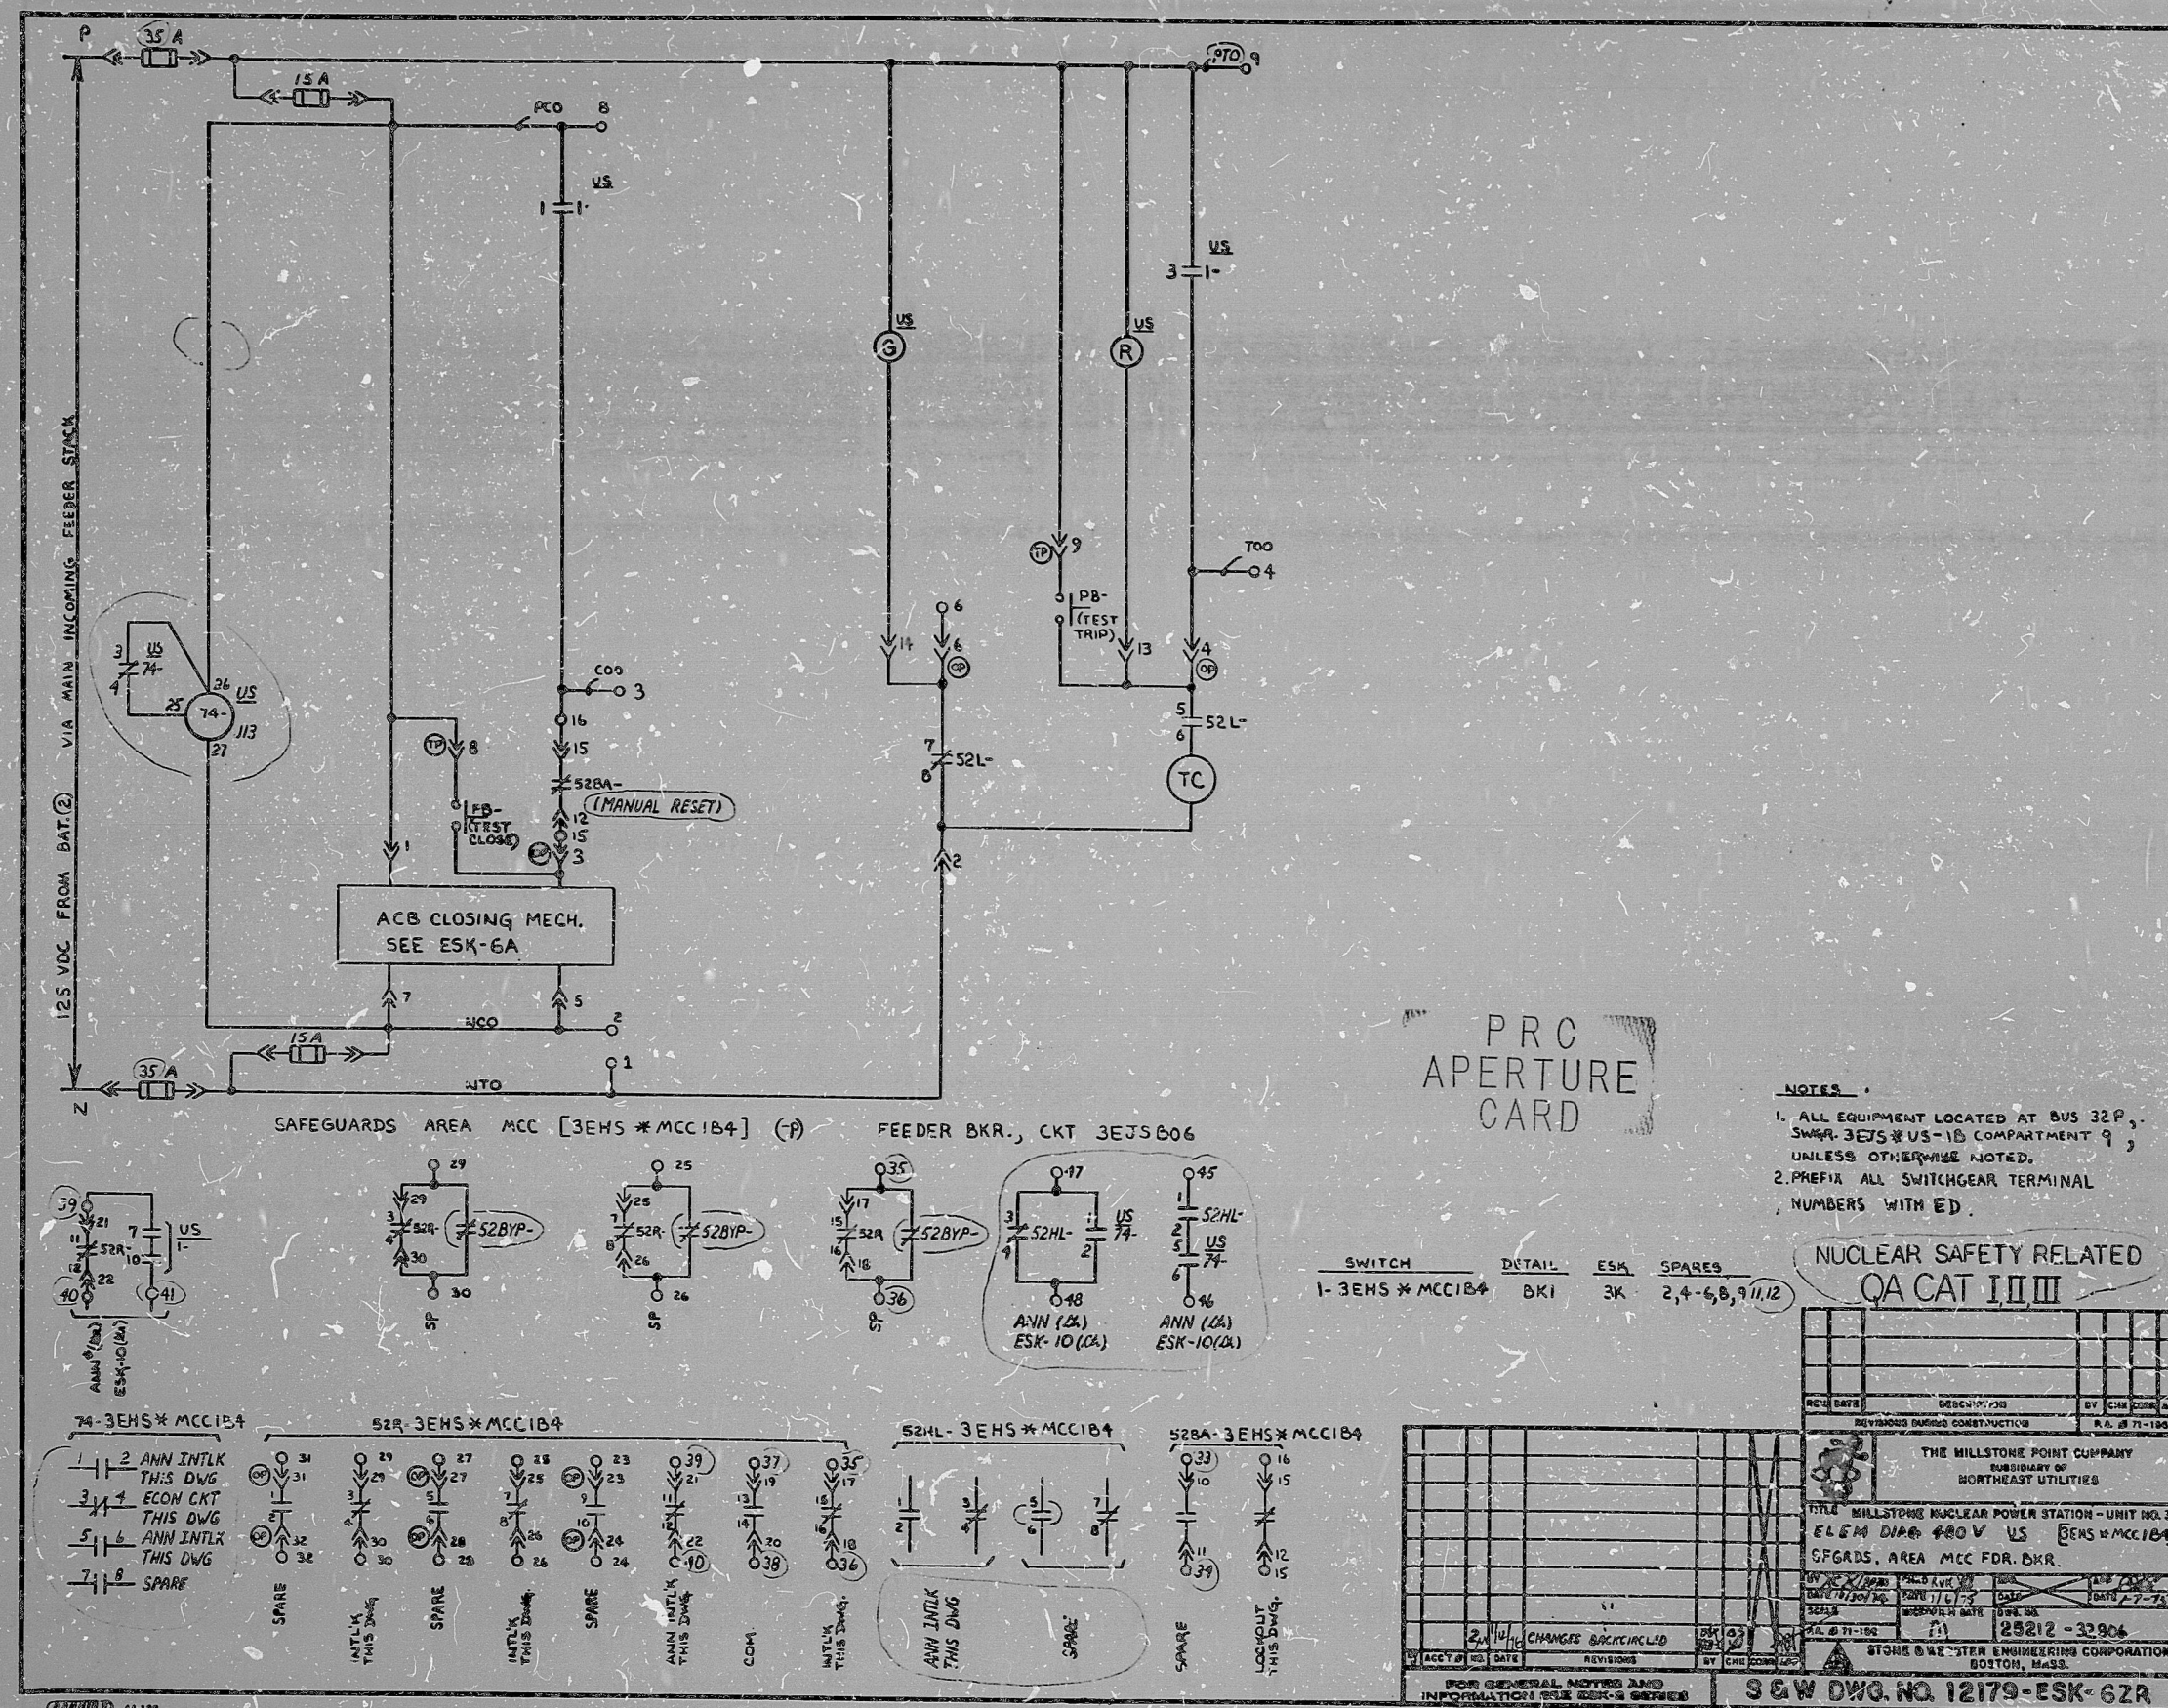

PRC
APERTURE
CARD

NOTES

1. ALL EQUIPMENT LOCATED AT BUS 32P,
SWGR-3ETS & US-18 COMPARTMENT 9,
UNLESS OTHERWISE NOTED.
2. PREFIX ALL SWITCHGEAR TERMINAL
NUMBERS WITH ED.

NUCLEAR SAFETY RELATED
QA CAT III

		THE MILLSTONE POINT COMPANY NORTHAST UTILITIES	
SFGADS, AREA MCC FOR BKR			
W DWG. NO. 12179-ESK-62R			



Rids

8212060432

