




This drawing and the design it contains are the property of BECHTEL. They are hereby loaned to you on the condition that you will not use them in any way without express written permission of BECHTEL.

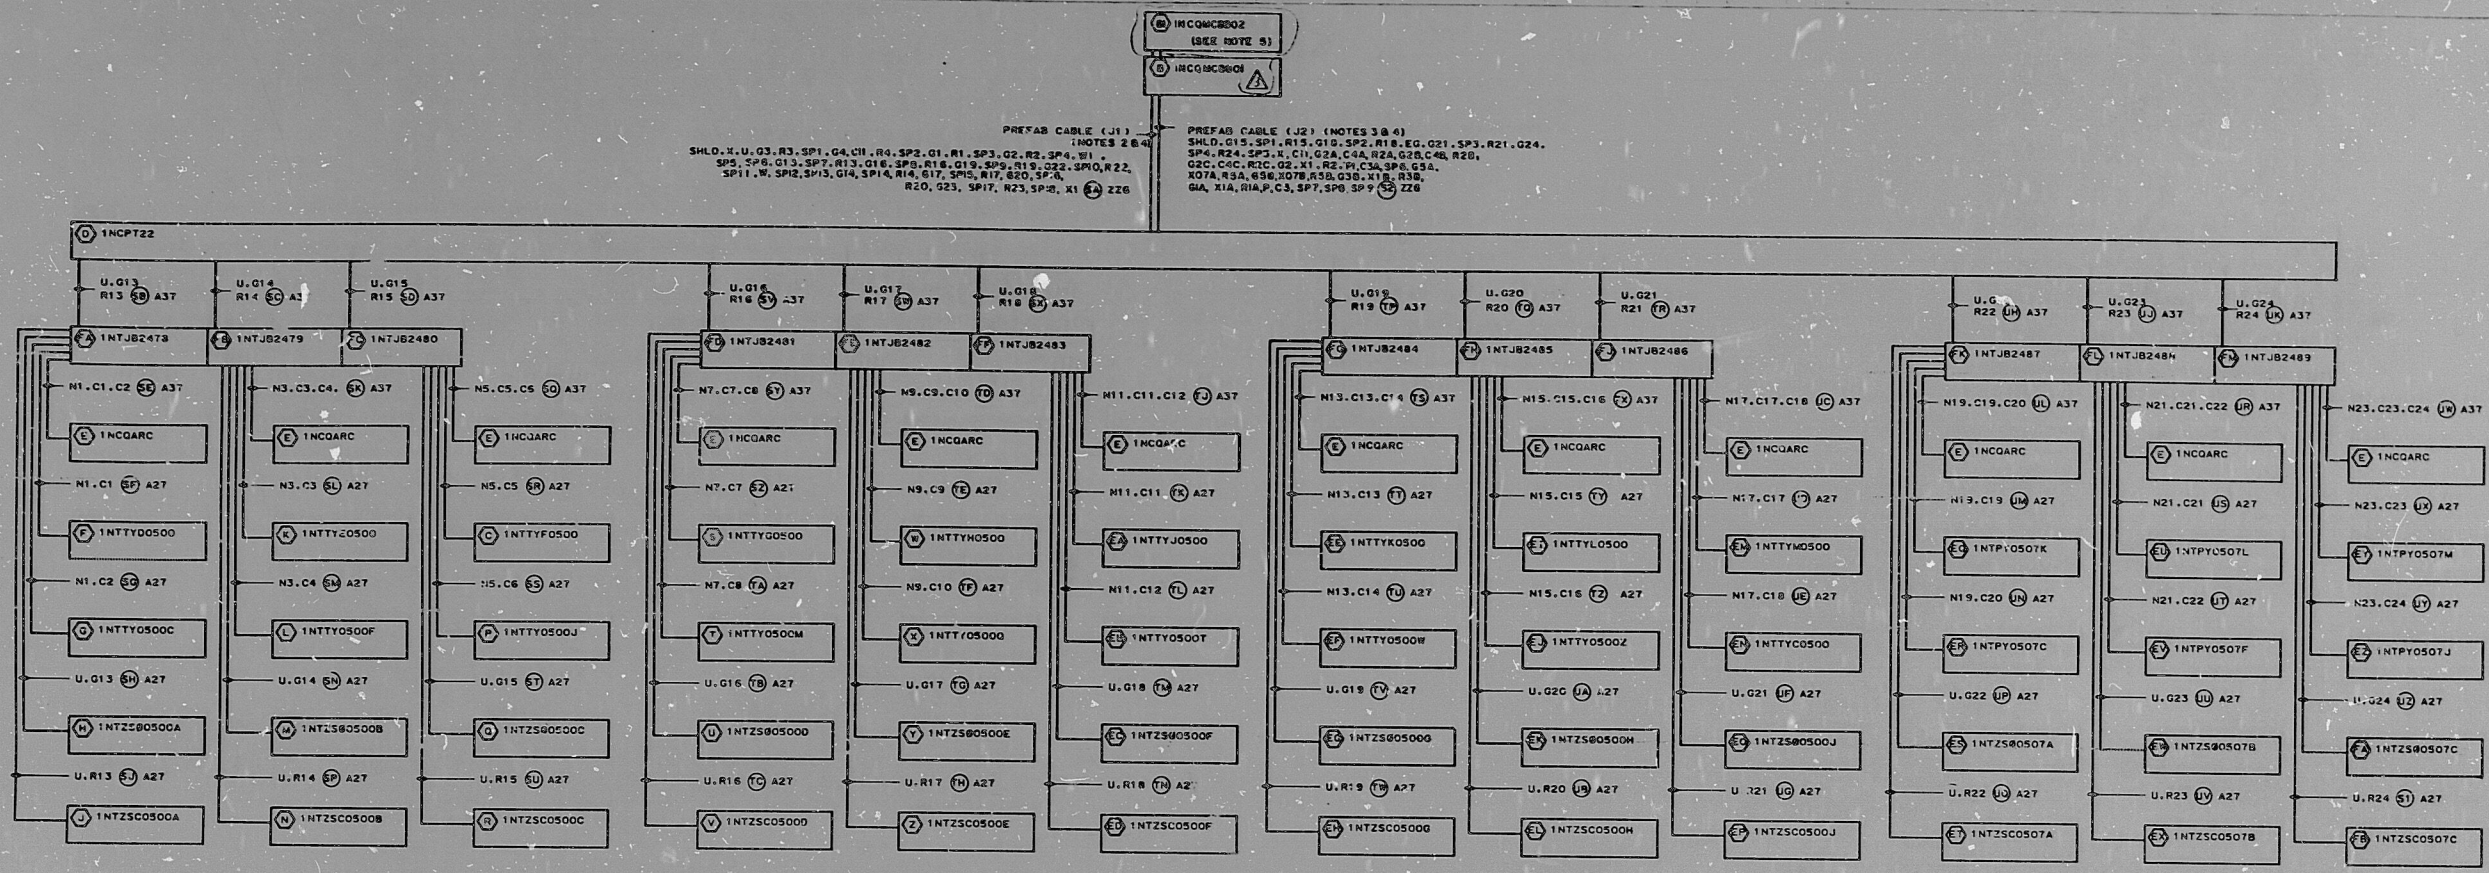

SCHEME 1NJB2480
(SEE NOTES 2 & 3)
S.U. NO. AB

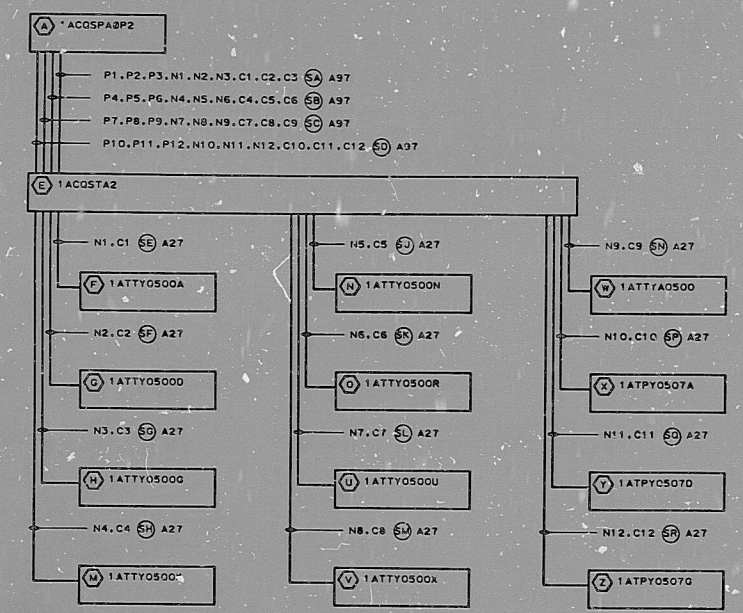

SCHEME 1AT0500
(SEE NOTES 2 & 3)
S.U. NO. AB

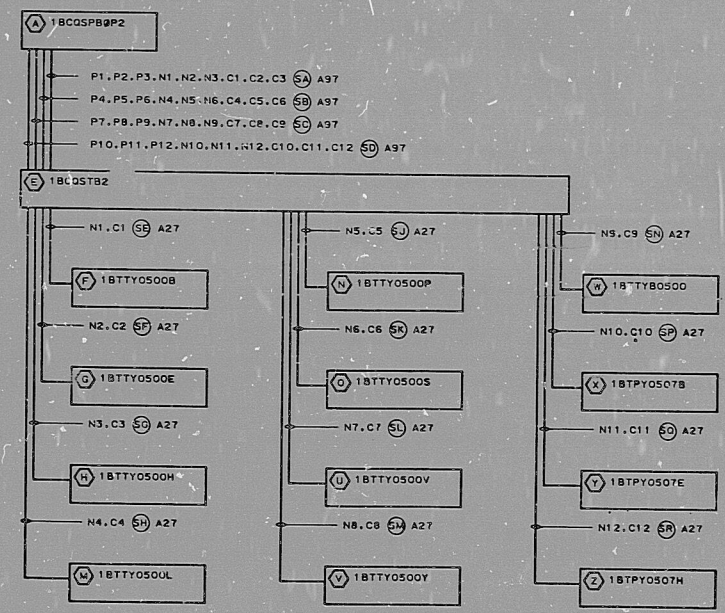

SCHEME 1B0500
(SEE NOTES 2 & 3)
S.U. NO. AB

PRC APERTURE CARD

- NOTES:
1. FOR SPECIAL NOTES AND SYMBOLS REFER TO D.L. 1X30-BA-AD04, C.7.F. THRU N.
 2. FOR ELEMENTARY DIAGRAM REFER TO D.M.G. 1X30-BC-003A, B.D.E.G.H.K.L.P. AND 1X30-BC-003D.
 3. FOR ELEMENTARY DIAGRAM REFER TO D.V.G. 1X30-BC-003C, F.J.W. 1X30-BC-003A, C.18A, C.18B, C.18C, E.O.S.D. E.O.S.G. N.S.O.F. N.S.O.F. Q.S.2N, Q.S.2T
 4. PREFAB CABLES J1 AND J2 ARE FOR LIGHT BOXES ZLB 2.
 5. LIGHTS ARE LOCATED AT (A) INTRINSAL CONNECTION BETWEEN (A) AND (B) IS BY WESTINGHOUSE. THE PREFAB CABLE CONNECTOR IS LOCATED AT (B).

NUCLEAR SAFETY RELATED (A)(B)

BECHTEL LOS ANGELES	
GEORGIA POWER COMPANY ALVIN W. VOGTLE NUCLEAR PLANT	
ELEMENTARY DIAGRAM MAIN STEAM SYSTEM CABLE BLOCK DIAGRAM	
SCALE: NONE	DRAWING NO. 1X30-BC-003M
DATE: 1/1/68	REV: 3

REVISIONS										REVISIONS									
NO.	DATE	DR.	CHK.	SUPV.	EGS	CHK.	P.E.	P.A.E.	NO.	DATE	DR.	CHK.	SUPV.	EGS	CHK.	P.E.	P.A.E.	NO.	DATE
1									1									1	

PROPERTY OF THE BECHTEL COMPANY. THIS DRAWING IS LOANED TO YOU ON THE CONDITION THAT YOU WILL NOT REPRODUCE OR TRANSMIT IN ANY MANNER WITHOUT THE WRITTEN PERMISSION OF BECHTEL.

RIDS

8309290567

