




RIDS

8309290586

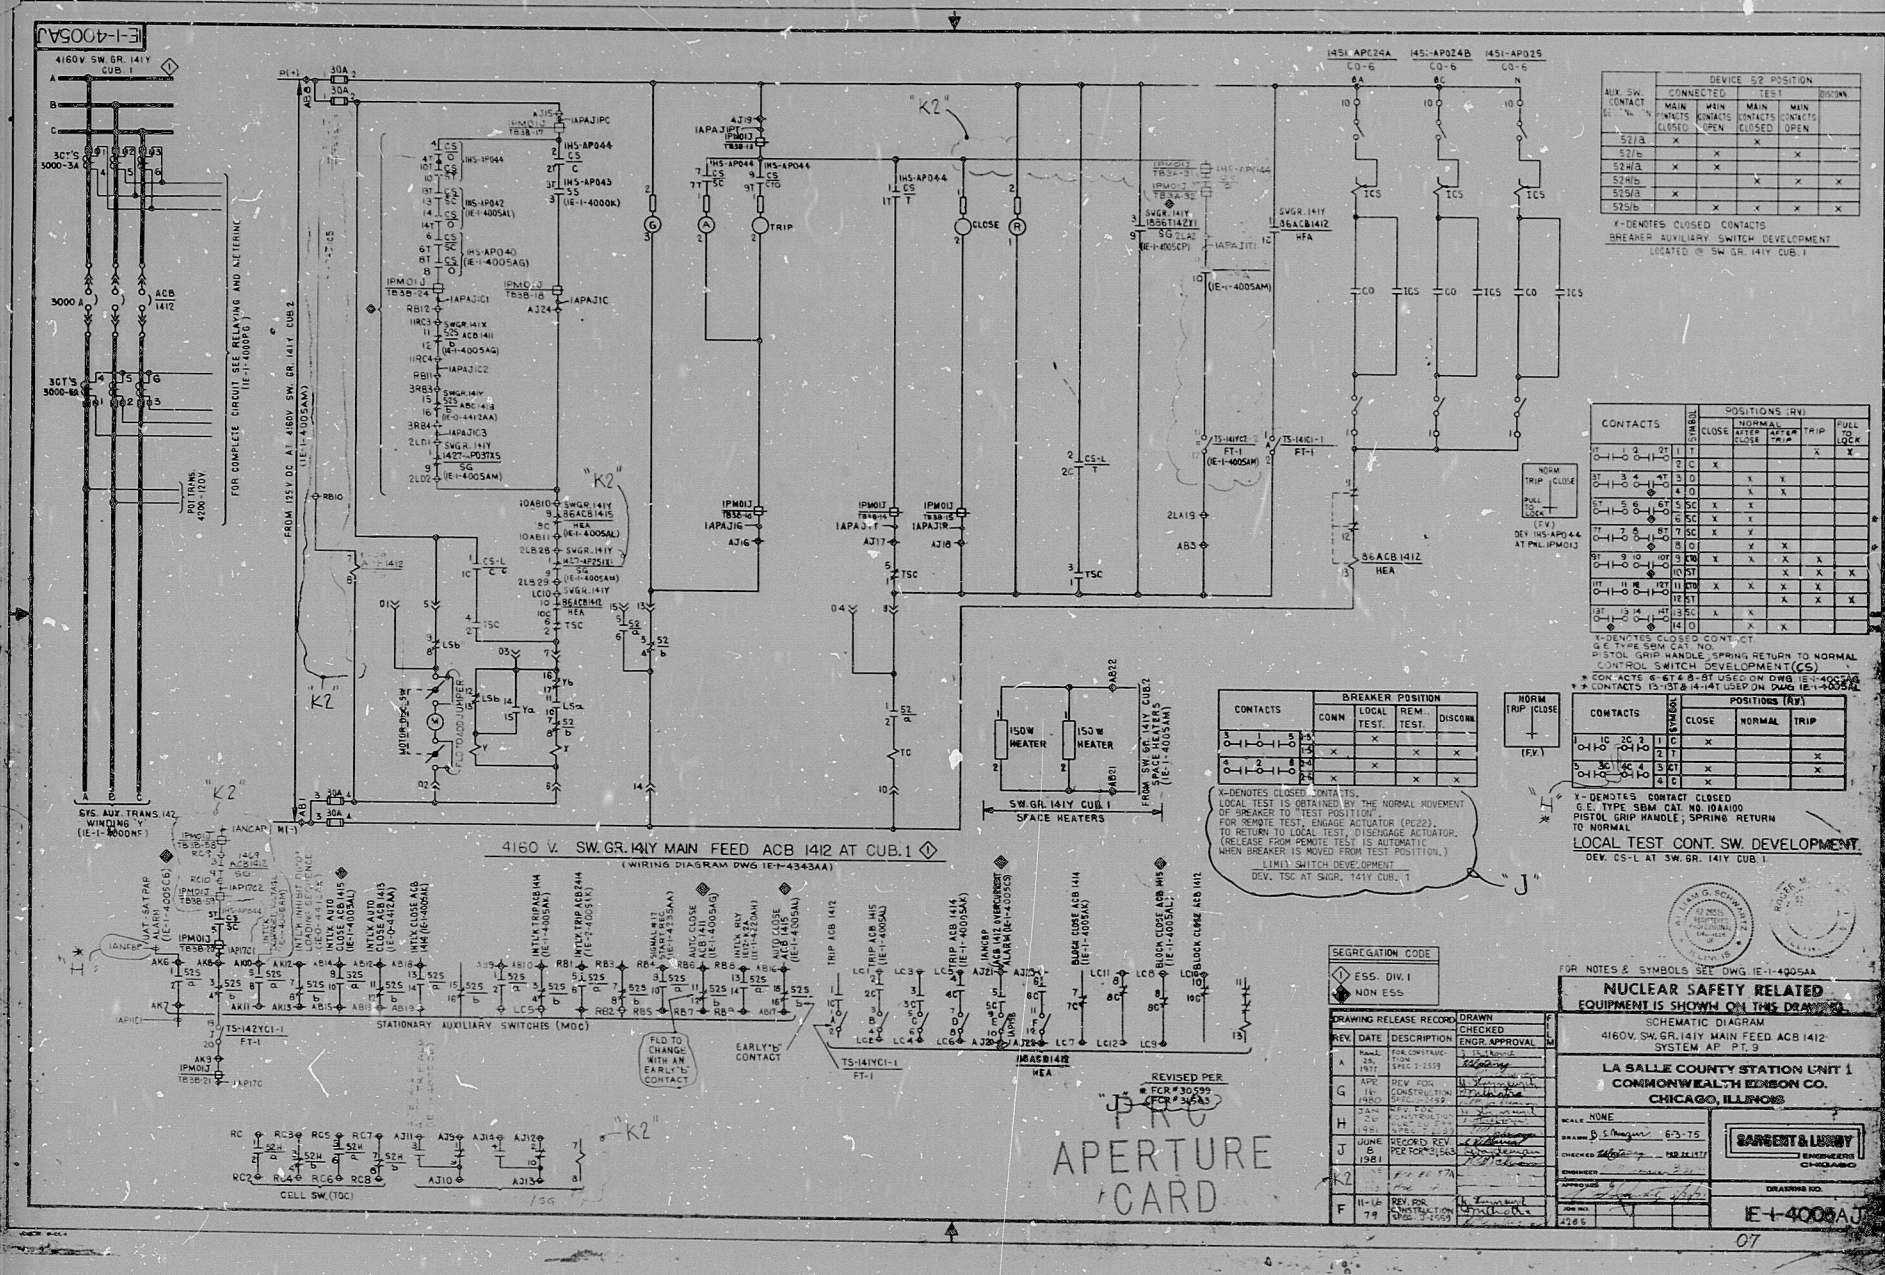