

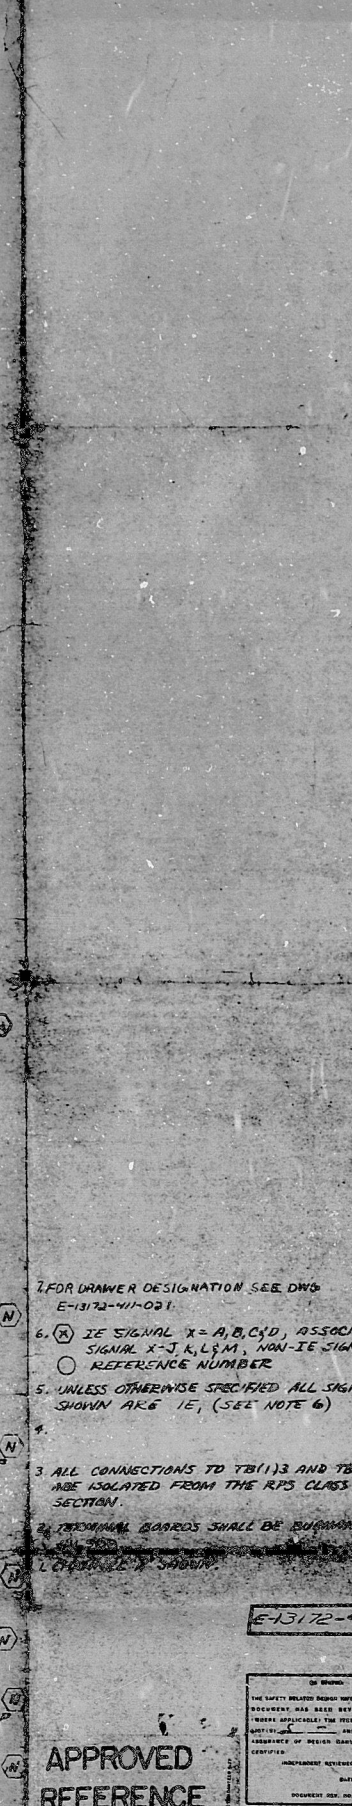
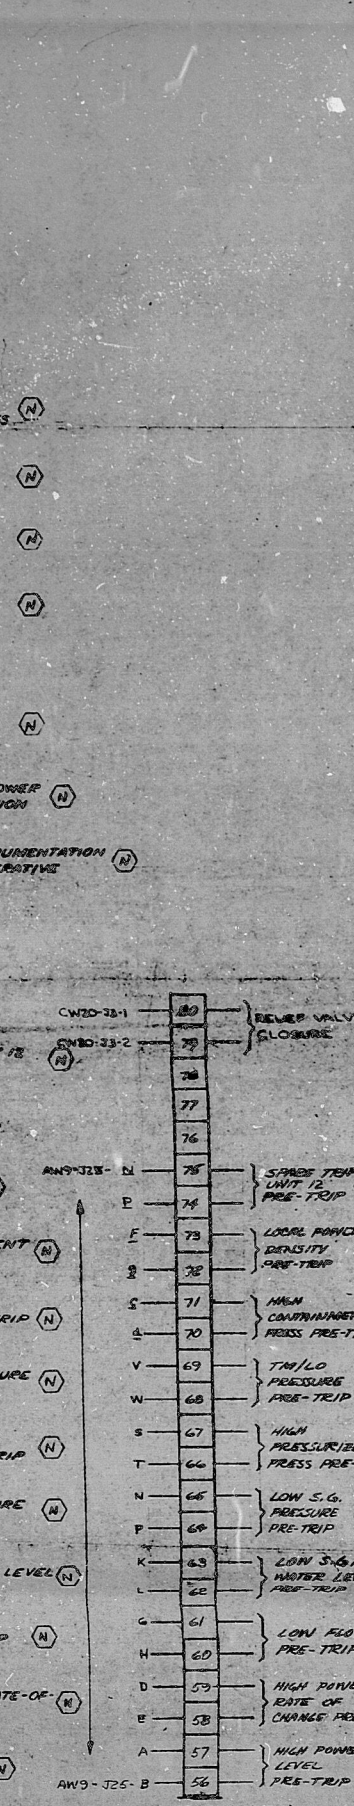
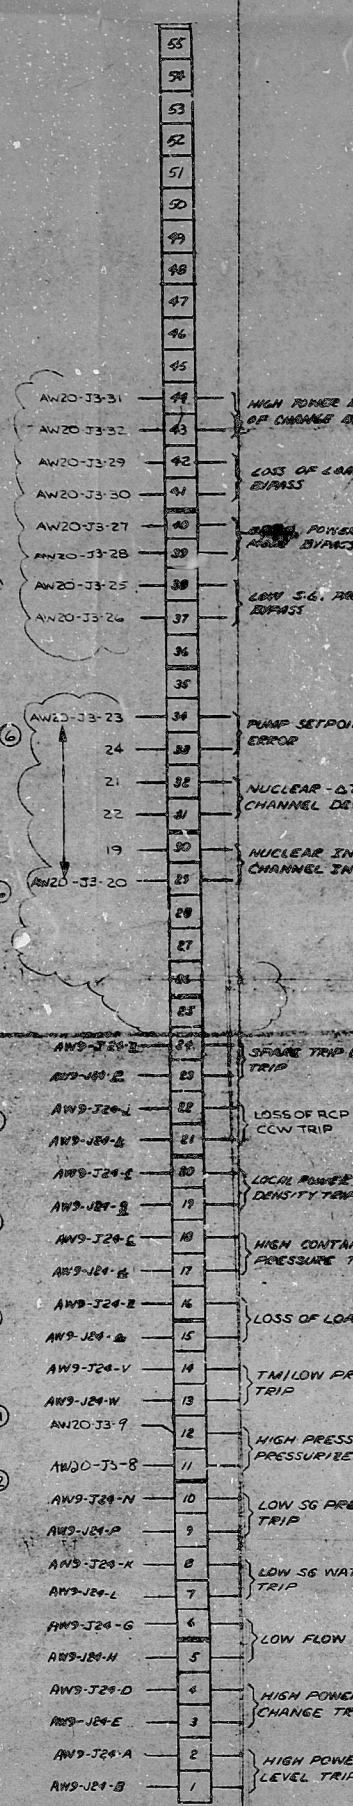
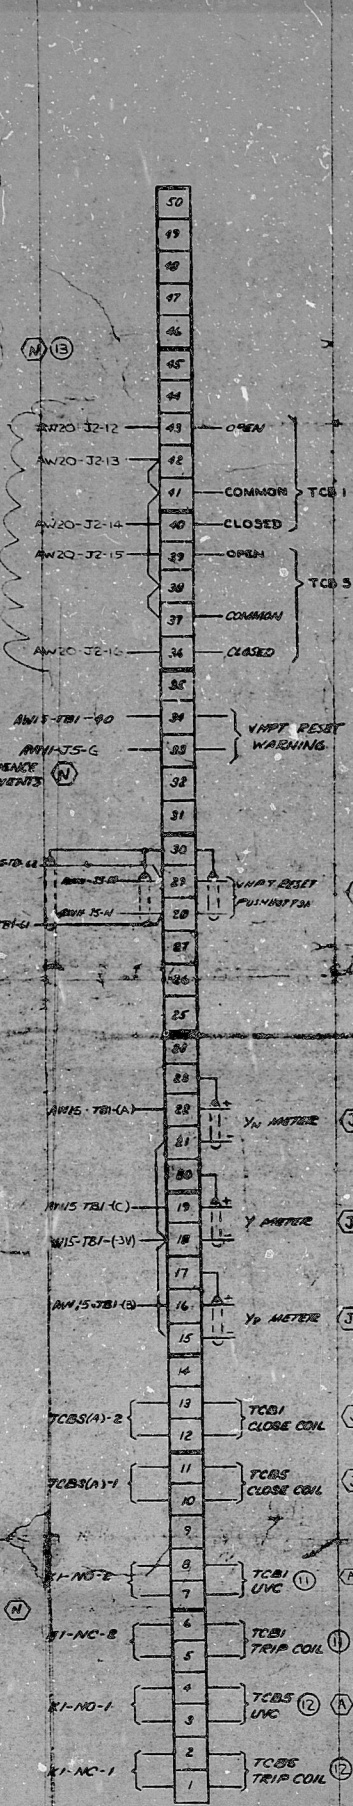
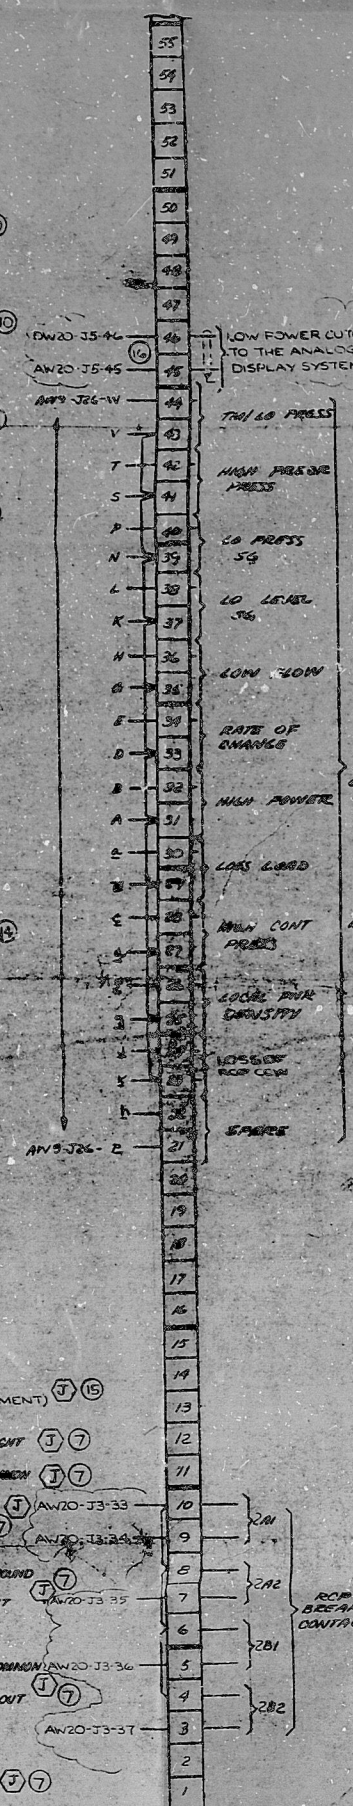




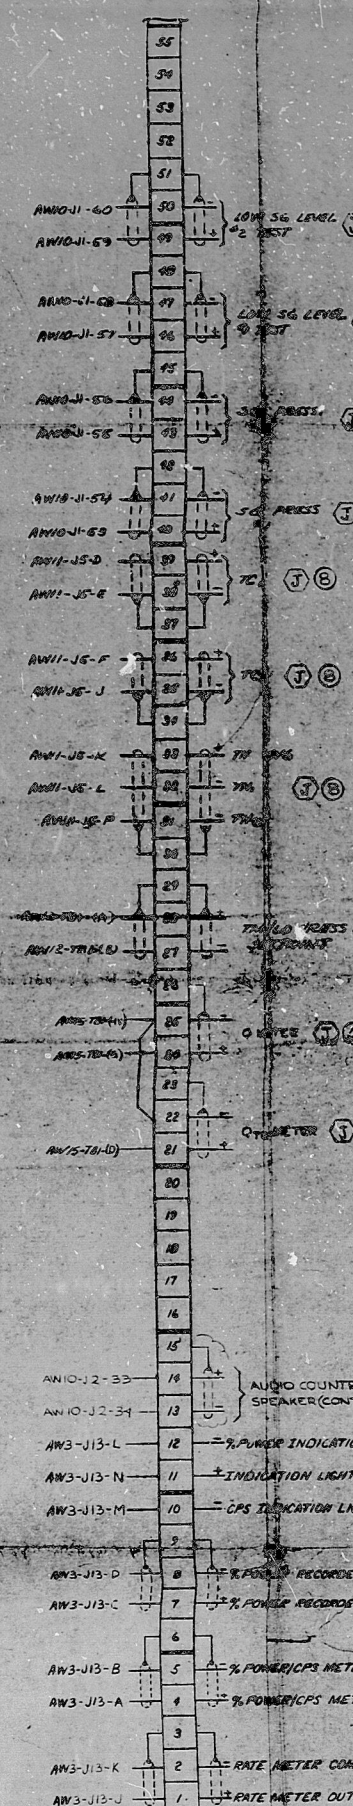

8106100615

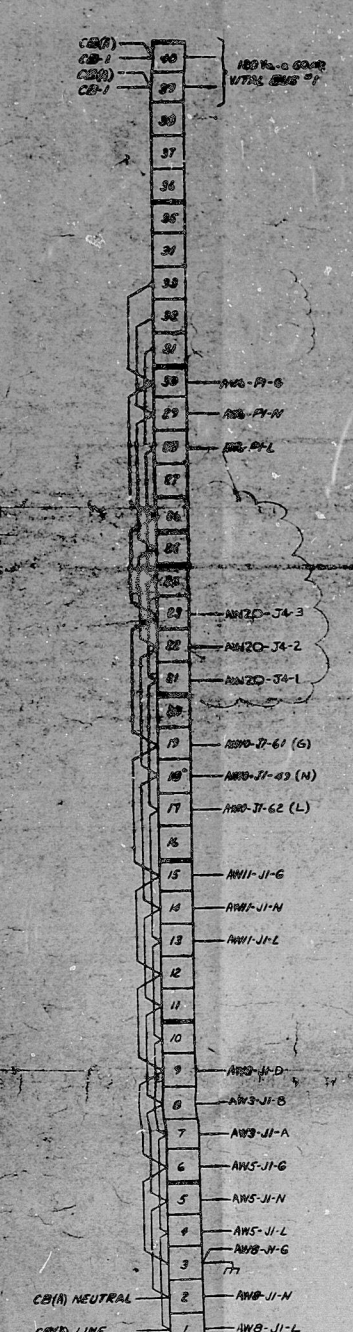