






RIDS

6309290603

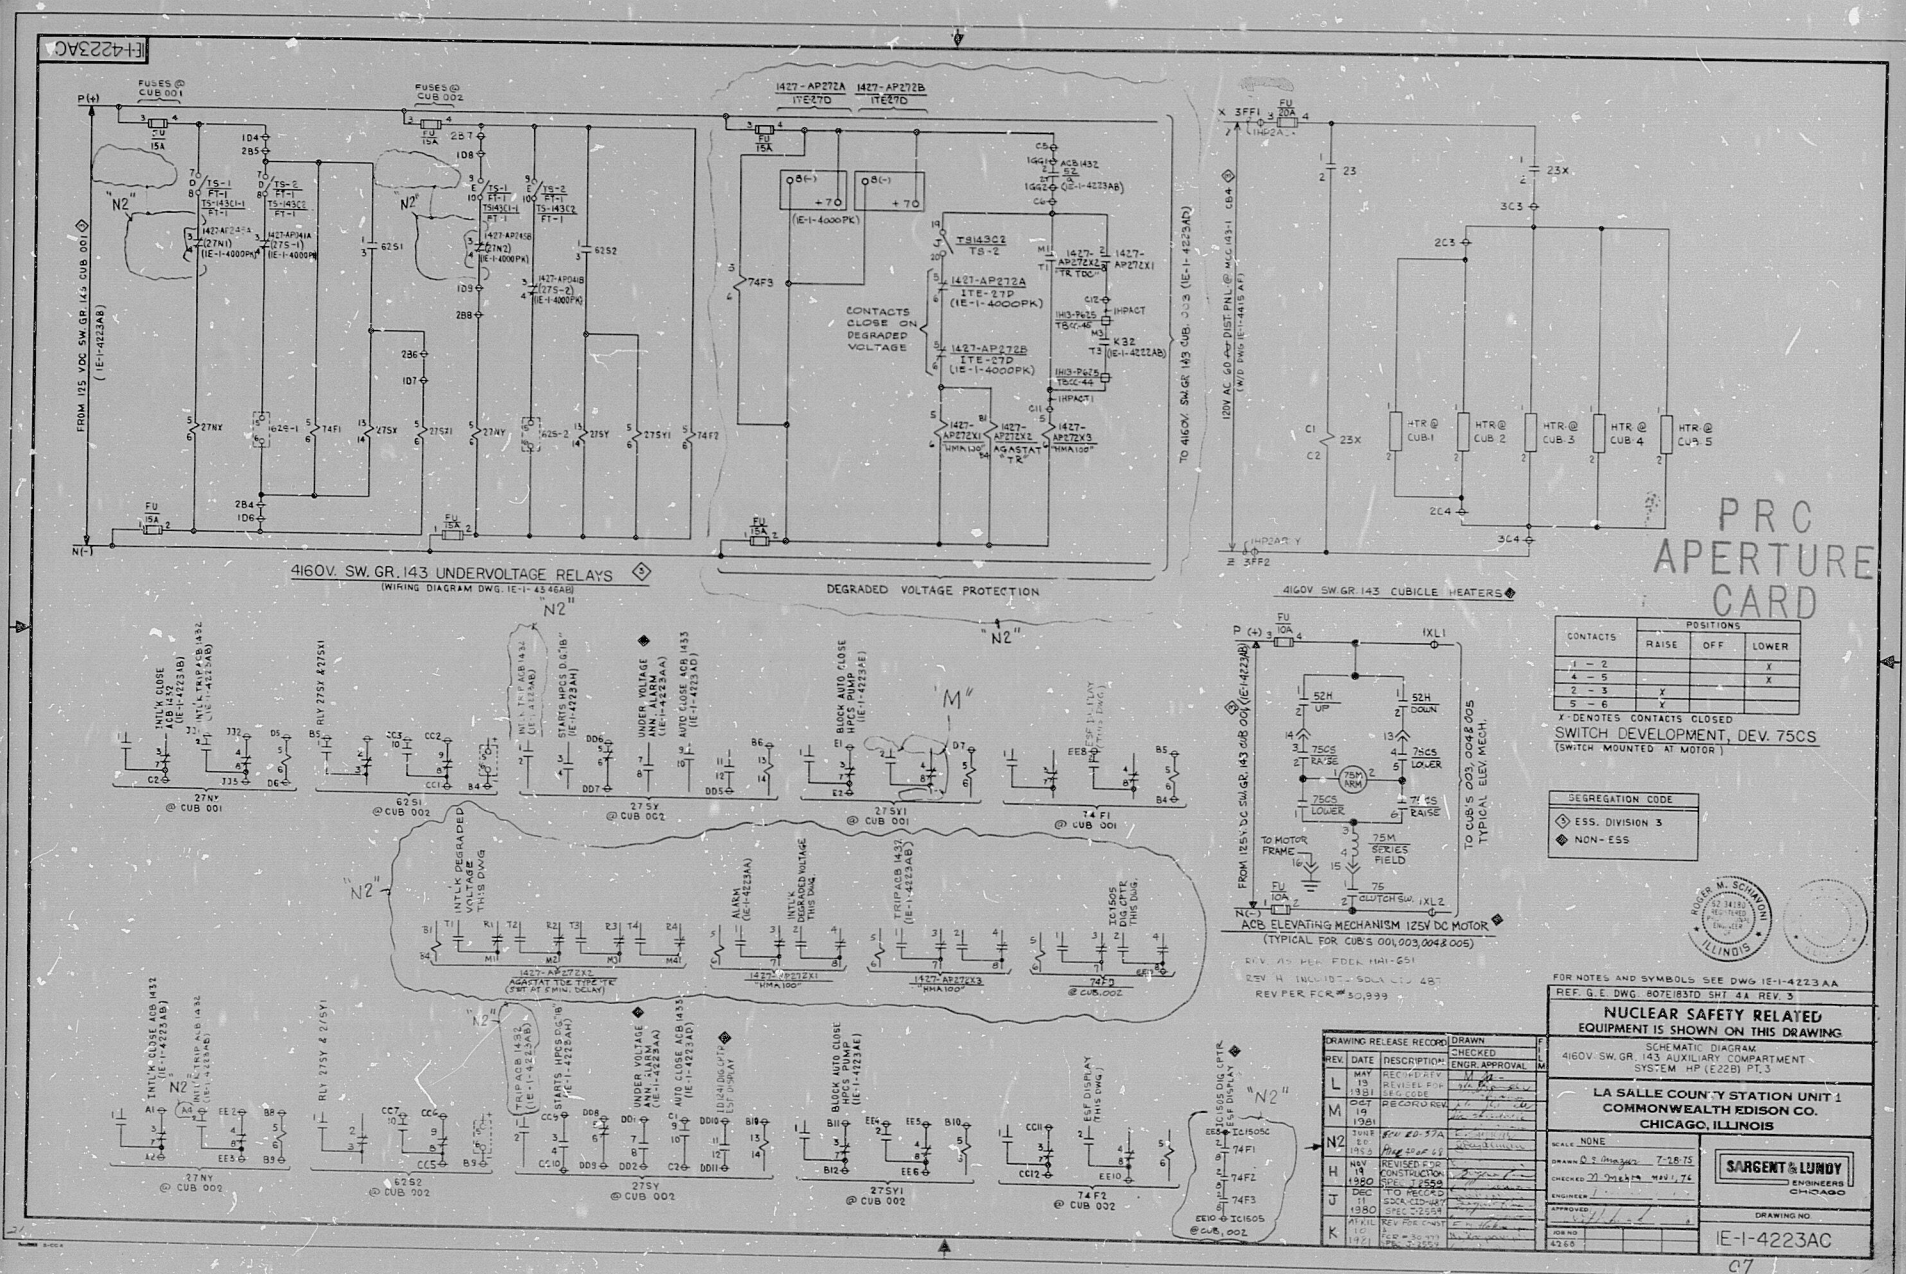