



12-445

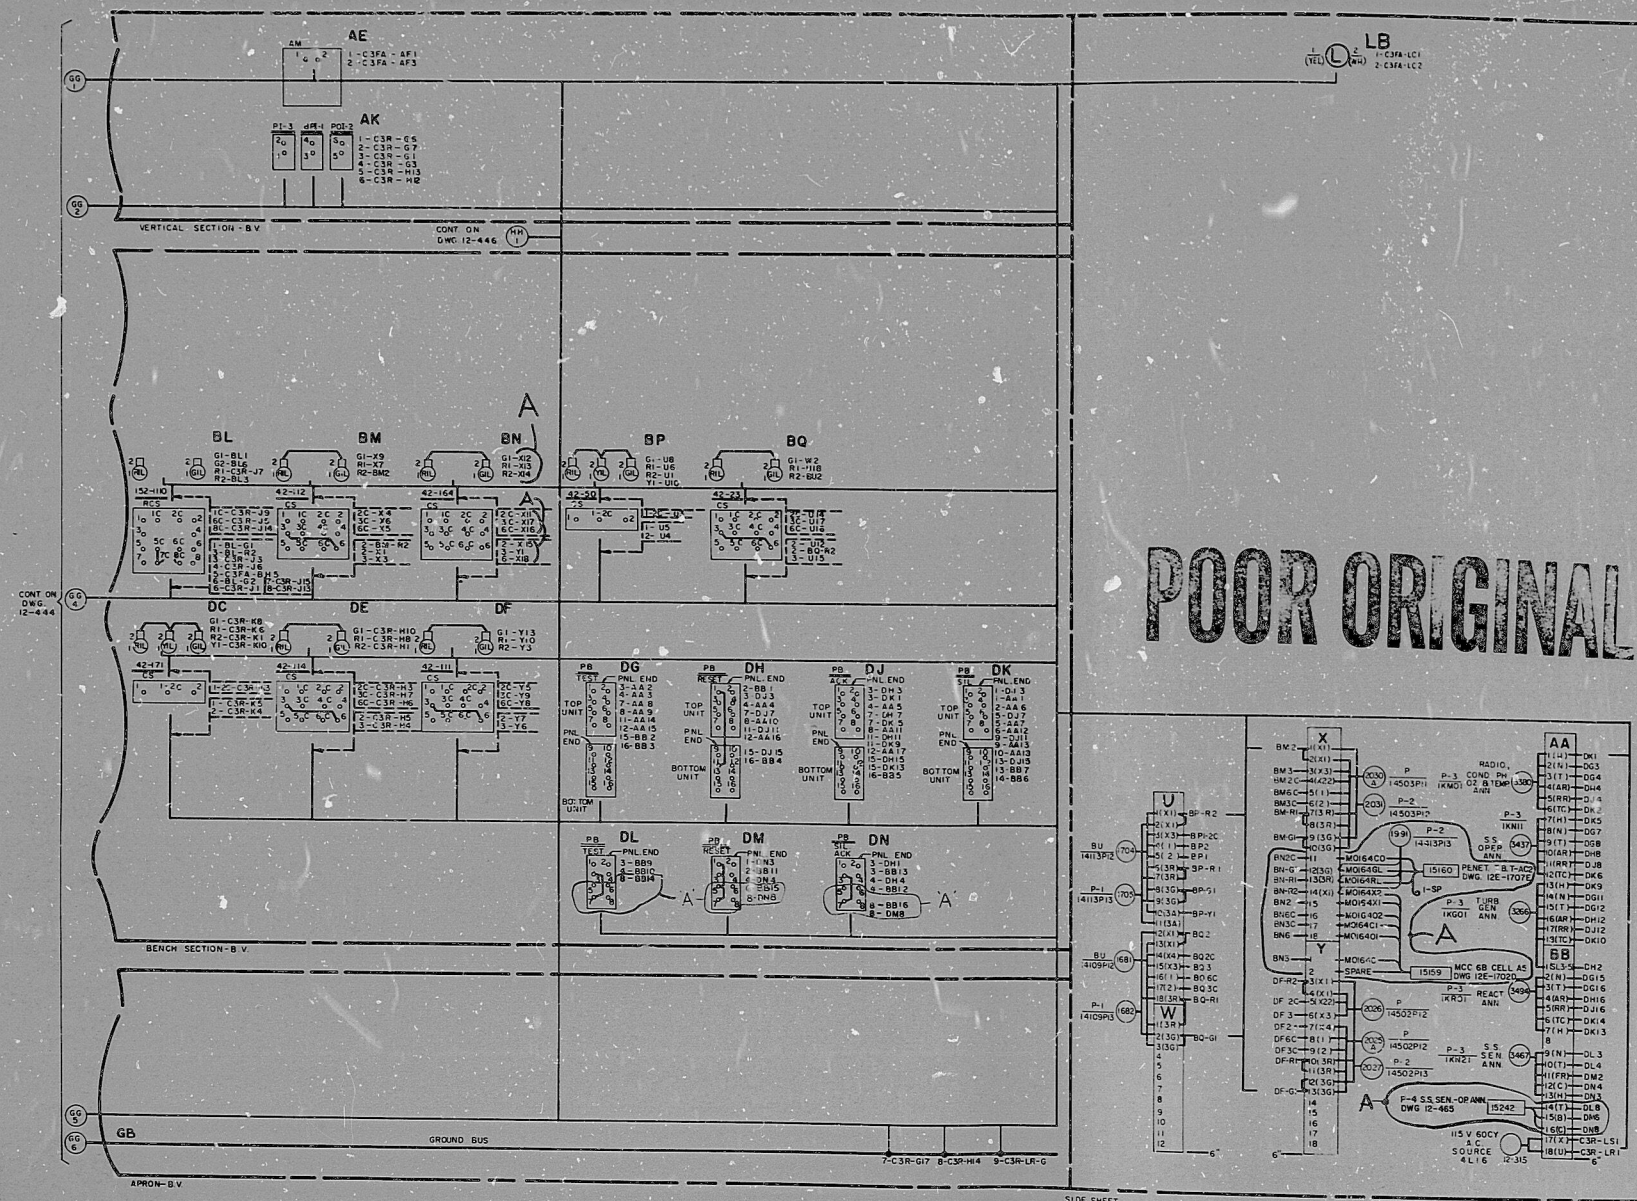

POOR ORIGINAL

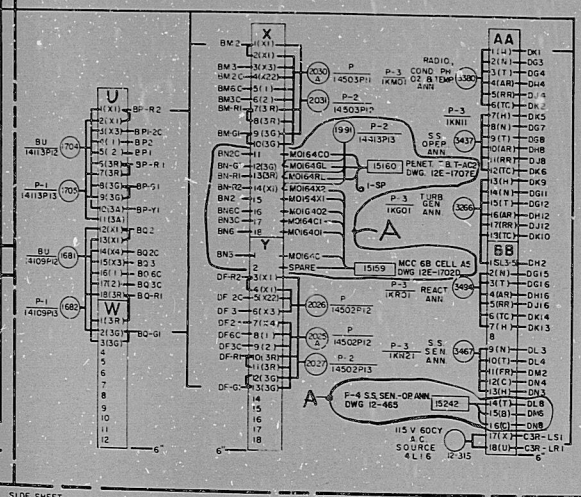

REFERENCE DRAWINGS
LOCATION OF SWITCHBOARDS 17-165
FRONT VIEW OF CONSOLE 12-443
CONNECTION DIAGRAM OF CONSOLE SECTIONS C3FA & C3R
12-444 & 12-445

TERA
APERTURE
CARD

DRAWN FROM GE CO. DWG. 138F-234 SHEET 2 DATED 7-1-60

DATE: 12-445
BY: STAFF J.W.
REVISION:

CONSOLE SECTION C3FB
CONNECTION DIAGRAM

STATION 12 DRESDEN

SCALE: NONE
DATE: 8-1-62
COMMONWEALTH EDISON COMPANY

NRCA ANPGF E0045
8106110107
DDAELE

S.E.P.

8106110107

