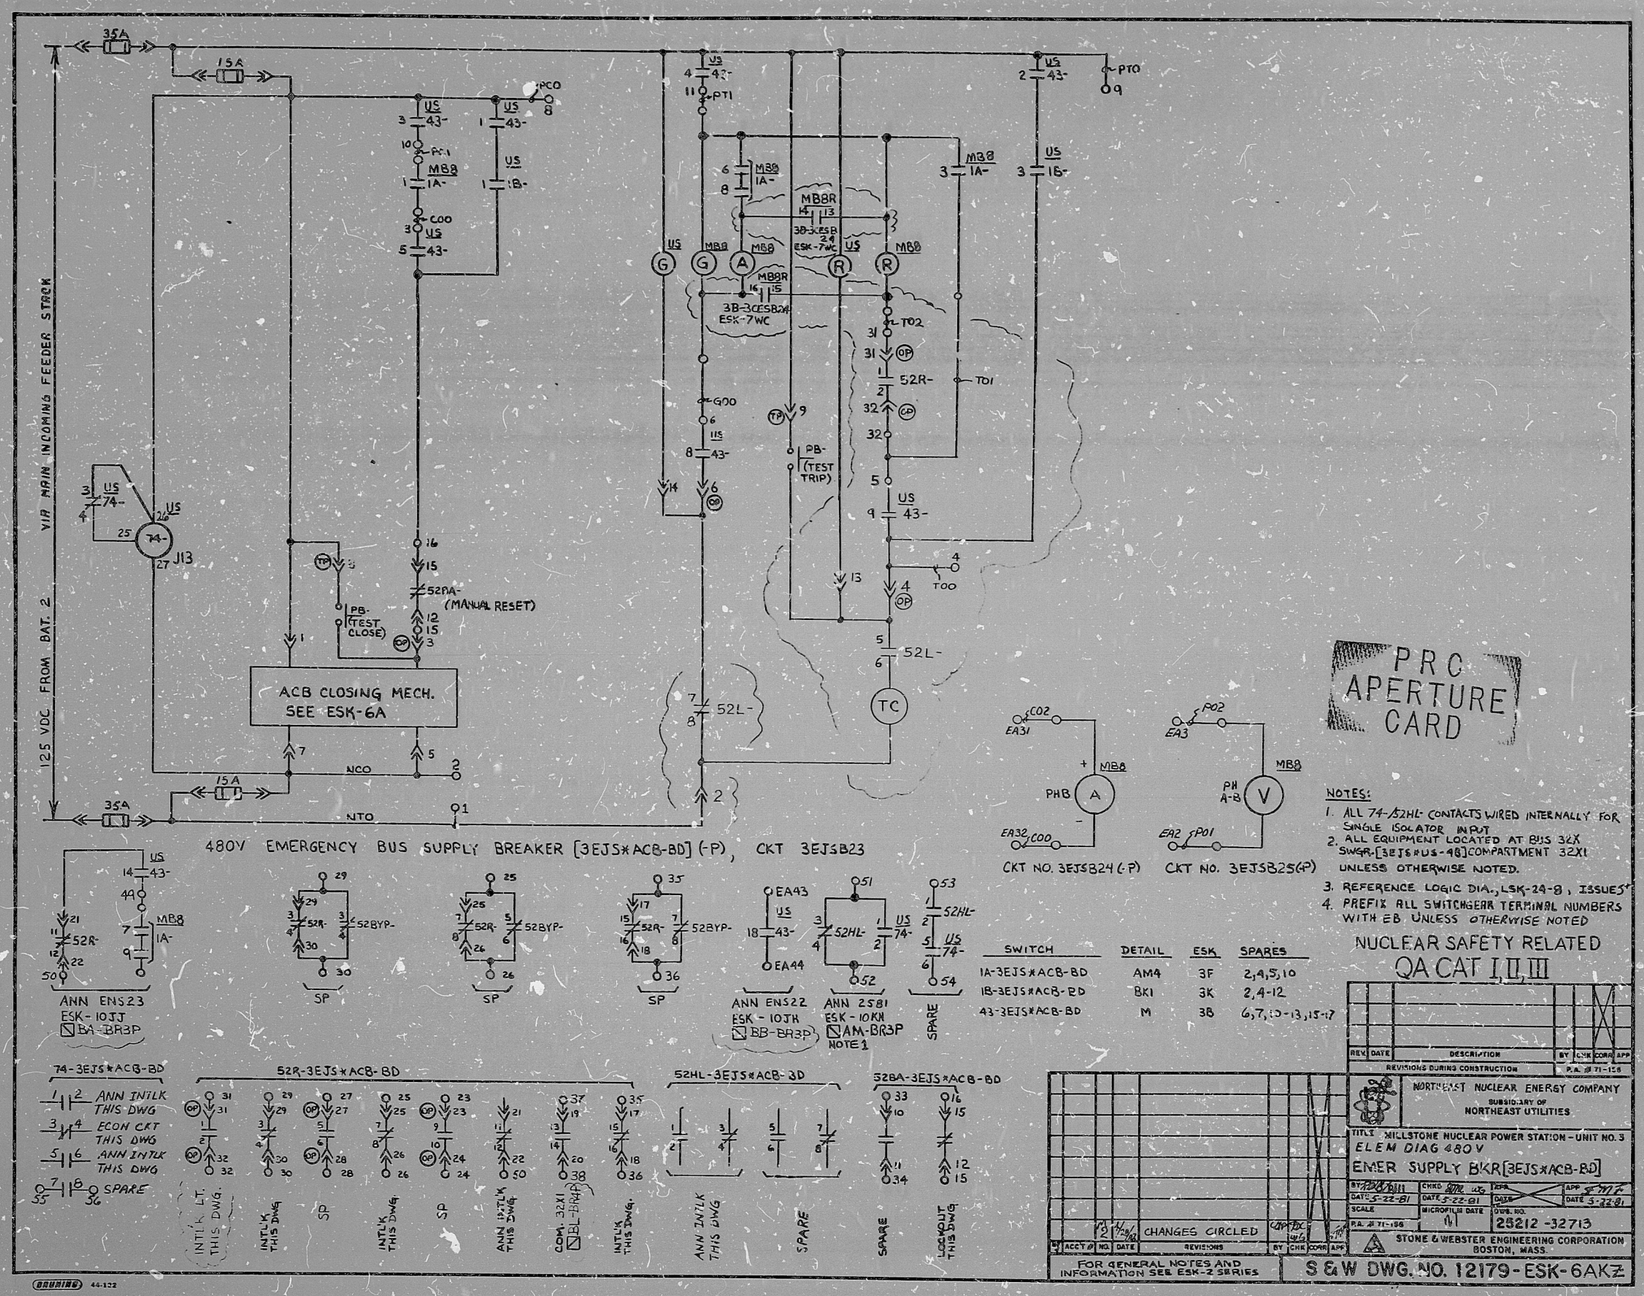

SWITCH	DETAIL	ESK	SPARES
1A-3EJS*ACB-BD	AM4	3F	2,4,5,10
1B-3EJS*ACB-BD	BK1	3K	2,4-12
43-3EJS*ACB-BD	M	3B	6,7,10-13,15-17

RIDS

8212080073

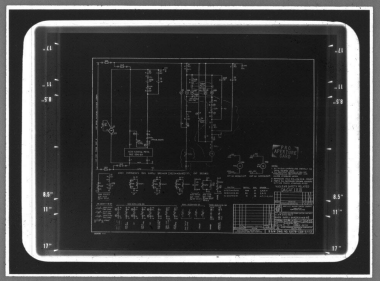

MMM 5824 — FILMSORT® Brand Aperture & Camera Cards and DUPLICARD® Brand Copy Cards — Product of 3M Company, St. Paul, Minn.