


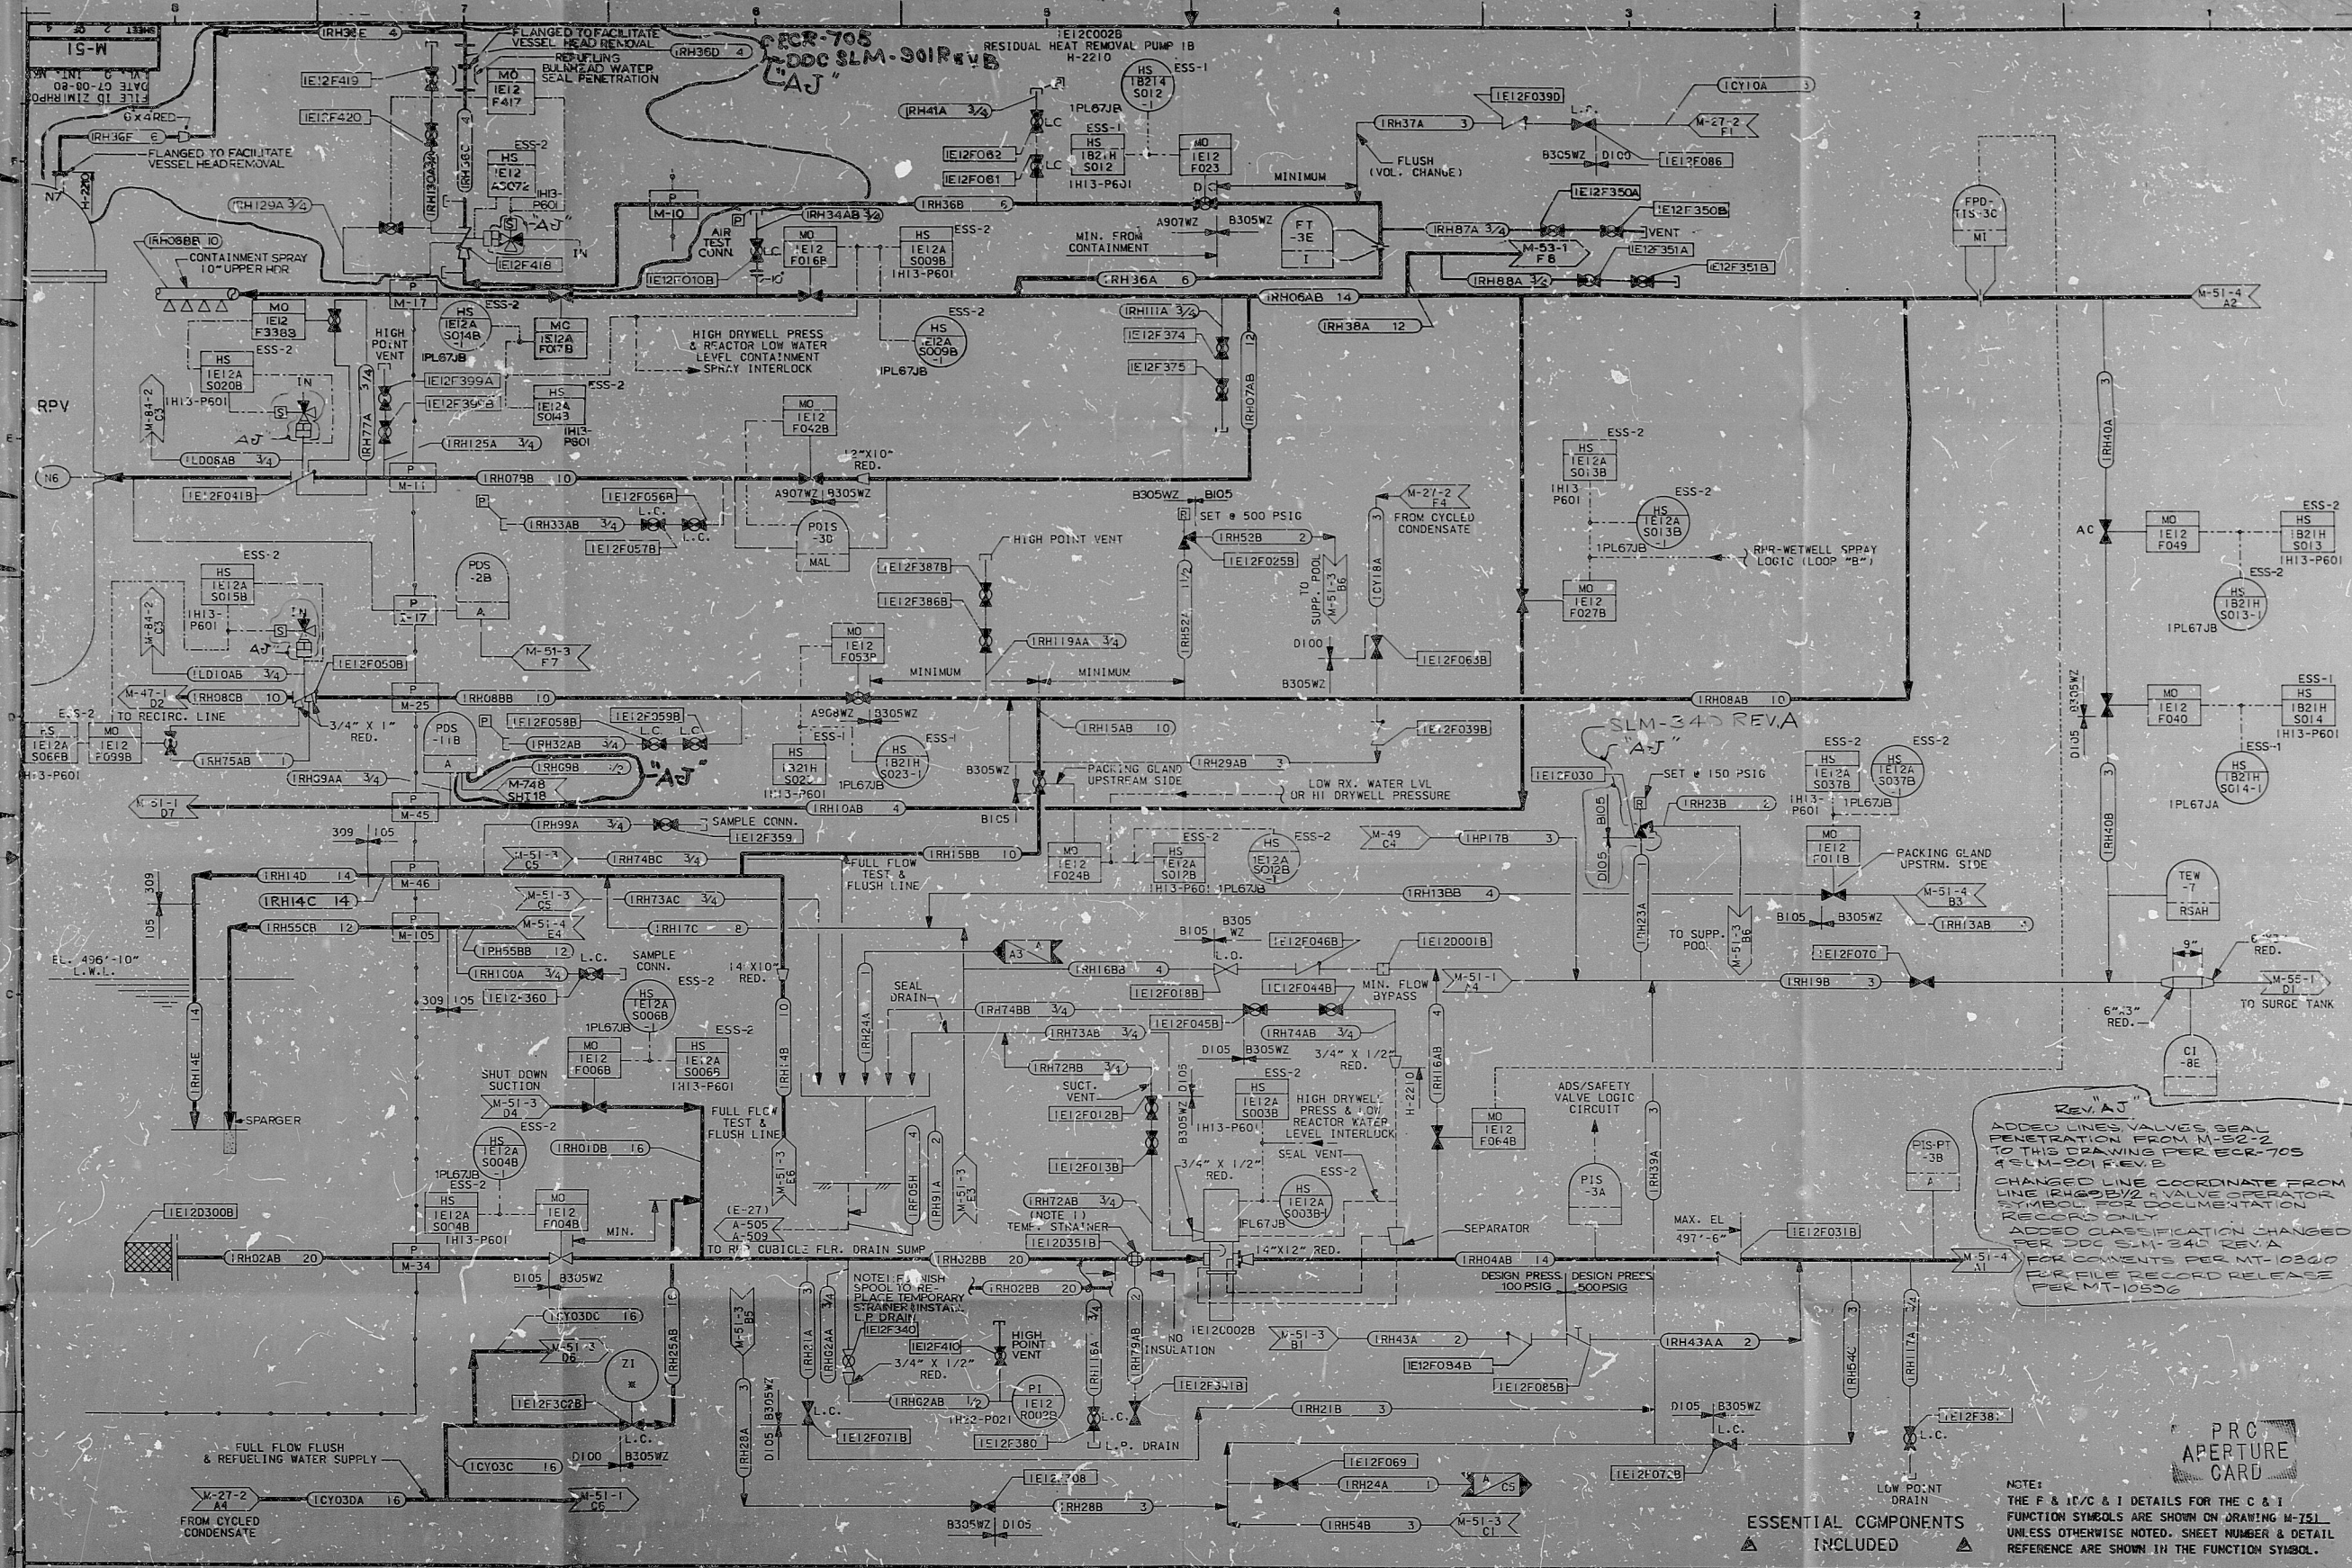

REV. A  
ADDED LINES VALVE SEAL  
PENETRATION FROM M-51-2  
TO THIS DRAWING PER PRC-705  
SLM-340 REV. A  
CHANGED LINE COORDINATE FROM  
LINE 1000000 TO VALVE OPERATOR  
SYMBOL FOR DOCUMENTATION  
RECORDS ONLY  
ADDED CLASSIFICATION CHANGED  
PER PRC-705 SLM-340 REV. A  
FOR COMMENTS PER MT-10300  
FOR FILE RECORD RELEASE  
PER MT-10300

PRC  
APERTURE  
CARD

ESSENTIAL COMPONENTS  
INCLUDED


P & ID  
RESIDUAL HEAT REMOVAL  
(RH)  
R. H. ZIMMER NUCLEAR POWER STATION UNIT I  
THE CINCINNATI GAS & ELECTRIC CO.  
COLUMBUS & SOUTHERN OHIO ELECTRIC CO.  
THE DAYTON POWER & LIGHT CO.

SARGENT & LUNDY  
CHICAGO  
DRAWING NO. M-51  
SHEET 2 OF 4

Rids

8212080131

