

34"

72"

77"

66"

60"


85"

11"

17"

22"

34"

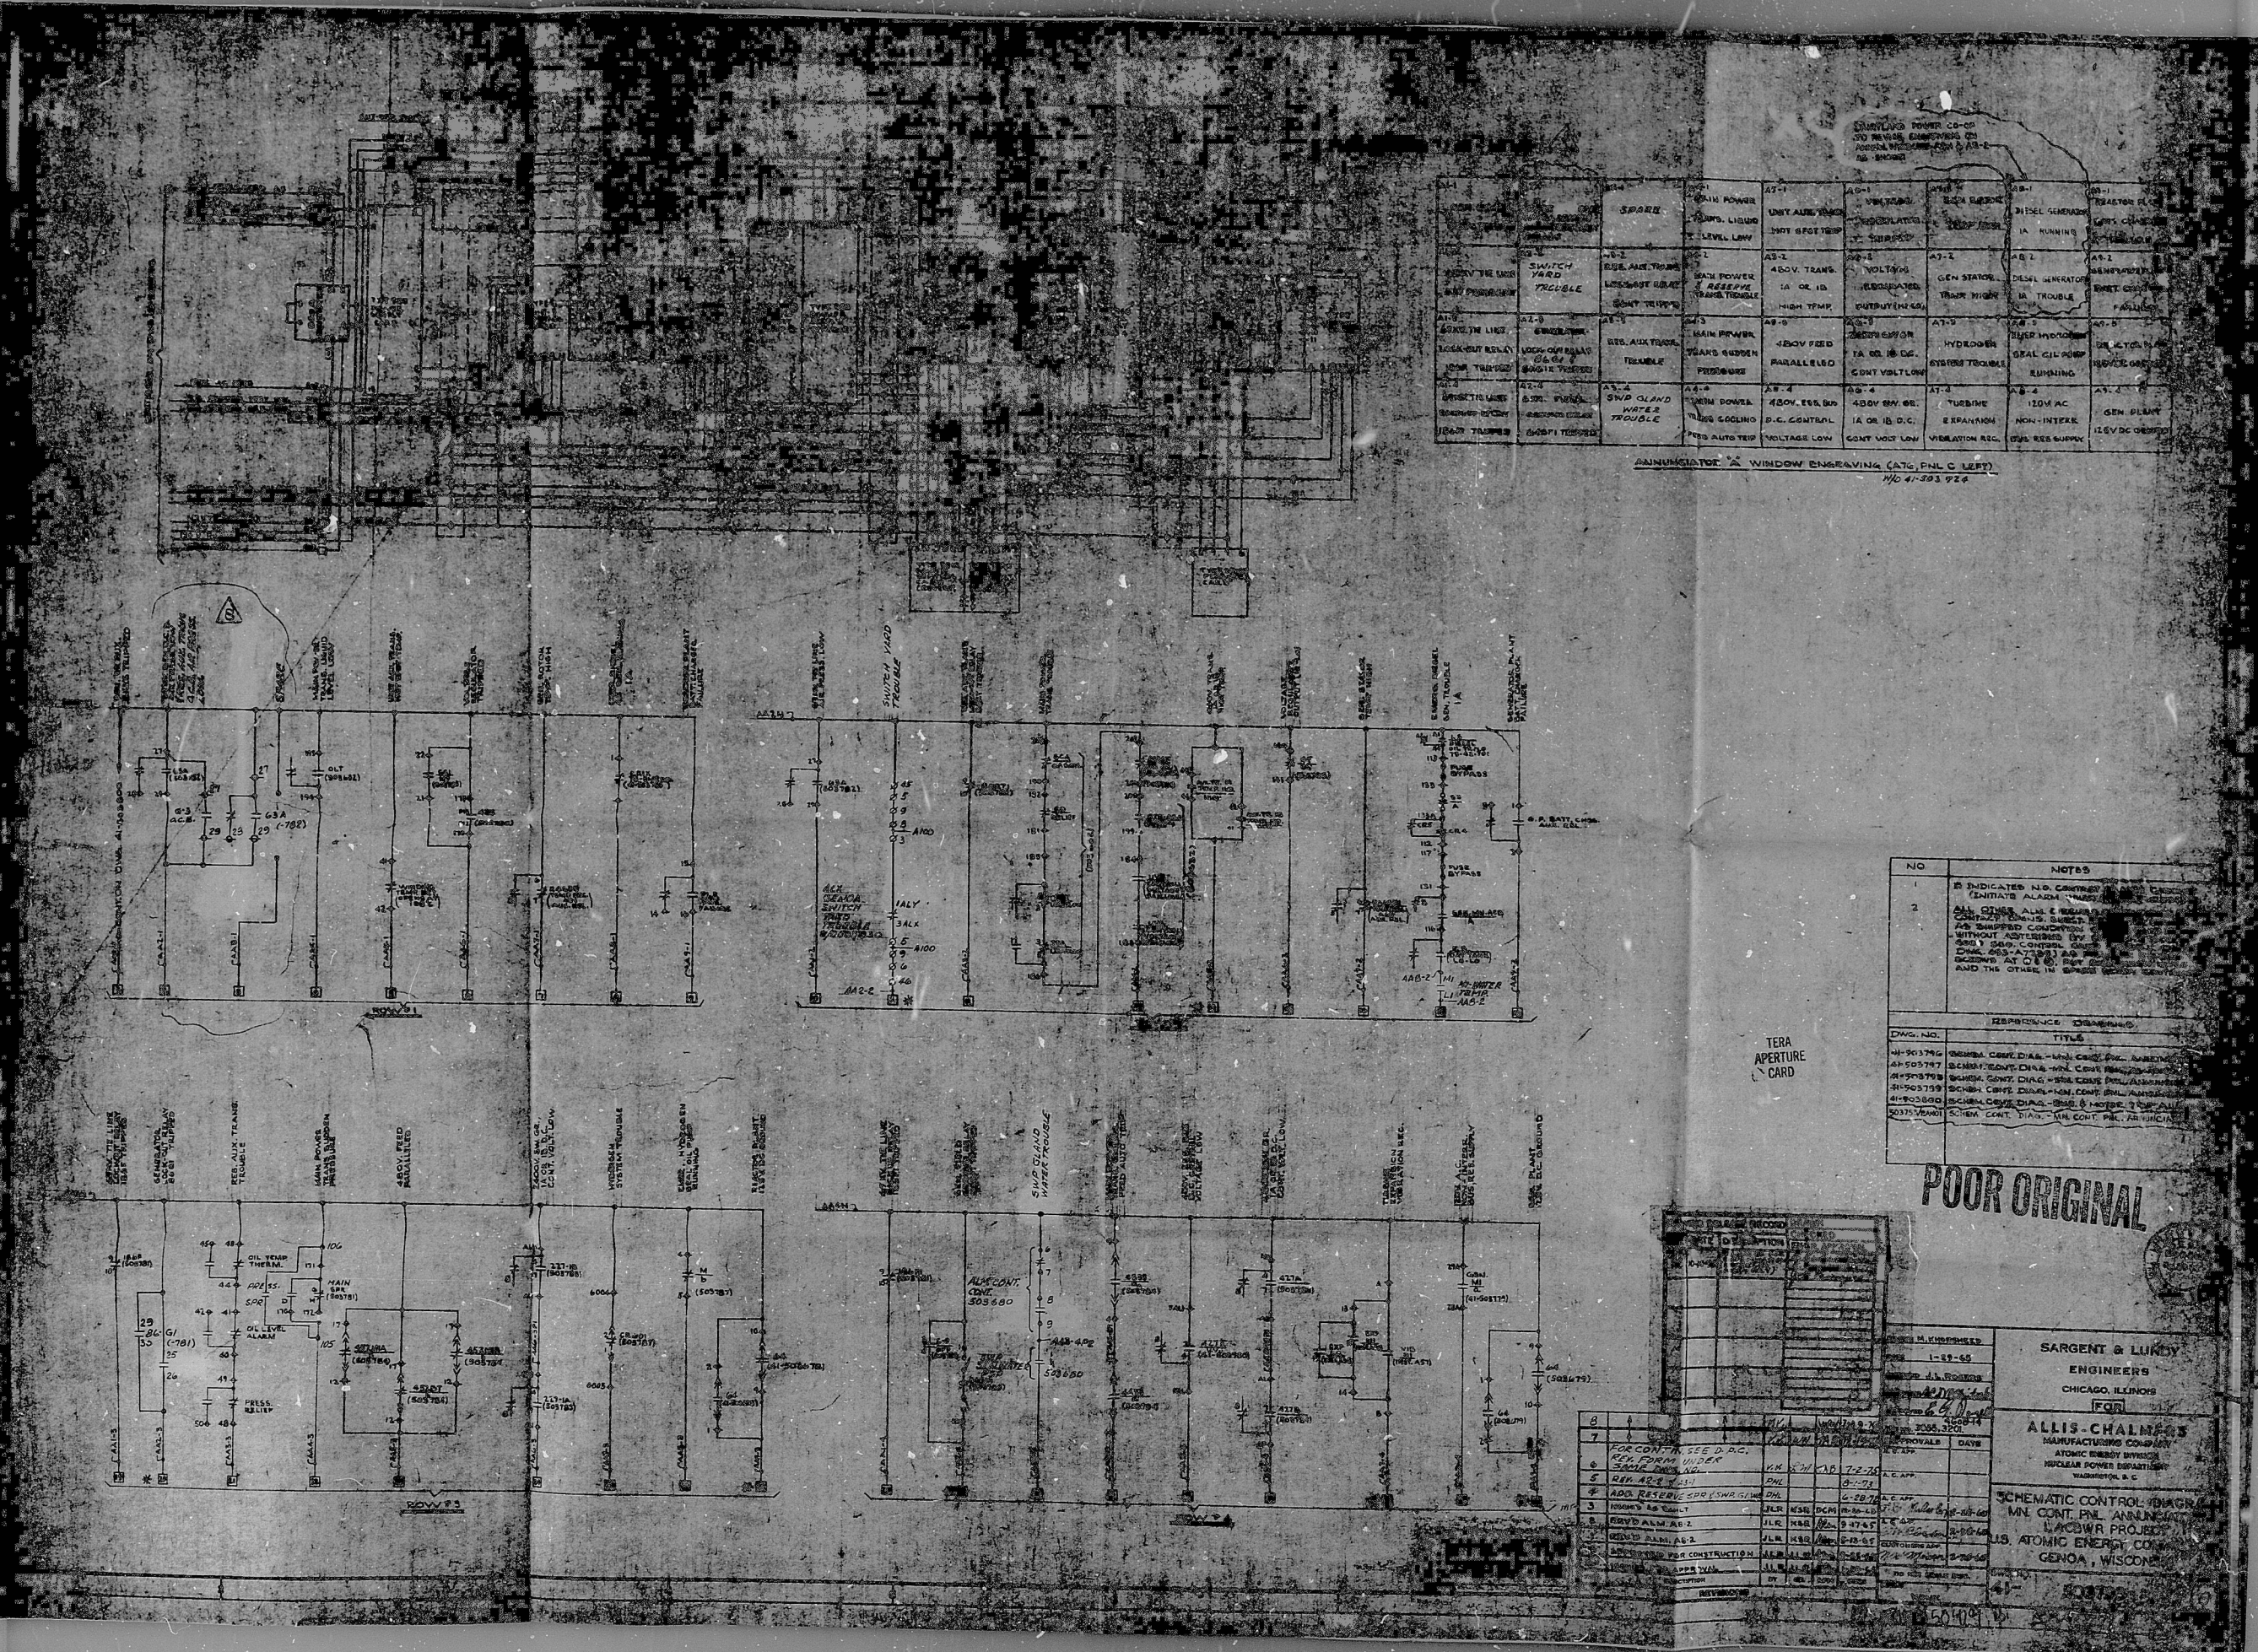


NO 41-383 924

| NO | NOTES   |
|----|---|
| 1  | INDICATES H.S. CONTROL (INITIALS) (INITIALS) (INITIALS)   |


TERA  
APERTURE  
CARD

POOR ORIGINAL


SARGENT & LUNDY  
ENGINEERS  
CHICAGO, ILLINOIS

ALLIS-CHALMERS  
MANUFACTURING COMPANY  
ATOMIC ENERGY DIVISION  
NUCLEAR POWER DEPARTMENT  

SCHEMATIC CONTROL DIAGRAM  
M.N. CONT. PNL. ANNUNCIATOR  
HACWR PROJECT  
U.S. ATOMIC ENERGY COM.  
GENOA, WISCONSIN

34"



SEP

8106150429

