



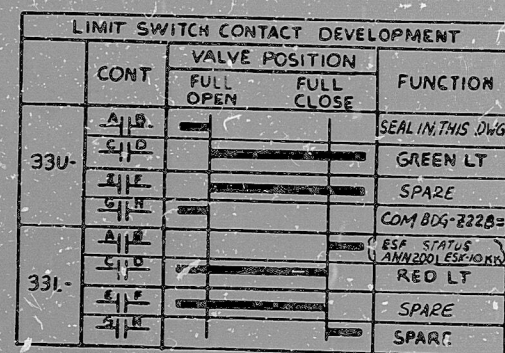

NOTE

1. ALL EQUIPMENT LOCATED AT M91 UNLESS OTHERWISE NOTED
2. REF LOGIC DIAG (LSK-32/3A) ISSUE 5
3. ~~INDICATES~~ INDICATES CONTACT CLOSED
4. LIMIT SWITCH IS NAMCO SERIES EA110 HEAVY DUTY LIMIT SWITCH.

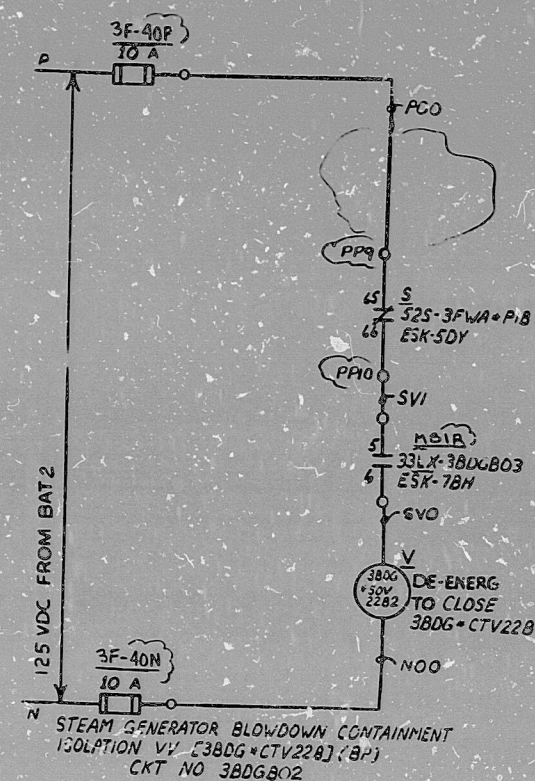

APERTURE
CARD

NUCLEAR SAFETY RELATED
QA CAT I II III

CTV22B	"AEI"	3F	17, 28
--------	-------	----	--------

REV	DATE	DESCRIPTION	BY	CHK	APP
		REVISIONS DURING CONSTRUCTION			P.E. & H-110

1	7/24	CHANGES CIRCLED	WJS	WJS	
2	7/24	CHANGES CIRCLED	WJS	WJS	
3	7/24	CHANGES CIRCLED	WJS	WJS	
4	7/24	REDRAWN	WJS	WJS	

PROJECT NO.	DATE	REVISED	BY	CHK	APP

FOR GENERAL NOTES AND INFORMATION SEE EX-6 SERIES	
---	--

S & W DWG. NO. 12179-ESK-78J	
------------------------------	--

RIDS

8212080198

