


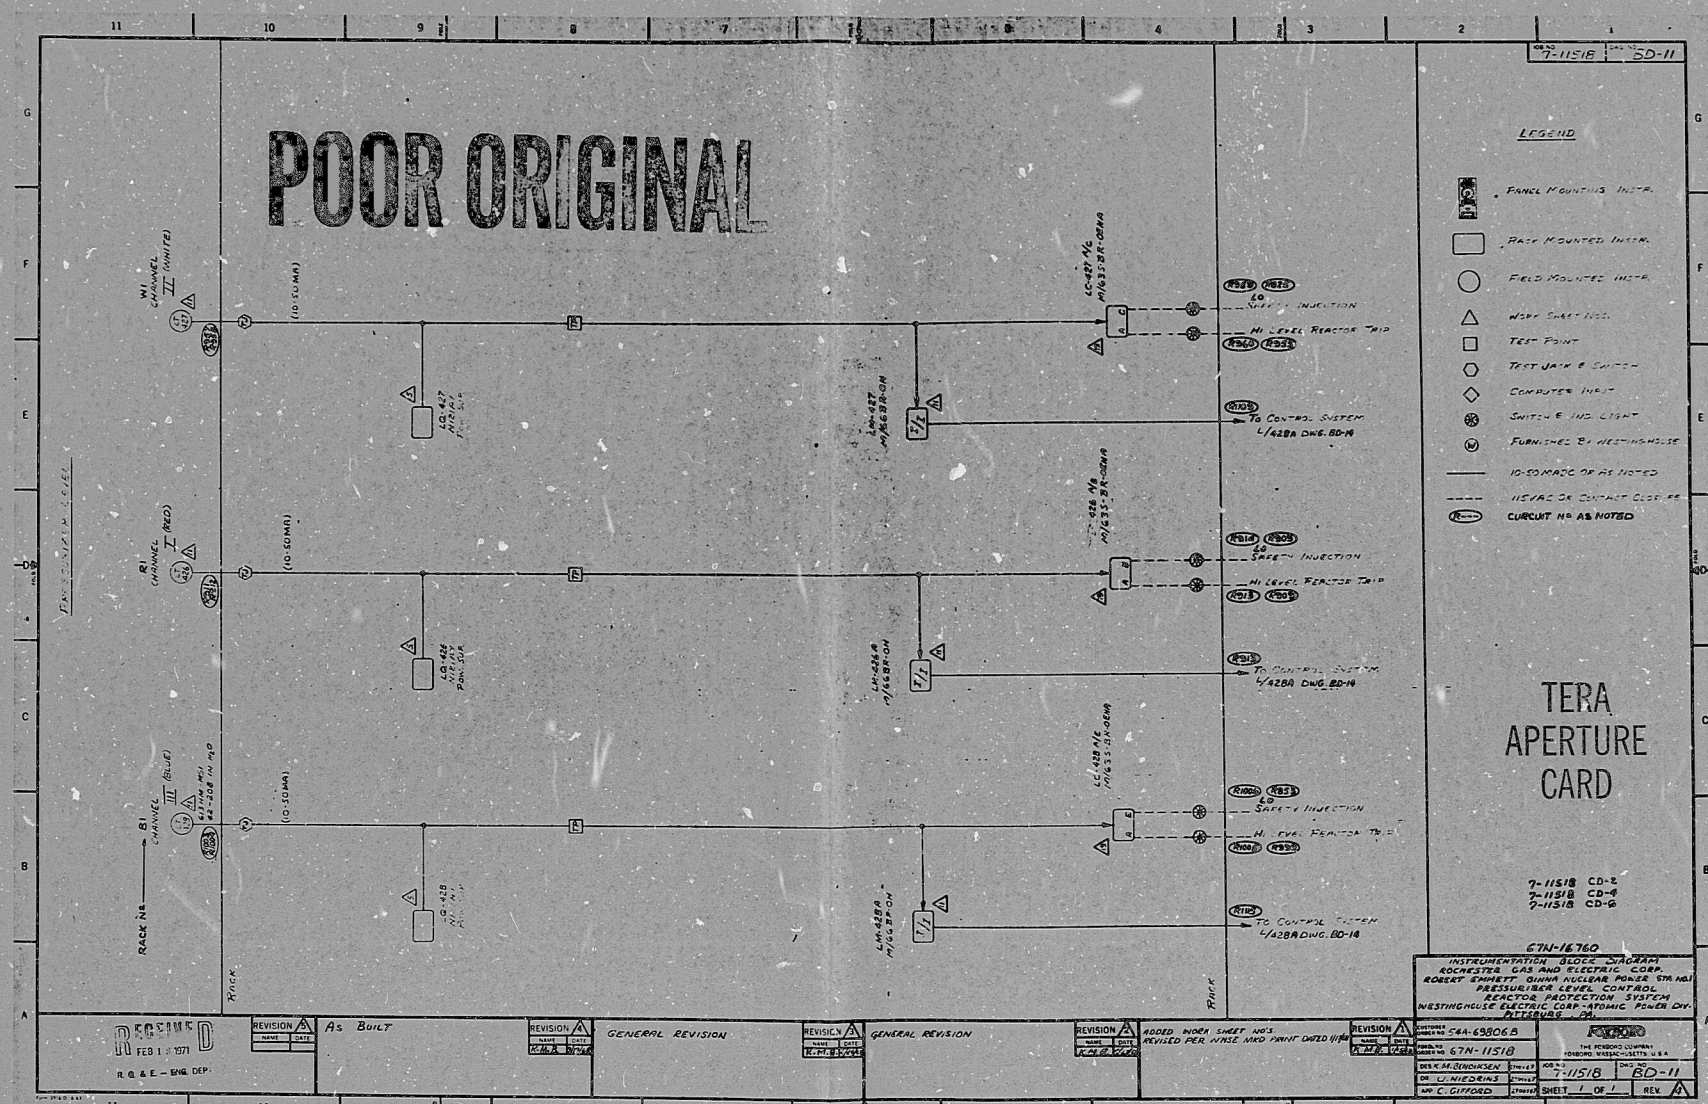

SEP

8106150610

