






Rids

8212080334

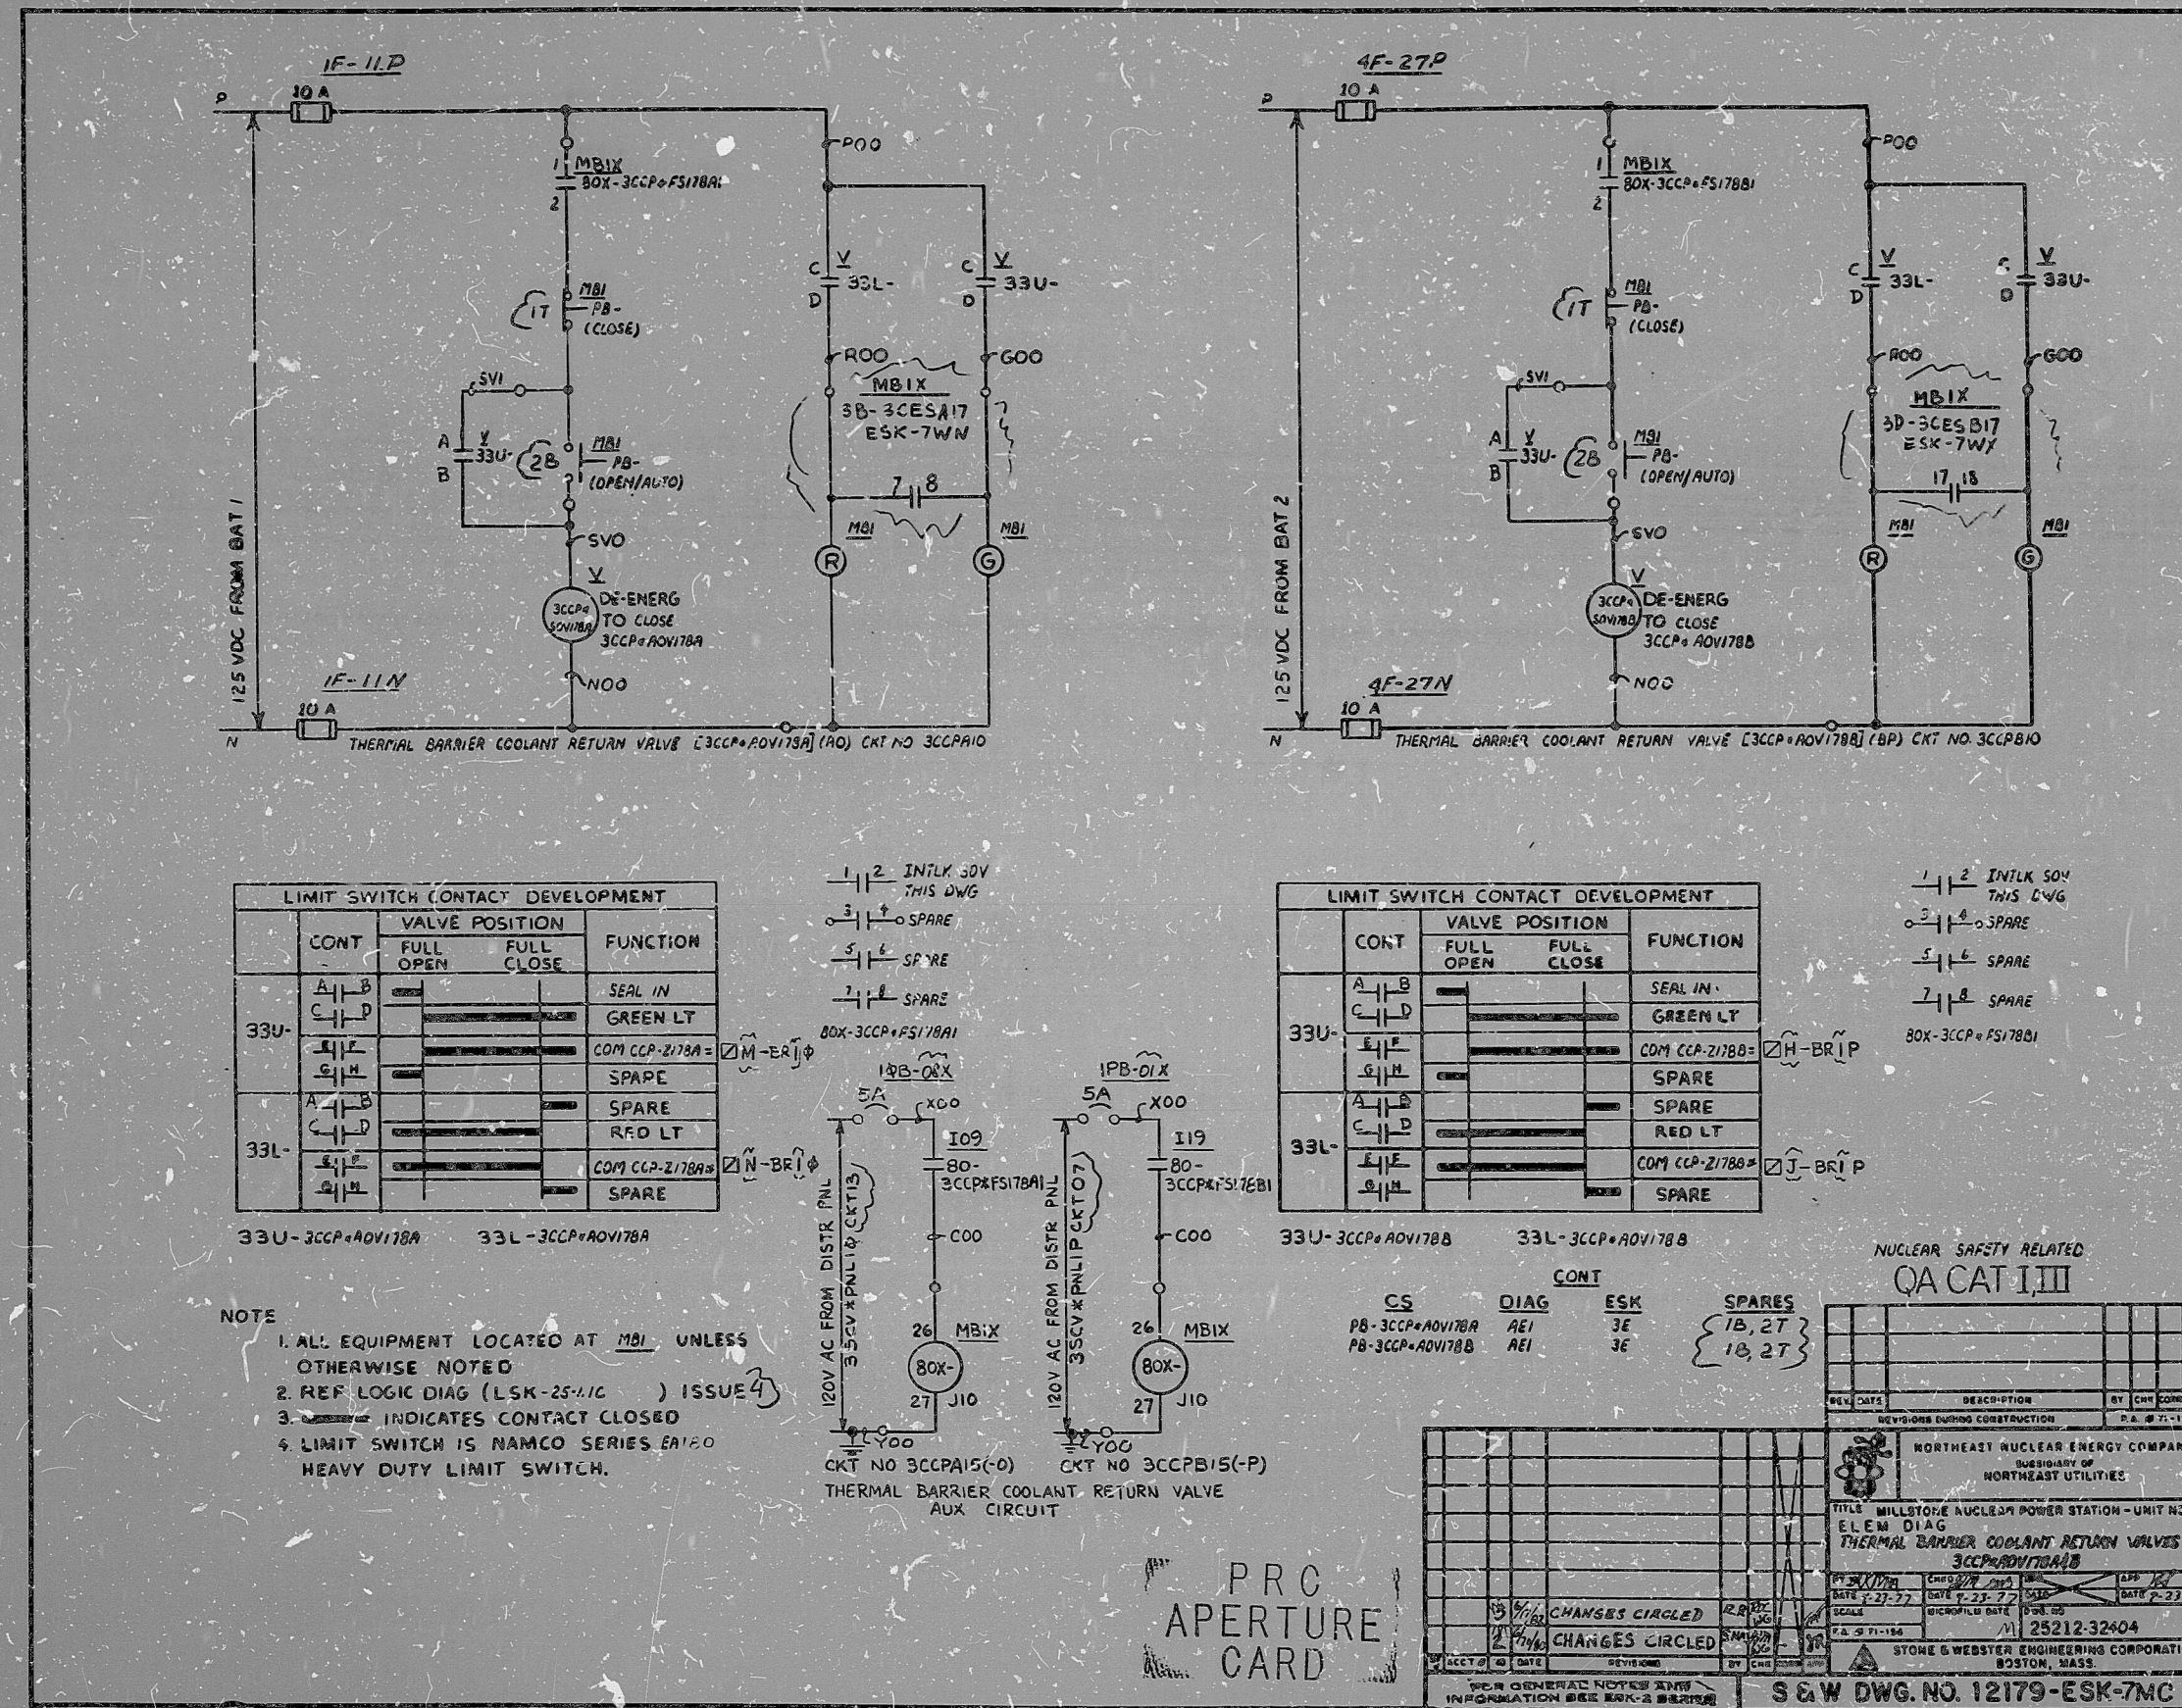