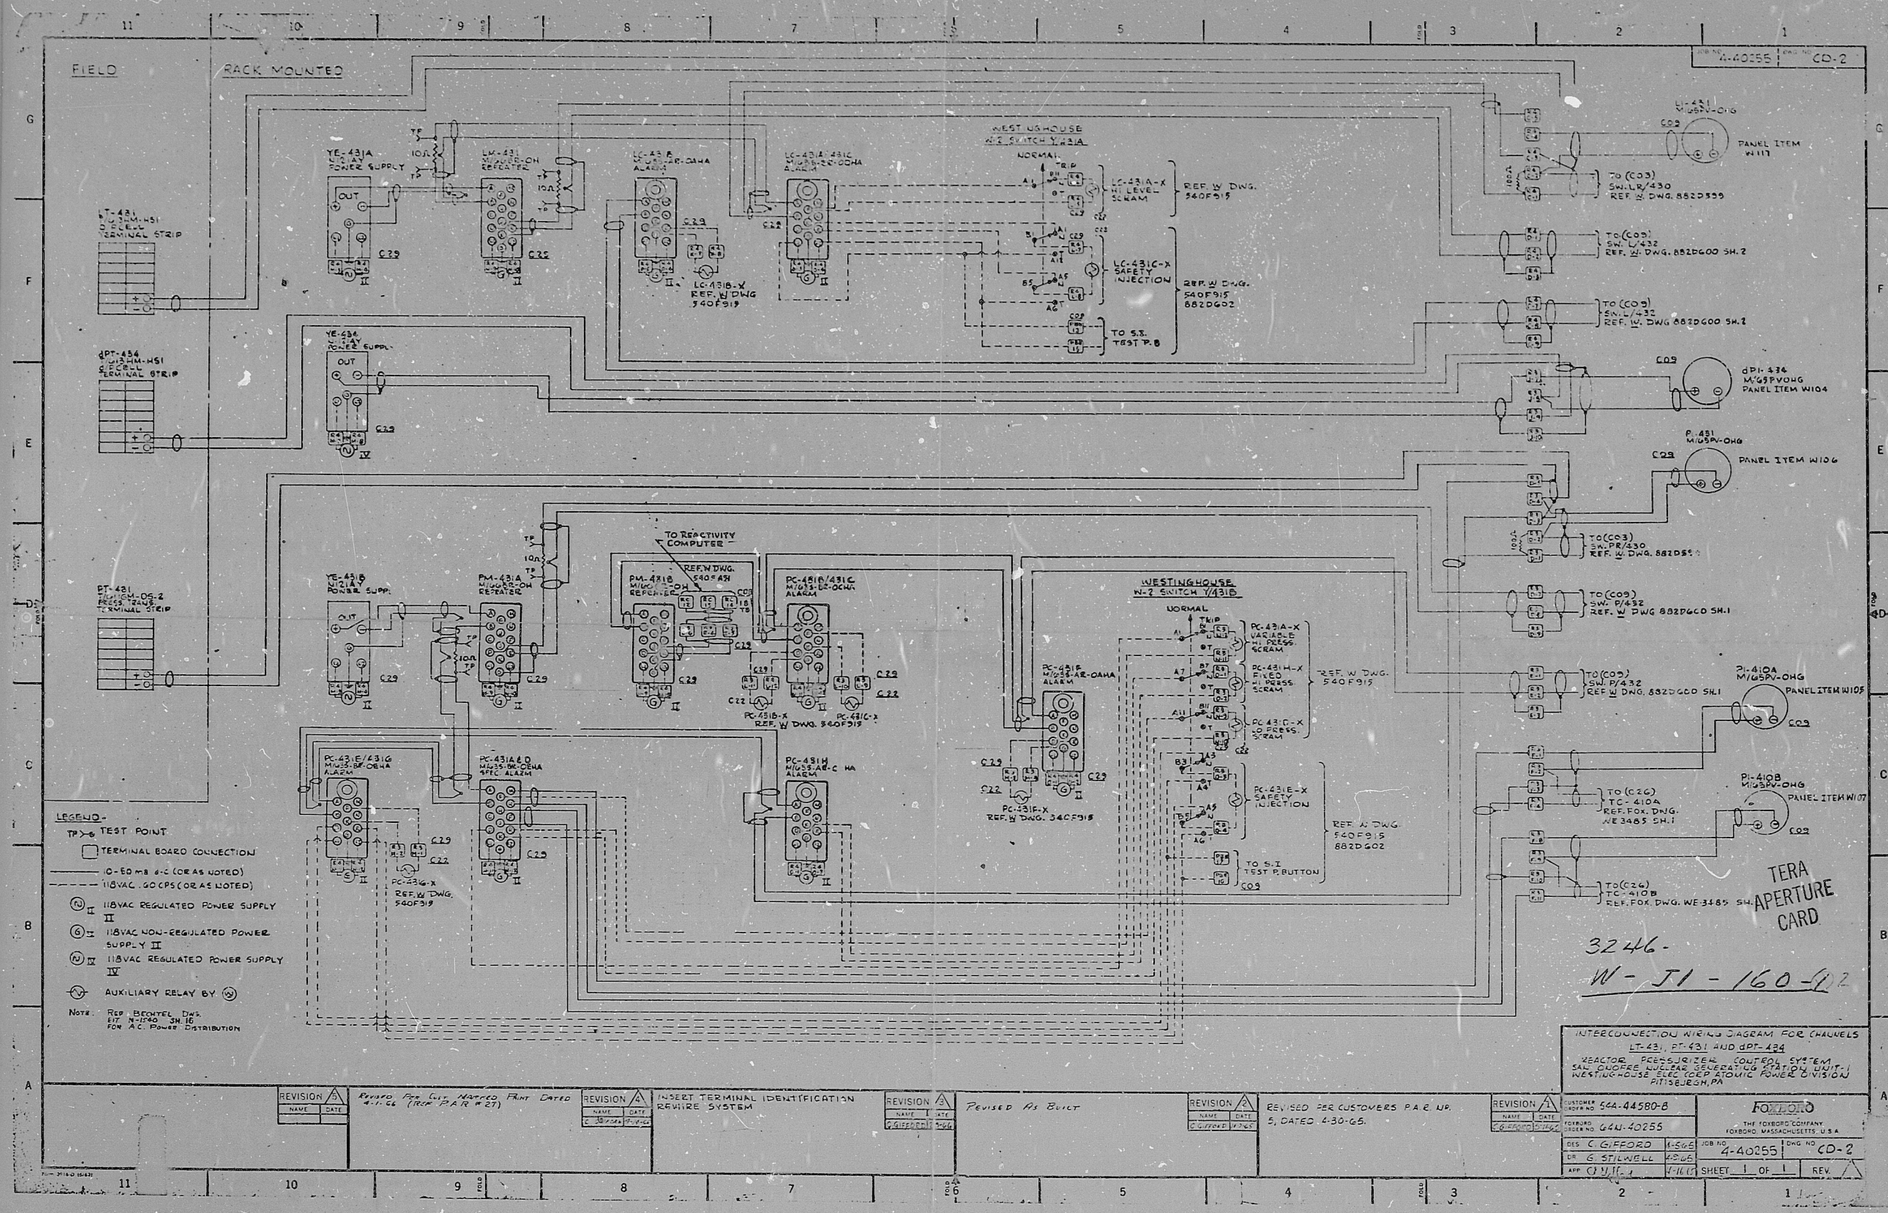

TERA APERTURE CARD

3246-
W-J1-160-12

RETURN TO REACTOR DOCKET FILES

8106180194

Docket # 50-206
Control # 7906130253
Date 78/08/09 of Document
REGULATORY DOCKET FILE

SeP

8106180194

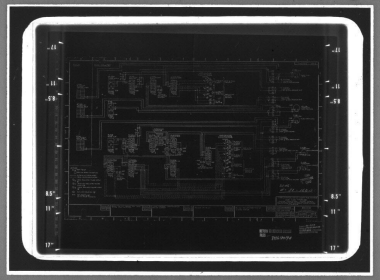

MMM 5824 — FILMSORT® Brand Aperture & Camera Cards and DUPLICARD® Brand Copy Cards — Products of 3M Company — St. Paul, Minn.