


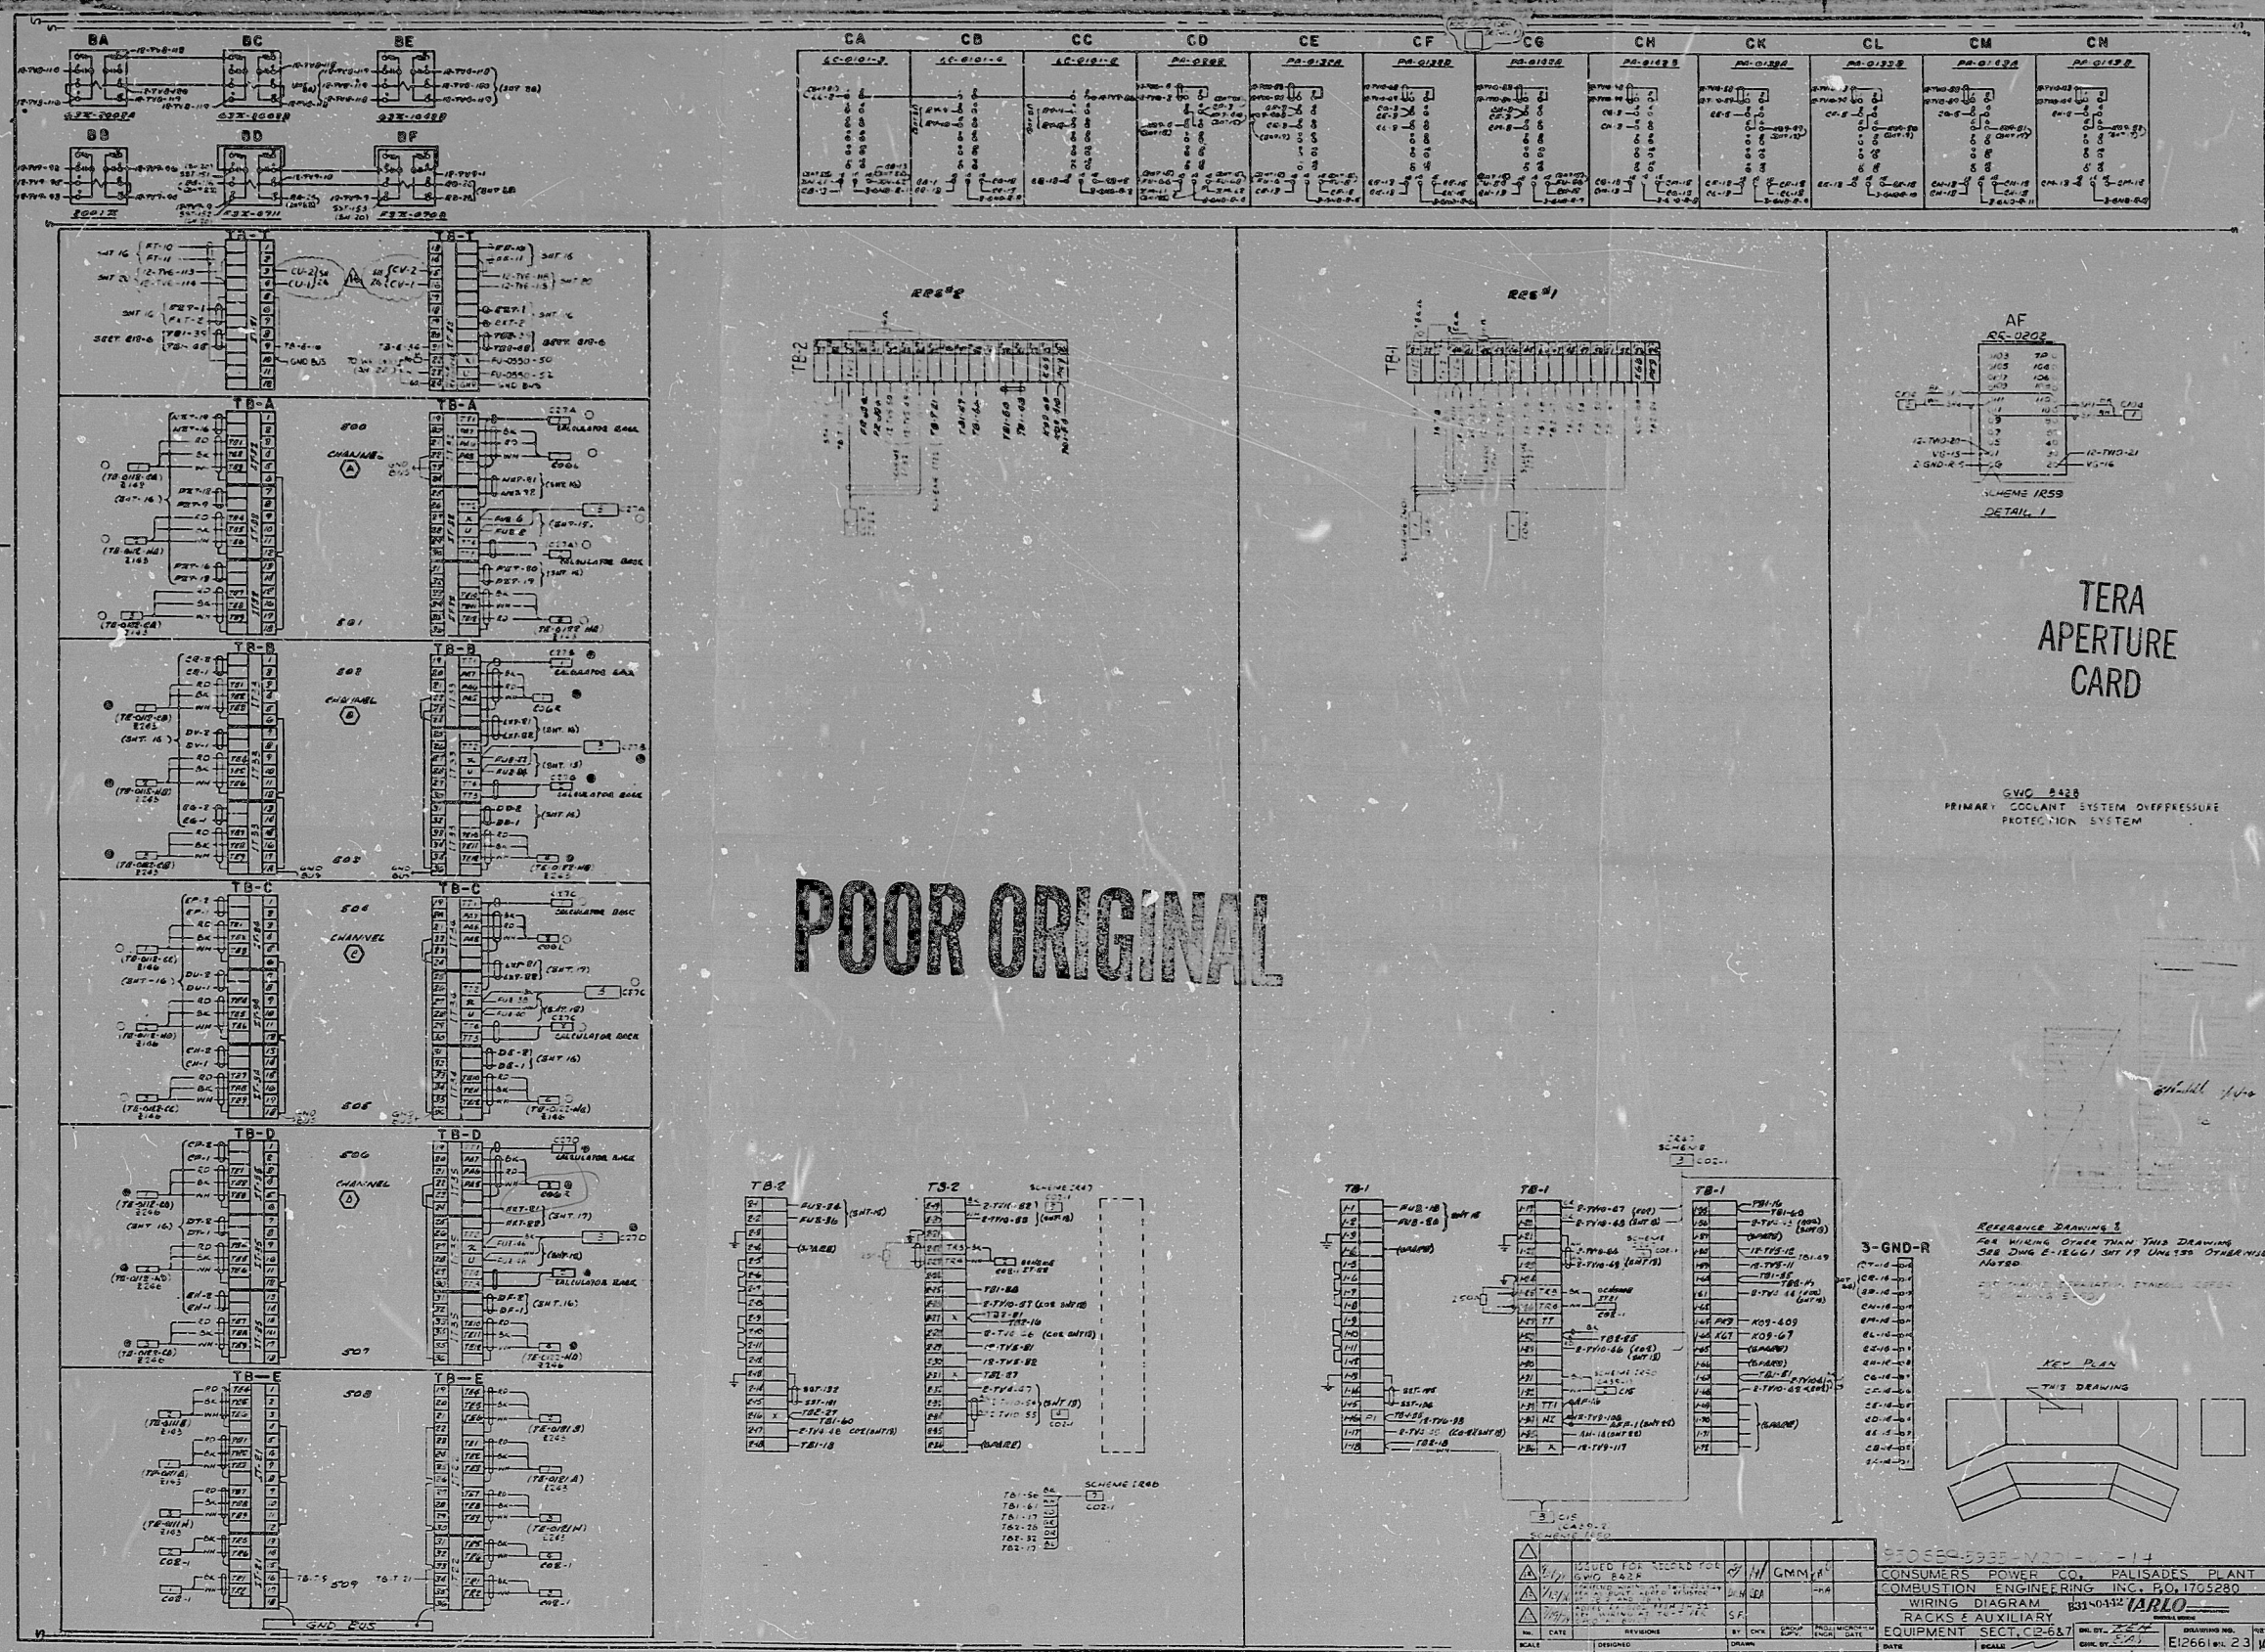


POOR ORIGINAL

TERA
APERTURE
CARD

PRIMARY COOLANT SYSTEM OVERPRESSURE
PROTECTION SYSTEM

REFERENCE DRAWING 3

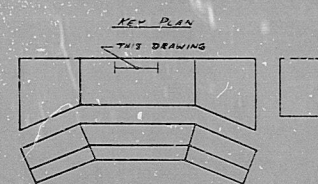

DATE	REVISION	BY	CHK	APP	DATE	SCALE	DESIGNED	DRAWN	DATE	SCALE	EQUIPMENT	SECT	CR-6-7	REV

8105180473

SEP

8106180473

