



TYPICAL CONDUIT INSTALLATION FOR VALVE SOLENOID & LIMIT SWITCH.

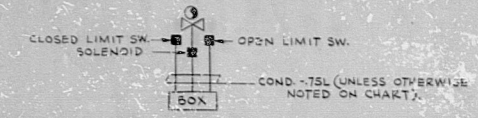

VALVE	BOX	SOLENOID NO.	LIMIT SW. NO.
TYPE	NO.	CND. NO.	CND. NO. (OPEN) CND. NO. (CLOSED)

- NOTES:
- FOR LEGEND, NOTES, REFERENCES, AND STANDARD DETAILS, SEE DWG. D-215-001.
 - CONDUITS CONTINUED UP, SEE DWG. D-215-043.
 - CONDUITS CONTINUED DOWN, SEE DWG. D-215-022.

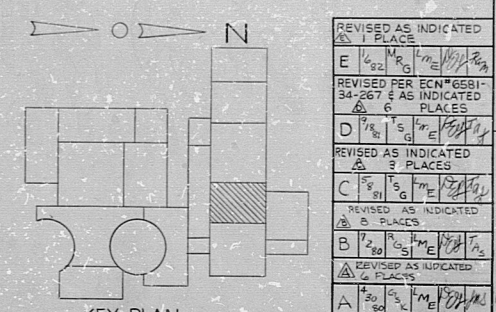

NUCLEAR SAFETY RELATED REVISIONS

NO.	DATE	DESCRIPTION	BY	CHKD.
2		LIMITED CONSTRUCTION: AS NOTED		
3		PRELIMINARY NOT FOR CONSTRUCTION		
4		BIDDING PURPOSES		

DATE	RELEASED FOR	ENGR.
	THE CLEVELAND ELECTRIC ILLUMINATING COMPANY	
	PERRY NUCLEAR POWER PLANT	UNIT 1
	ELECTRICAL	
	CONDUIT LAYOUT	
READING	TURBINE BUILDING EL. 624'-0"	
PA.	GILBERT ASSOCIATES, INC.	
DR.	ENGINEERS AND CONSULTANTS	
DATE	04/79	
SCALE	1/8" = 1'-0"	
NO.	04	4549
REV.	D-215-033	E
NO.	04549-000	DRAWING NUMBER
REV.		

P/C APERTURE CARD

82.2080518

RIDS

