


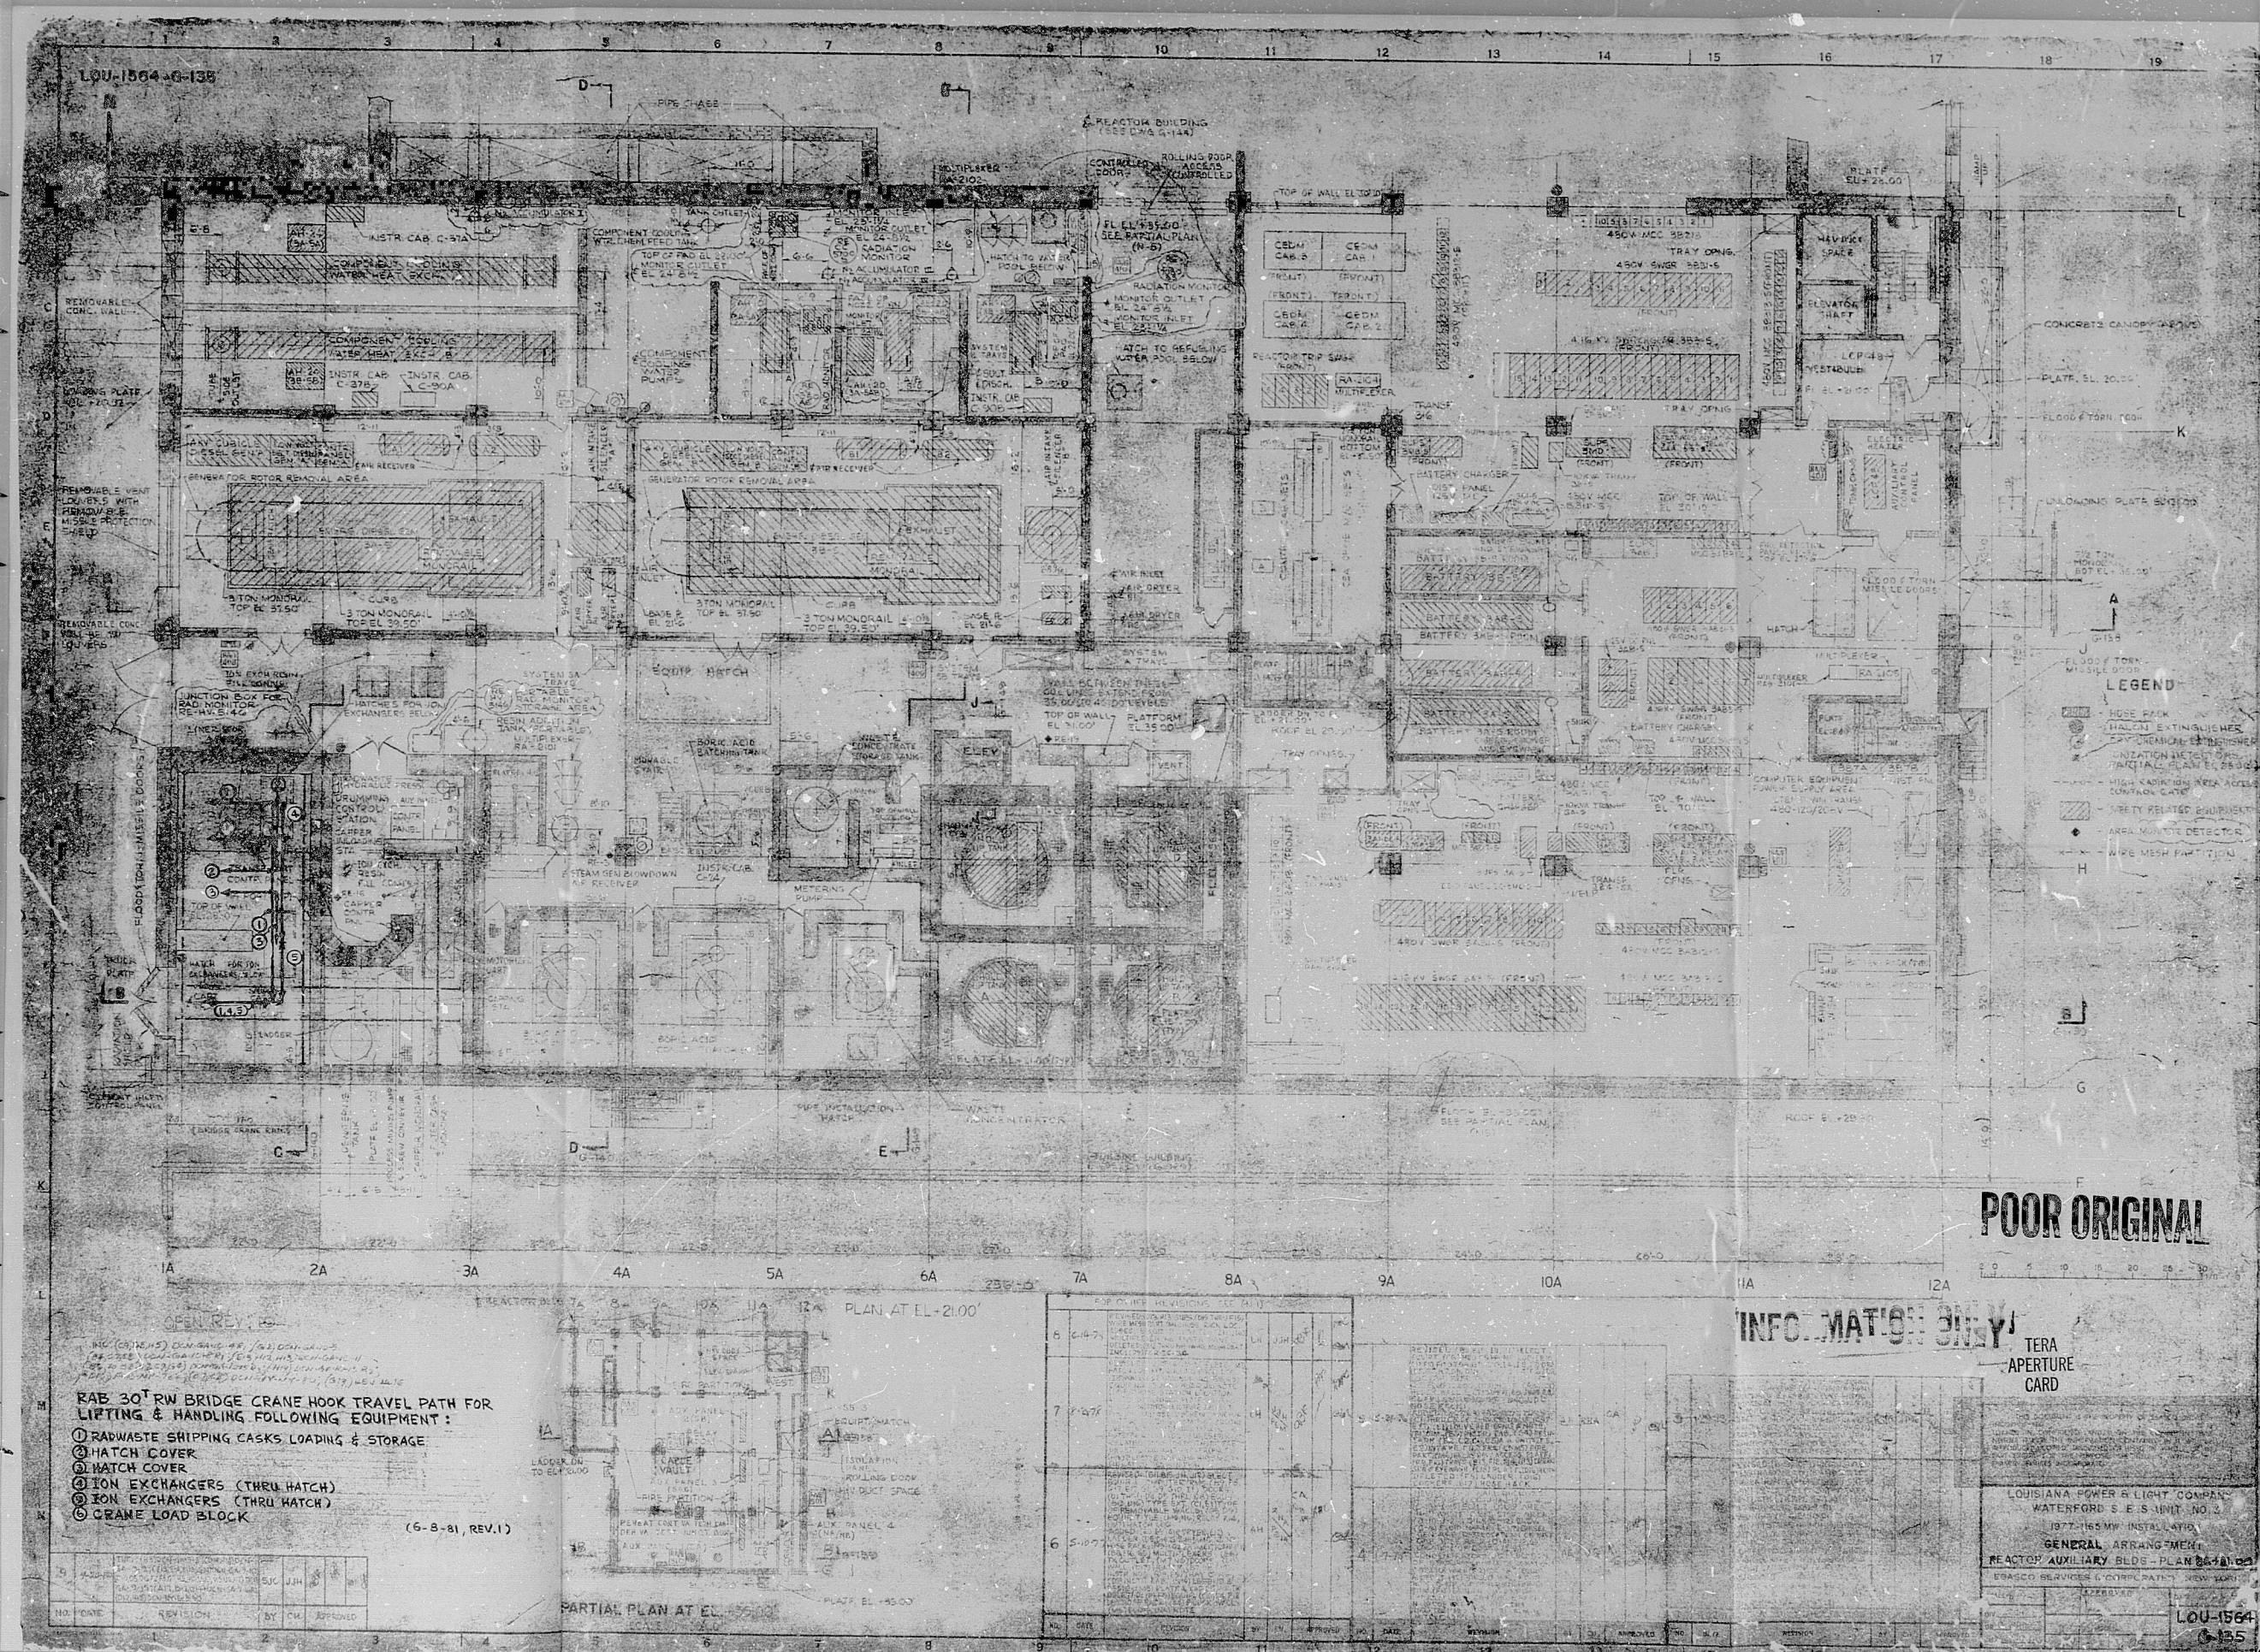

RAB 30' RW BRIDGE CRANE HOOK TRAVEL PATH FOR LIFTING & HANDLING FOLLOWING EQUIPMENT:

- ① RADWASTE SHIPPING CASKS LOADING & STORAGE
- ② HATCH COVER
- ③ HATCH COVER
- ④ ION EXCHANGERS (THRU HATCH)
- ⑤ ION EXCHANGERS (THRU HATCH)
- ⑥ CRANE LOAD BLOCK

(5-8-81, REV.1)

POOR ORIGINAL

INFO. MAT. ONLY
TERA
APERTURE
CARD

LOUISIANA POWER & LIGHT COMPANY
WATERFORD S.E. UNIT, NO. 2
1977-1985 MP INSTALLATION
GENERAL ARRANGEMENT
REACTOR AUXILIARY BLDG - PLAN 21.00
BRASCO SERVICES CORPORATION, NEW YORK

LOU-1564
G-155
1100000724

R.O.

8106230424

