

34"

34"

22"

22"

17"

17"

11"

11"

8.5"

8.5"

8.5"

8.5"

11"

11"

17"


17"

22"

22"

34"

34"

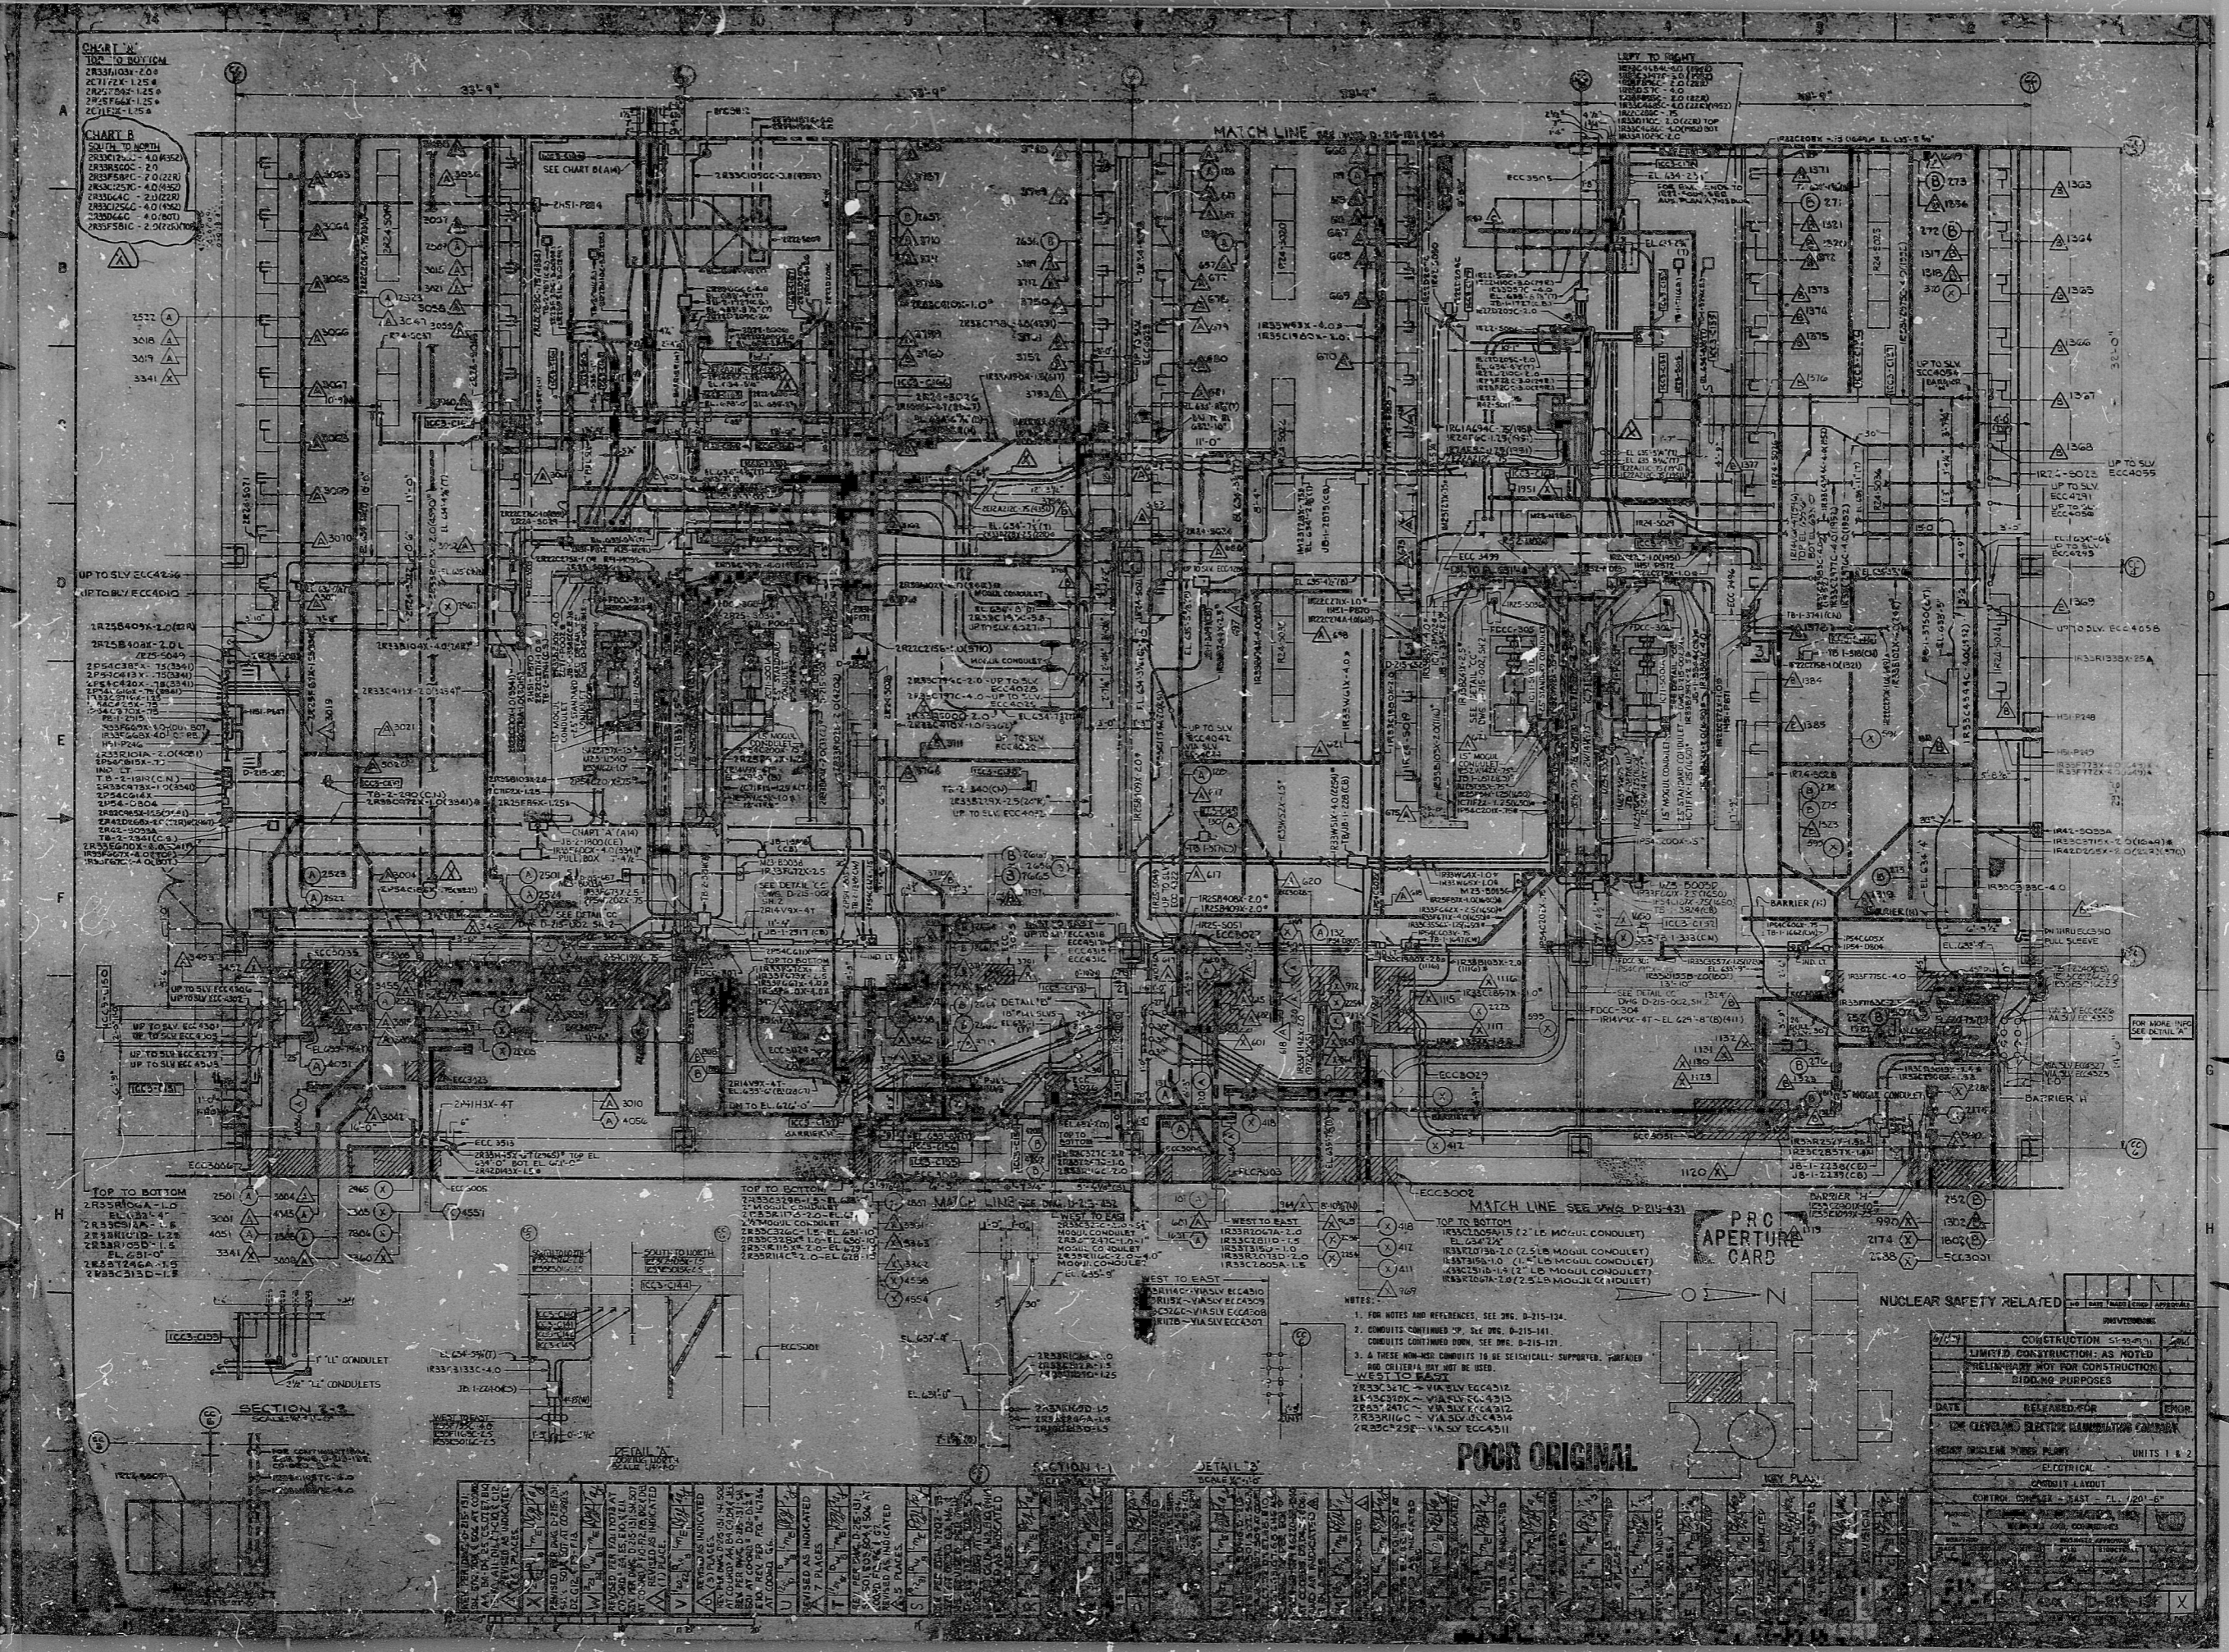



82.2080624

Rids

