


34
22
11
11
98
6.5
11
17
22

34
22
11
11
98
6.5
11
17
22

- NOTES:
1. FOR LEGEND, NOTES, REFERENCES, AND STANDARD DETAILS, SEE DWG. D-215-411.
 2. THESE NON-NUCLEAR SAFETY RELATED CONDUITS TO BE SEISMICALLY SUPPORTED. THREADED ROD CRITERIA MAY NOT BE USED.

PRC APERTURE CARD

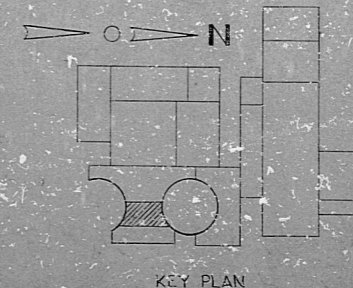




NUCLEAR SAFETY RELATED	
CONSTRUCTION	DATE
LIMITED CONSTRUCTION - AS NOTED	04/28/88
PRELIMINARY NOT FOR CONSTRUCTION BIDDING PURPOSES	
DATE	RELEASED FOR ENGR.
04/28/88	
THE CLEVELAND ELECTRIC ILLUMINATING COMPANY	
PERRY NUCLEAR POWER PLANT UNITS 1 & 2	
ELECTRICAL CONDUIT LAYOUT	
FUEL HANDLING AREA - WEST - EL. 574'-10"	
NUMBER	DATE
4849	04/28/88
GILBERT ASSOCIATES, INC.	
ENGINEERS AND CONSULTANTS	
DESIGNED BY	APPROVED BY
W.A.	J.B.
CHECKED BY	DATE
J.B.	04/28/88
DRAWING NUMBER	
D-215-414 L	

CND LYT P/A WEST EL 574-10

RIDS

8212100163

