


34


34

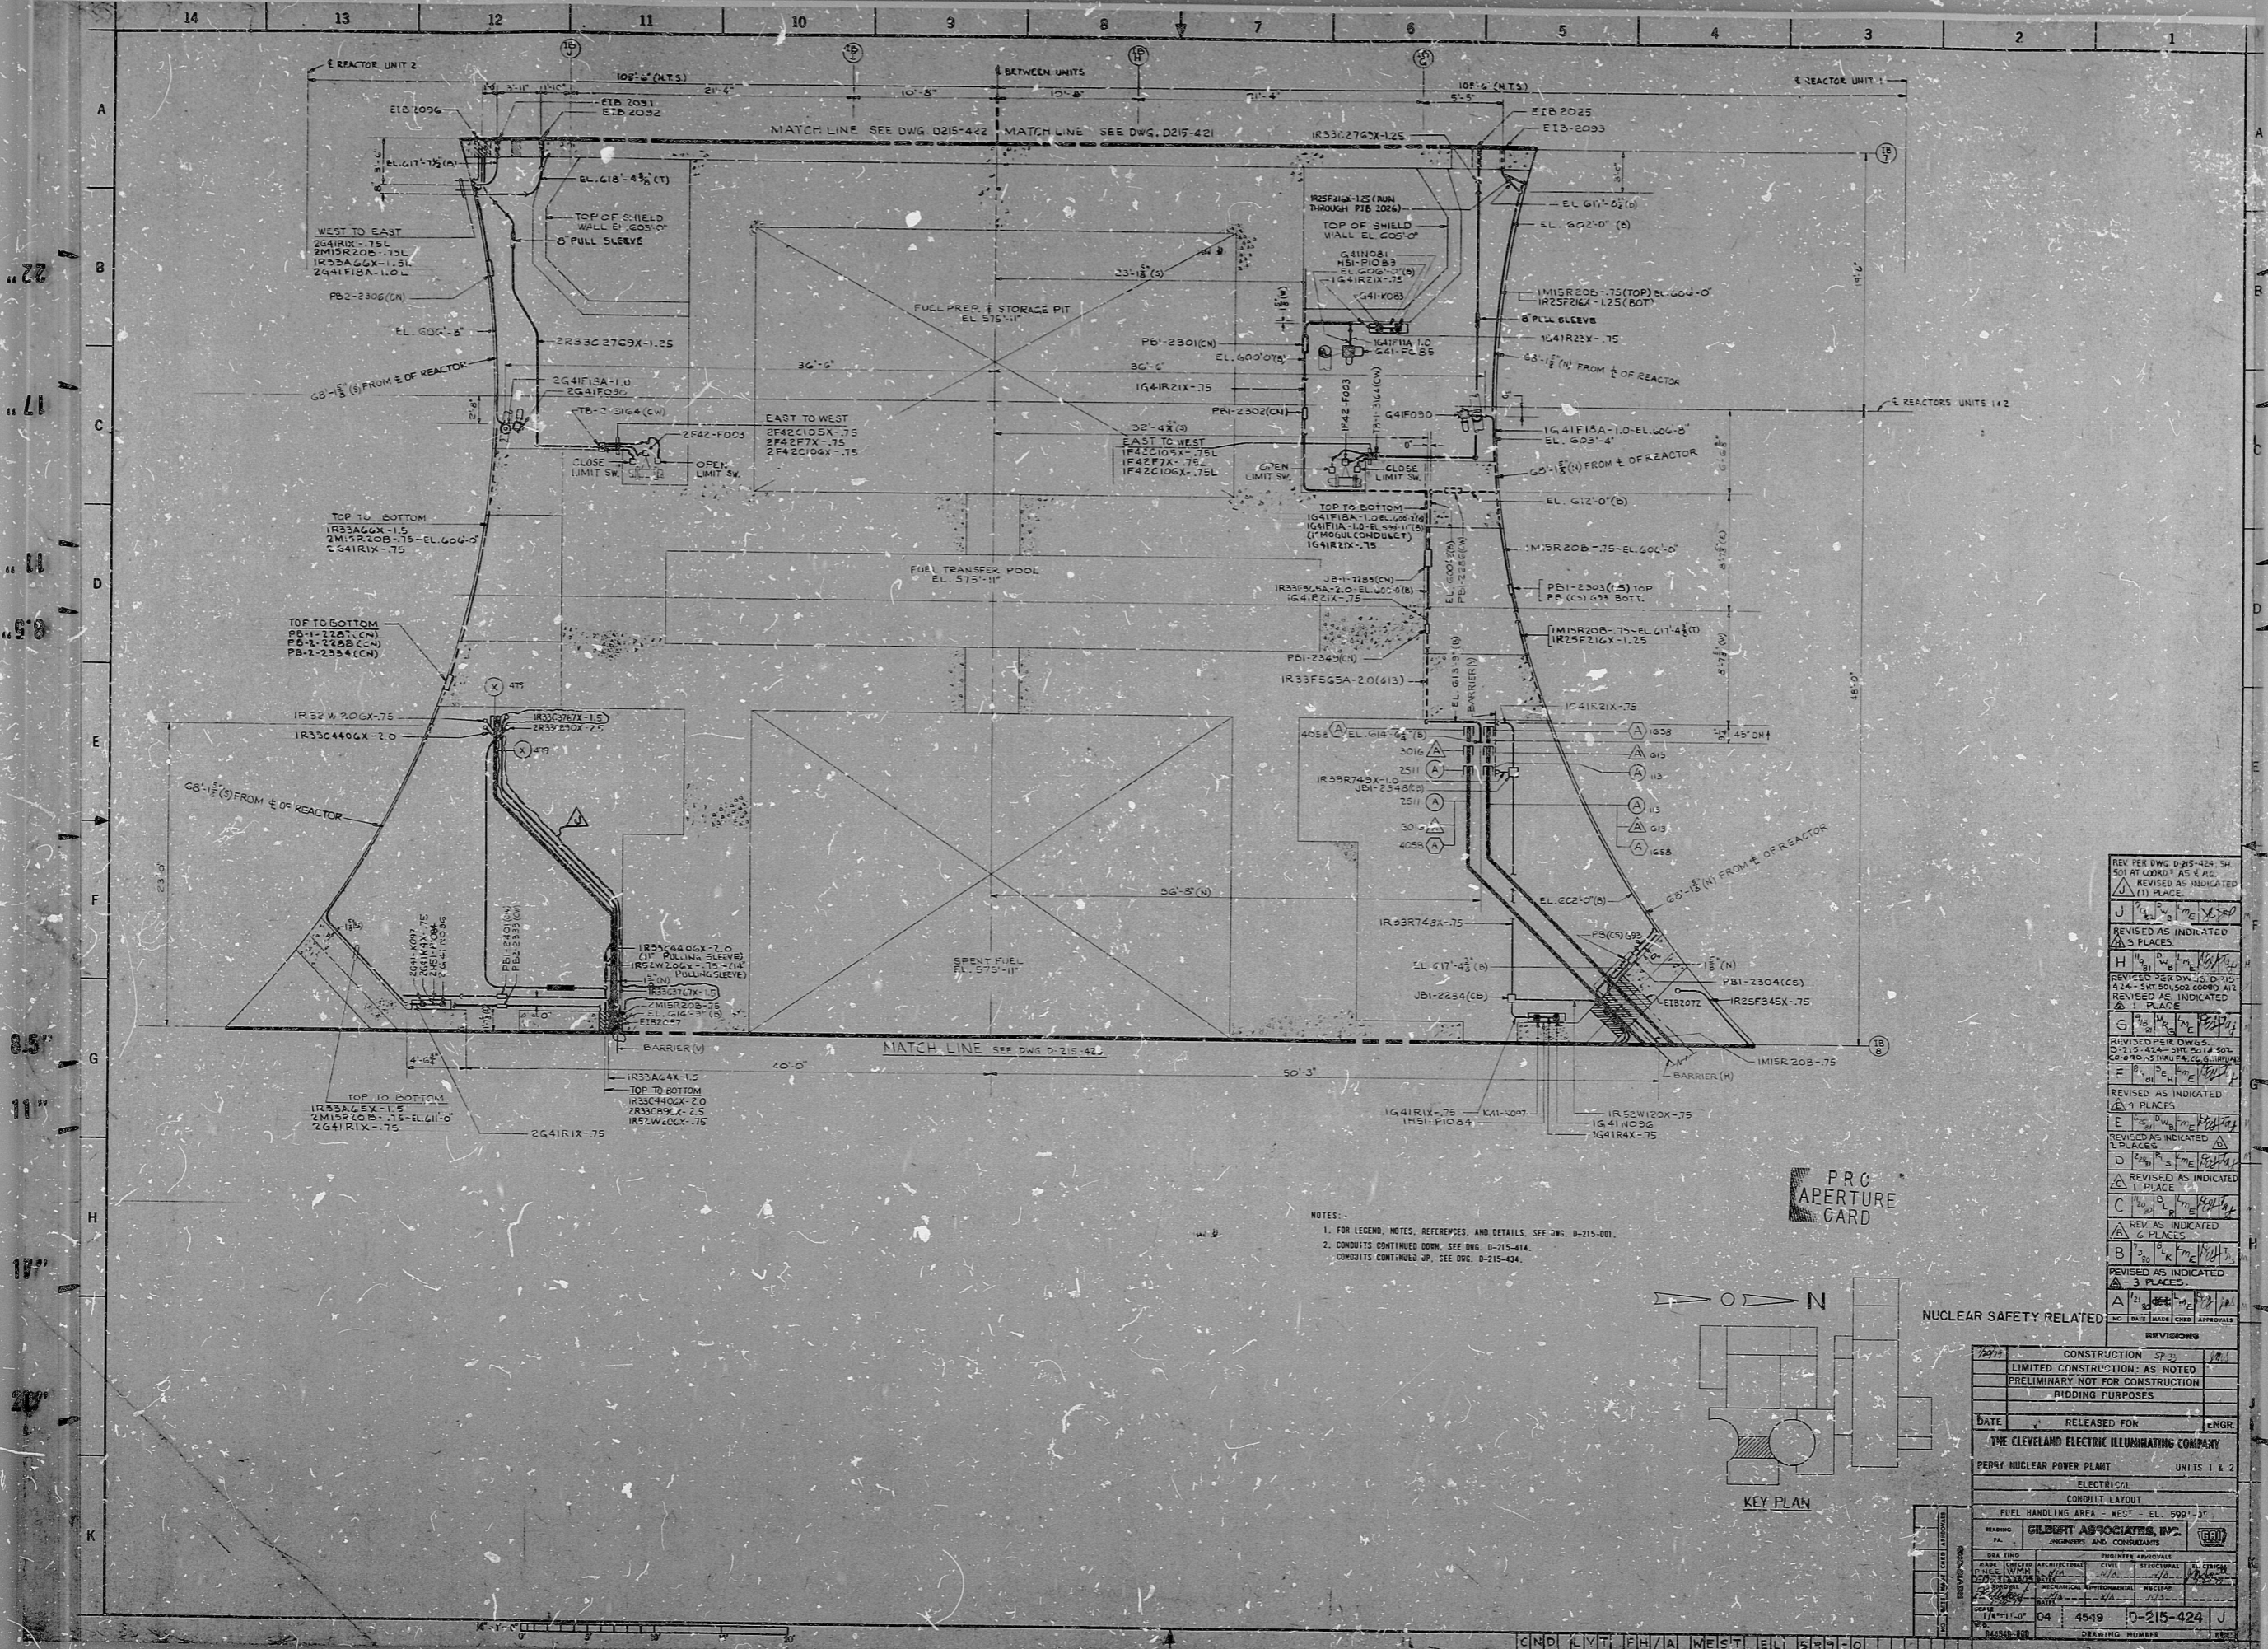

REV	BY	DATE	DESCRIPTION
NOTES:
 1. FOR LEGEND, NOTES, REFERENCES, AND DETAILS, SEE DWG. D-215-001.
 2. CONDUITS CONTINUED DOWN, SEE DWG. D-215-414.
 3. CONDUITS CONTINUED UP, SEE DWG. D-215-434.

PRG
 APERTURE
 GARD

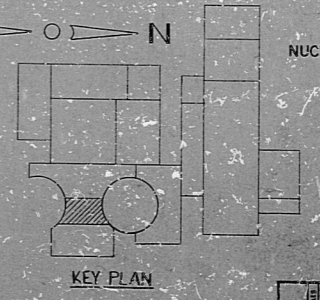

REVISIONS	
1/2/75	CONSTRUCTION 57-31
LIMITED CONSTRUCTION AS NOTED. PRELIMINARY NOT FOR CONSTRUCTION RIDDING PURPOSES.	
DATE	RELEASED FOR ENGR.
THE CLEVELAND ELECTRIC ILLUMINATING COMPANY	
PEPPI NUCLEAR POWER PLANT UNITS 1 & 2	
ELECTRICAL	
CONDUIT LAYOUT	
FUEL HANDLING AREA - WEST - EL. 599'-0"	
DESIGNED BY	GILBERT ASSOCIATES, INC.
CHECKED BY	ENGINEER AND CONSULTANT
DATE	10/20/75
SCALE	AS SHOWN
PROJECT NO.	04 4549 D-215-424 J
DRAWING NO.	04 4549 D-215-424 J

34

34

8212100173

RIDS

