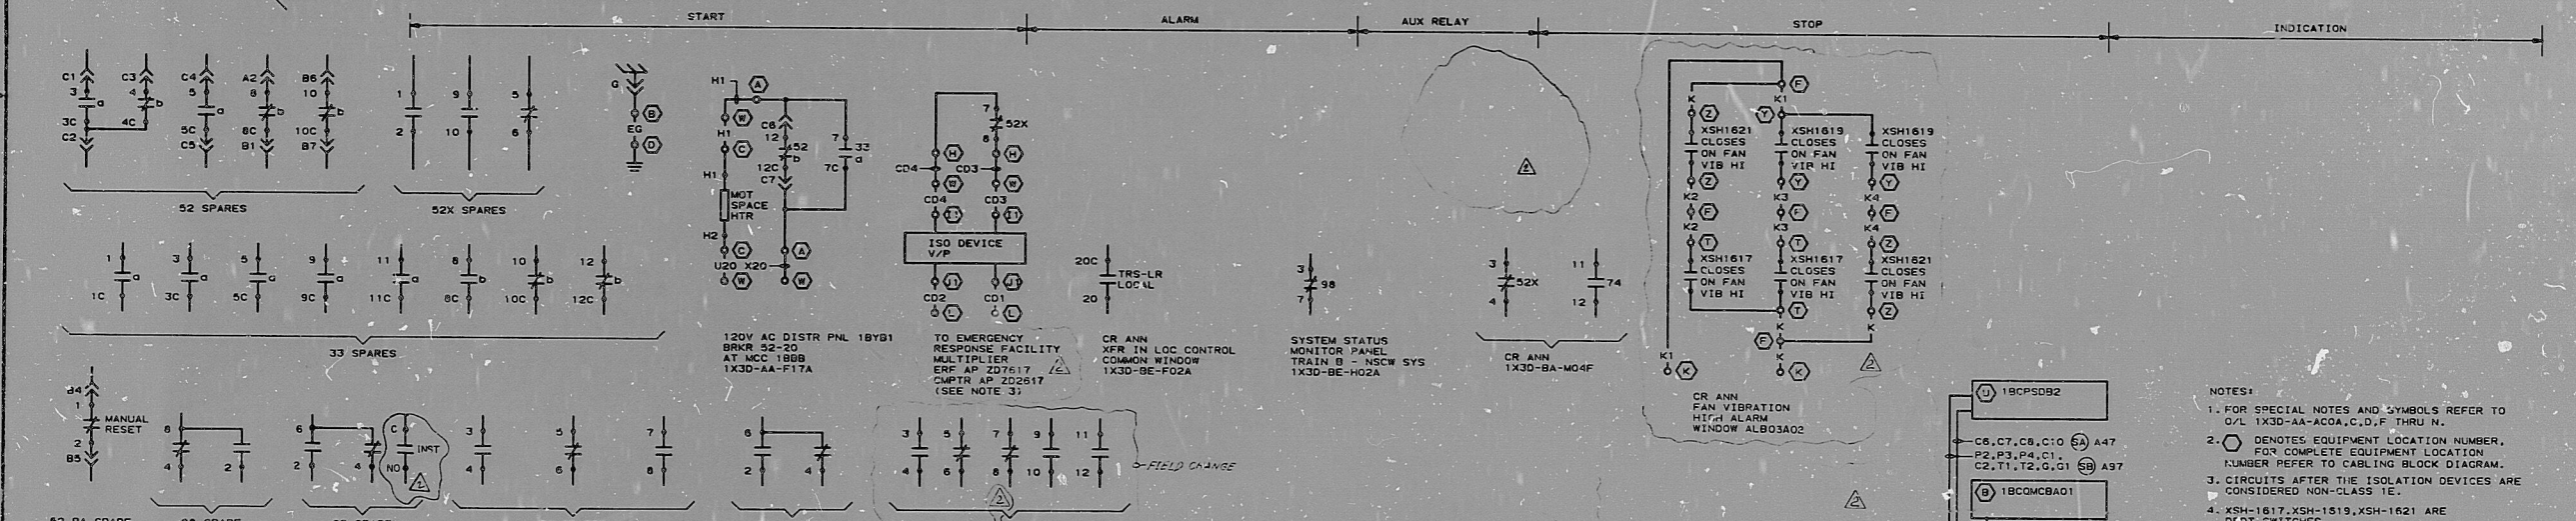
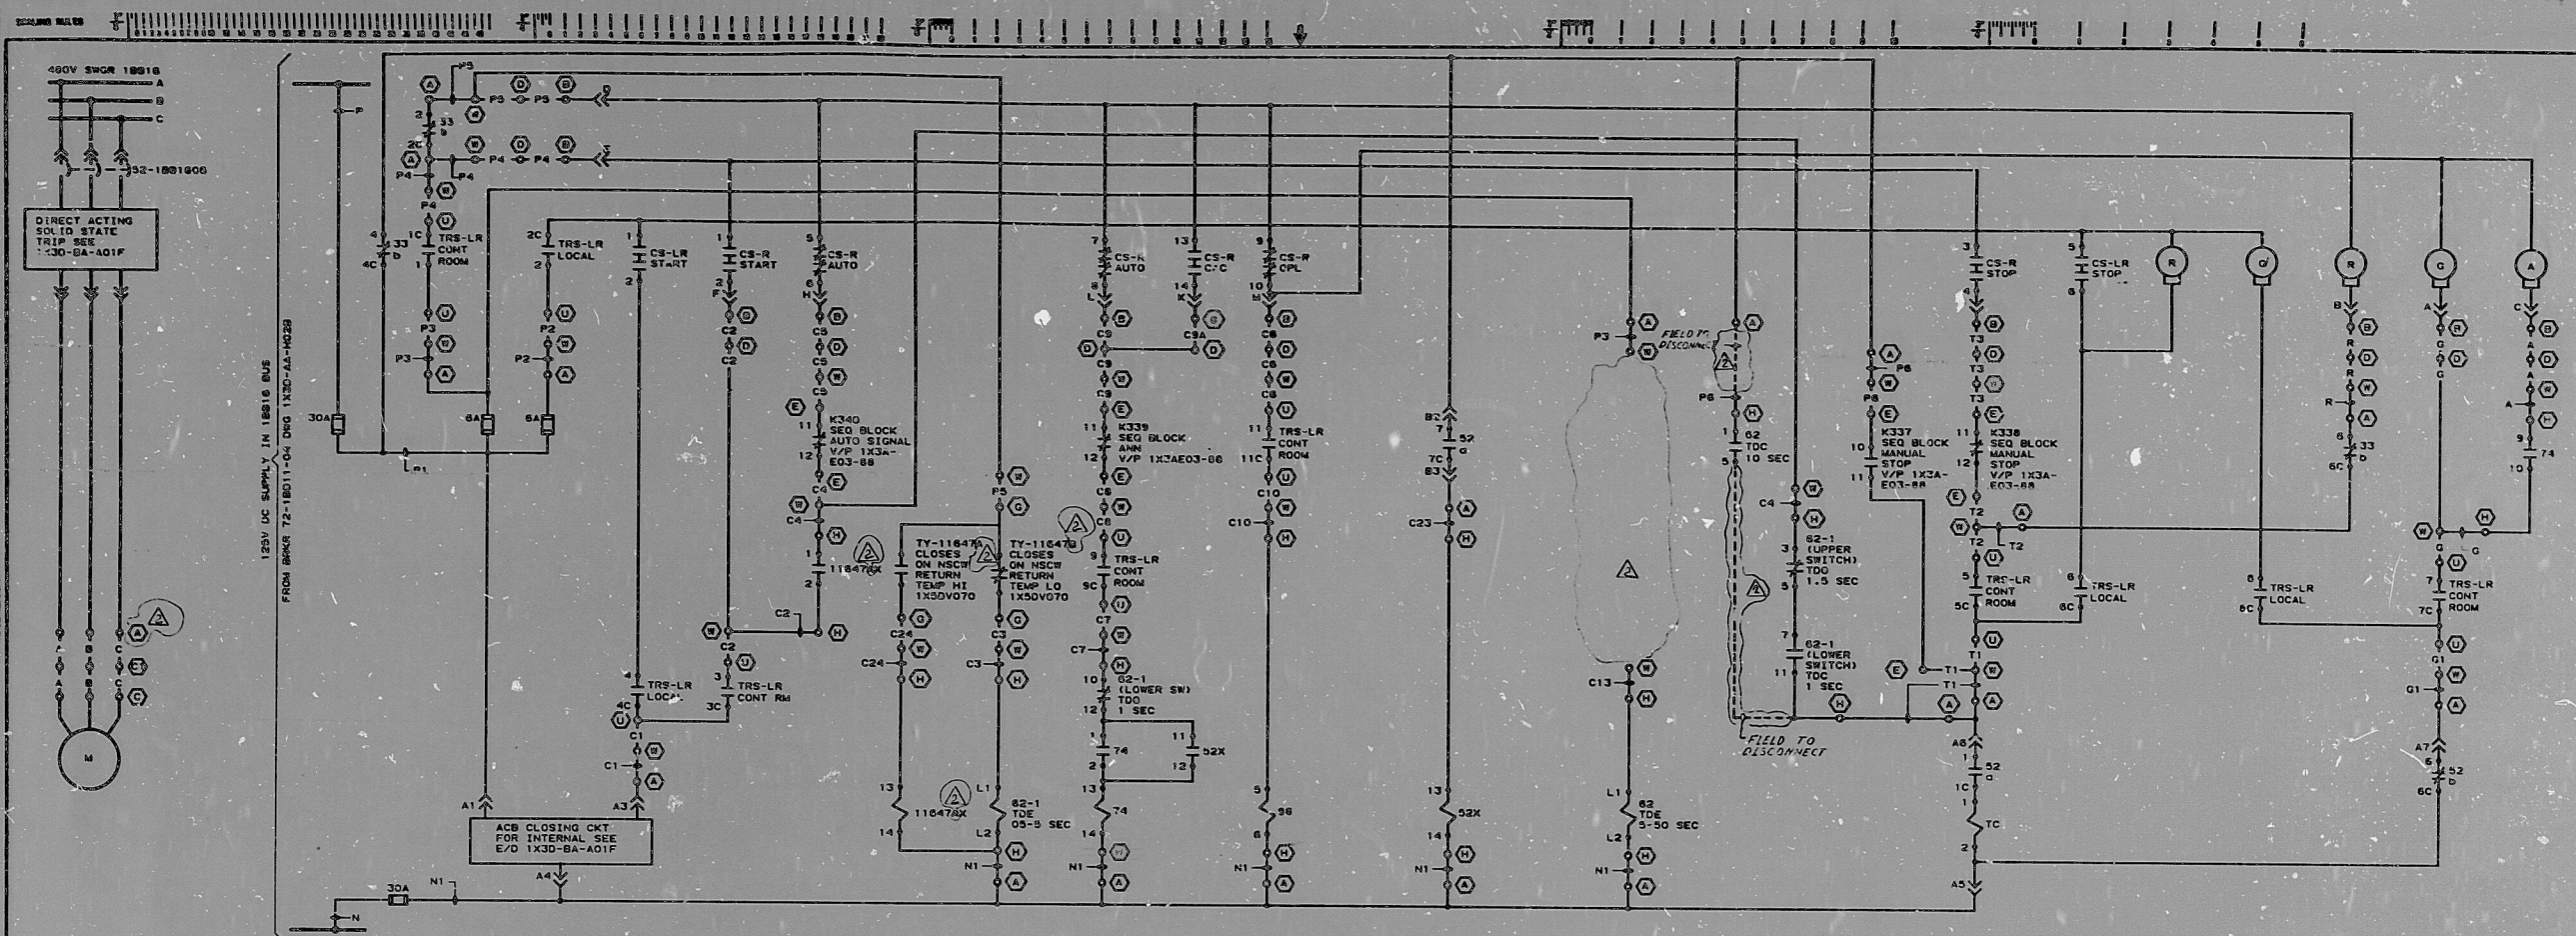


DEVICE	MFR	TYPE	MODEL NO	NUMBER	REFERENCE DWGS	REV
96	GE	MMA	12MA1185	1X40B133-1	P & I DIAGRAM	—
74	GE	HFA	12HFA144PH	1X3D-AA-17A	ONE LINE DIAGRAM	—
62	AGAST	ET000	E7012POL	1X3DNOB3-1-C	LOGIC DIAGRAM	—
52X	GE	HFA	12HFA1A42H	—	—	—
62-1	AGAST	ET000	E7014PB	—	—	—
1842AN	GE	HFA	12HFA1A42H	—	—	—

REV	NO	DATE	DR	CHK	SUPV	EGS	CHK	P.E.	DATE	NO

PRC
APERTURE
CARD

NUCLEAR SAFETY RELATED

NUCLEAR SERVICE COOLING TWR FAN MOTOR
BECHTEL
LOS ANGELES
GEORGIA POWER COMPANY
ALVIN W. VOGTLE NUCLEAR PLANT

ELEMENTARY DIAGRAM
NUCLEAR SERVICE COOLING WATER SYSTEM
1-1202-W4-002-M02

SCALE: NONE
DRAWING NO. 1X3D-BO-K03F
REV. 2

RIDS

8310030273

