

34

34

22

22

17

17

11

11

5.8

5.8

8.5

8.5

11

11


17

17

22

22

34

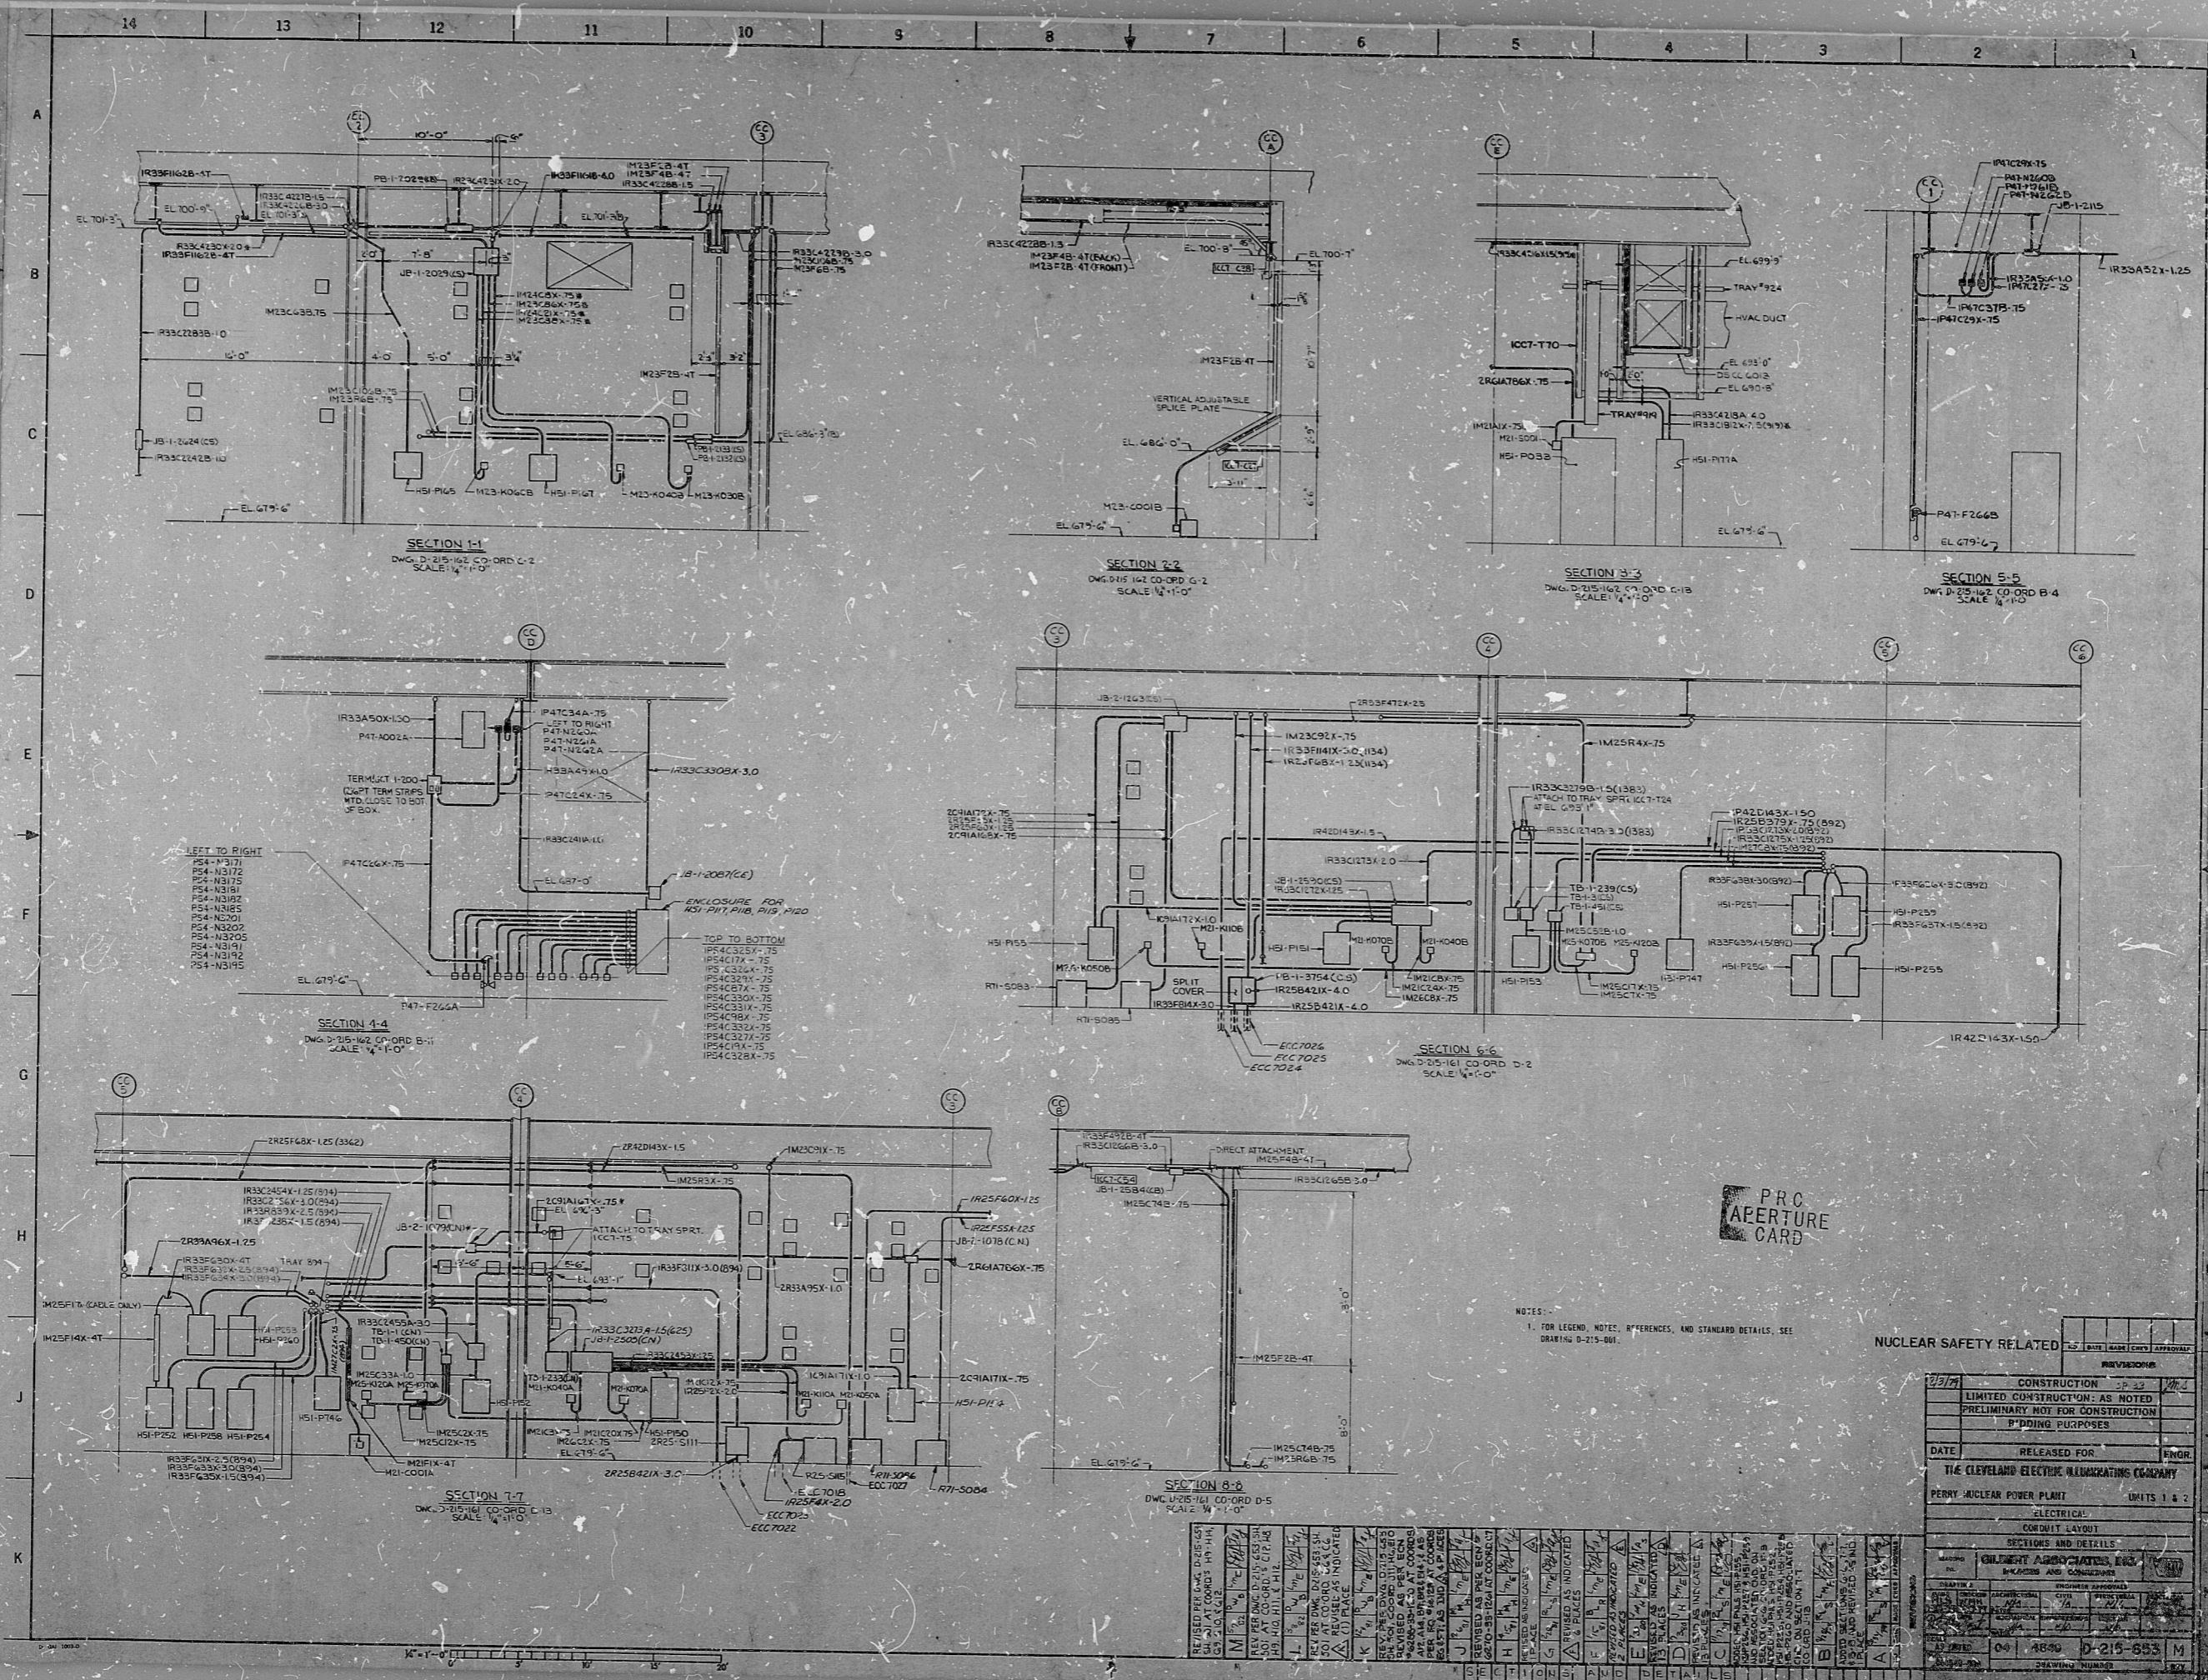

PRO APERTURE CARD

NOTES:
1. FOR LEGEND, NOTES, REFERENCES, AND STANDARD DETAILS, SEE DRAWING D-215-861.

| | | | |
|---|--------------|---------------------------------------|--------------|
| NUCLEAR SAFETY RELATED | | DESIGN APPROVAL | CONSTRUCTION |
| DATE | RELEASED FOR | ENGR. | DATE |
| THE CLEVELAND ELECTRIC ILLUMINATING COMPANY | | PERRY NUCLEAR POWER PLANT UNITS 1 & 2 | |
| ELECTRICAL | | | |
| CORRIDOR LAYOUT | | | |
| SECTIONS AND DETAILS | | | |
| REVISIONS | | | |
| NO. | DATE | BY | DESCRIPTION |
| 1 | | | |
| 2 | | | |
RIDS

8212100320

