



14 13 12 11 10 9 8 7 6 5 4 3 2 1






A B C D E F G H I J K

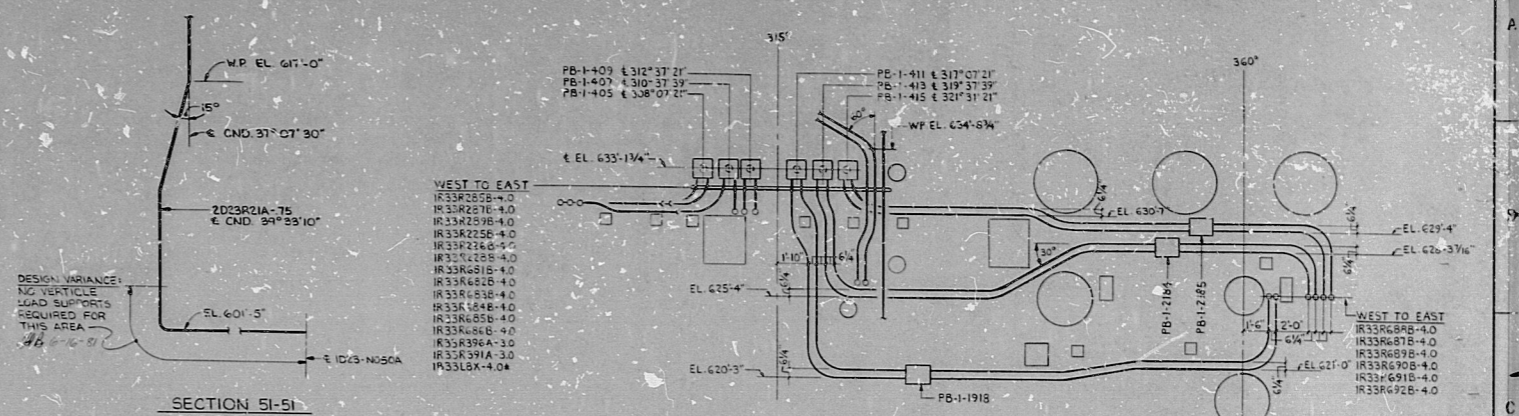

TYPICAL CONDUIT INSTALLATION FOR VALVE SOLENOID & LIMIT SWITCHES.

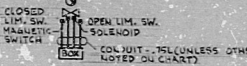

VALVE	BOX	SOLENOID No.	LIMIT SWITCH No.	MAGNETIC SWITCH	
TYPE	NO.	CND. LG.	CND. NO. (OPEN) / CND. NO. (CLOSED)	CND. NO.	

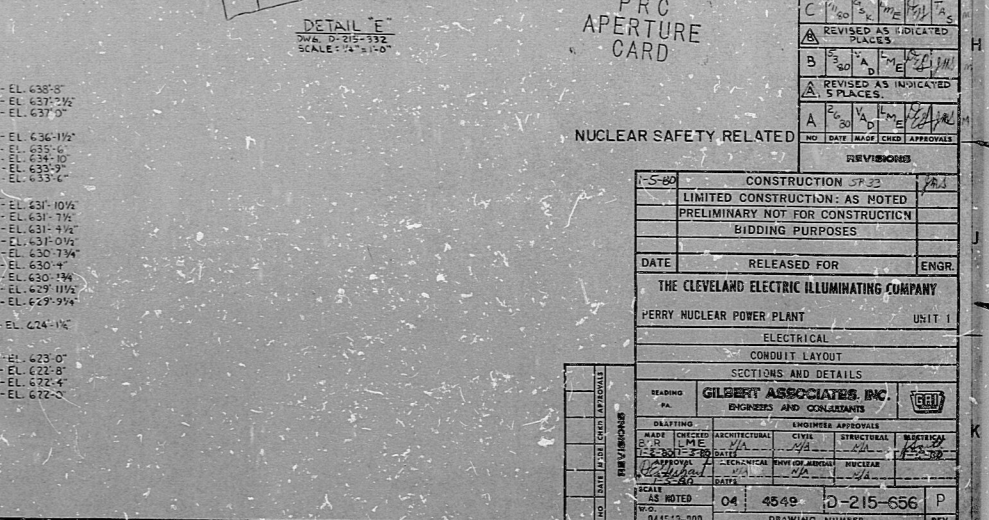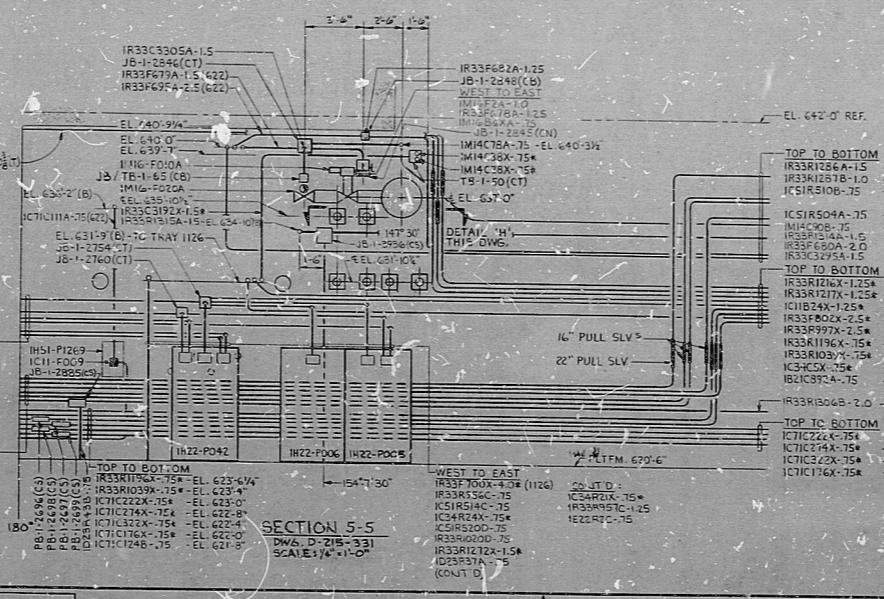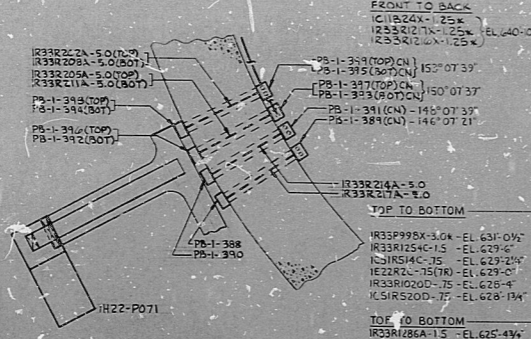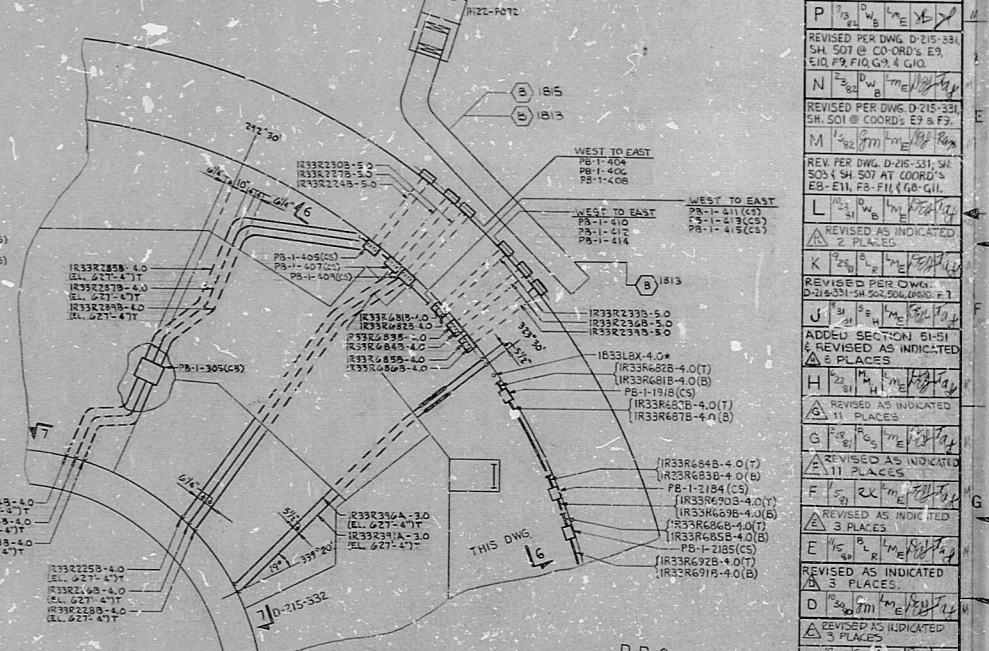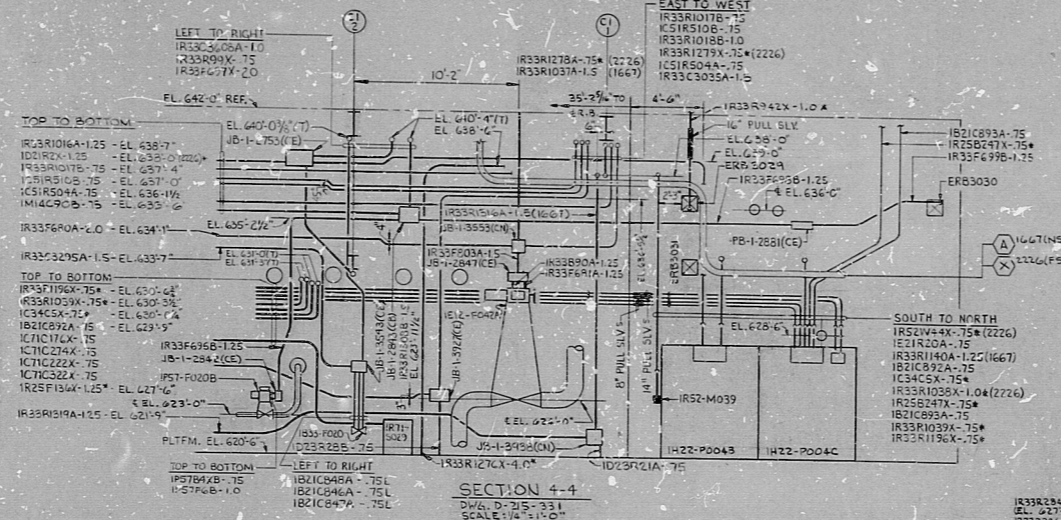

REV PER DWG. D-215-331, SH # 502, 503, 504, 1000.

DATE	RELEASED FOR	ENGR.
THE CLEVELAND ELECTRIC ILLUMINATING COMPANY		
PERRY NUCLEAR POWER PLANT UNIT 1		
ELECTRICAL		
CONDUIT LAYOUT		
SECTIONS AND DETAILS		
GILBERT ASSOCIATES, INC.		
REGISTERED PROFESSIONAL ENGINEERS AND CONSULTANTS		
DATE	BY	REV
04	4549	D-215-656
DRAWING NUMBER		

CND LAYOUT SECTIONS & DETAILS

RIDS

8212100323

