

34

34

22

22

17

17

11

11

9.5

9.5

8.5

8.5

11

11

17




17

22

22

34

34

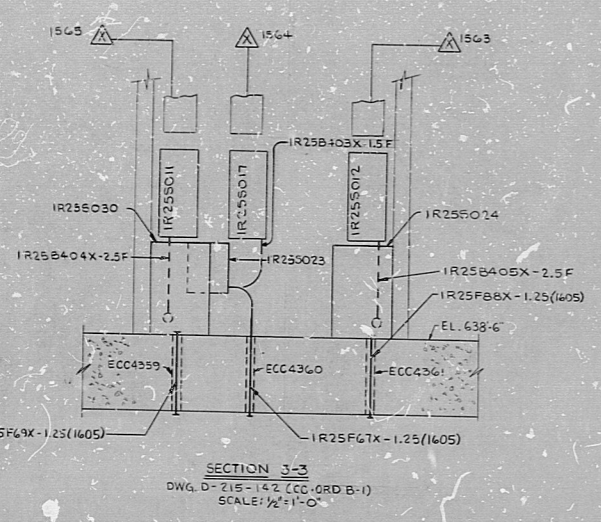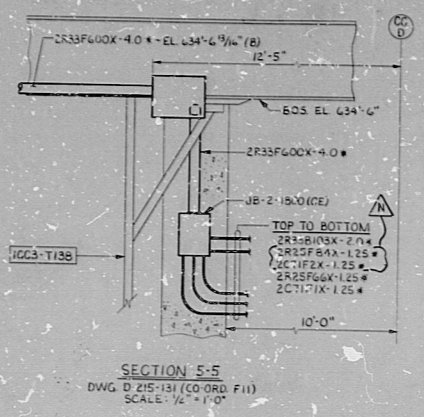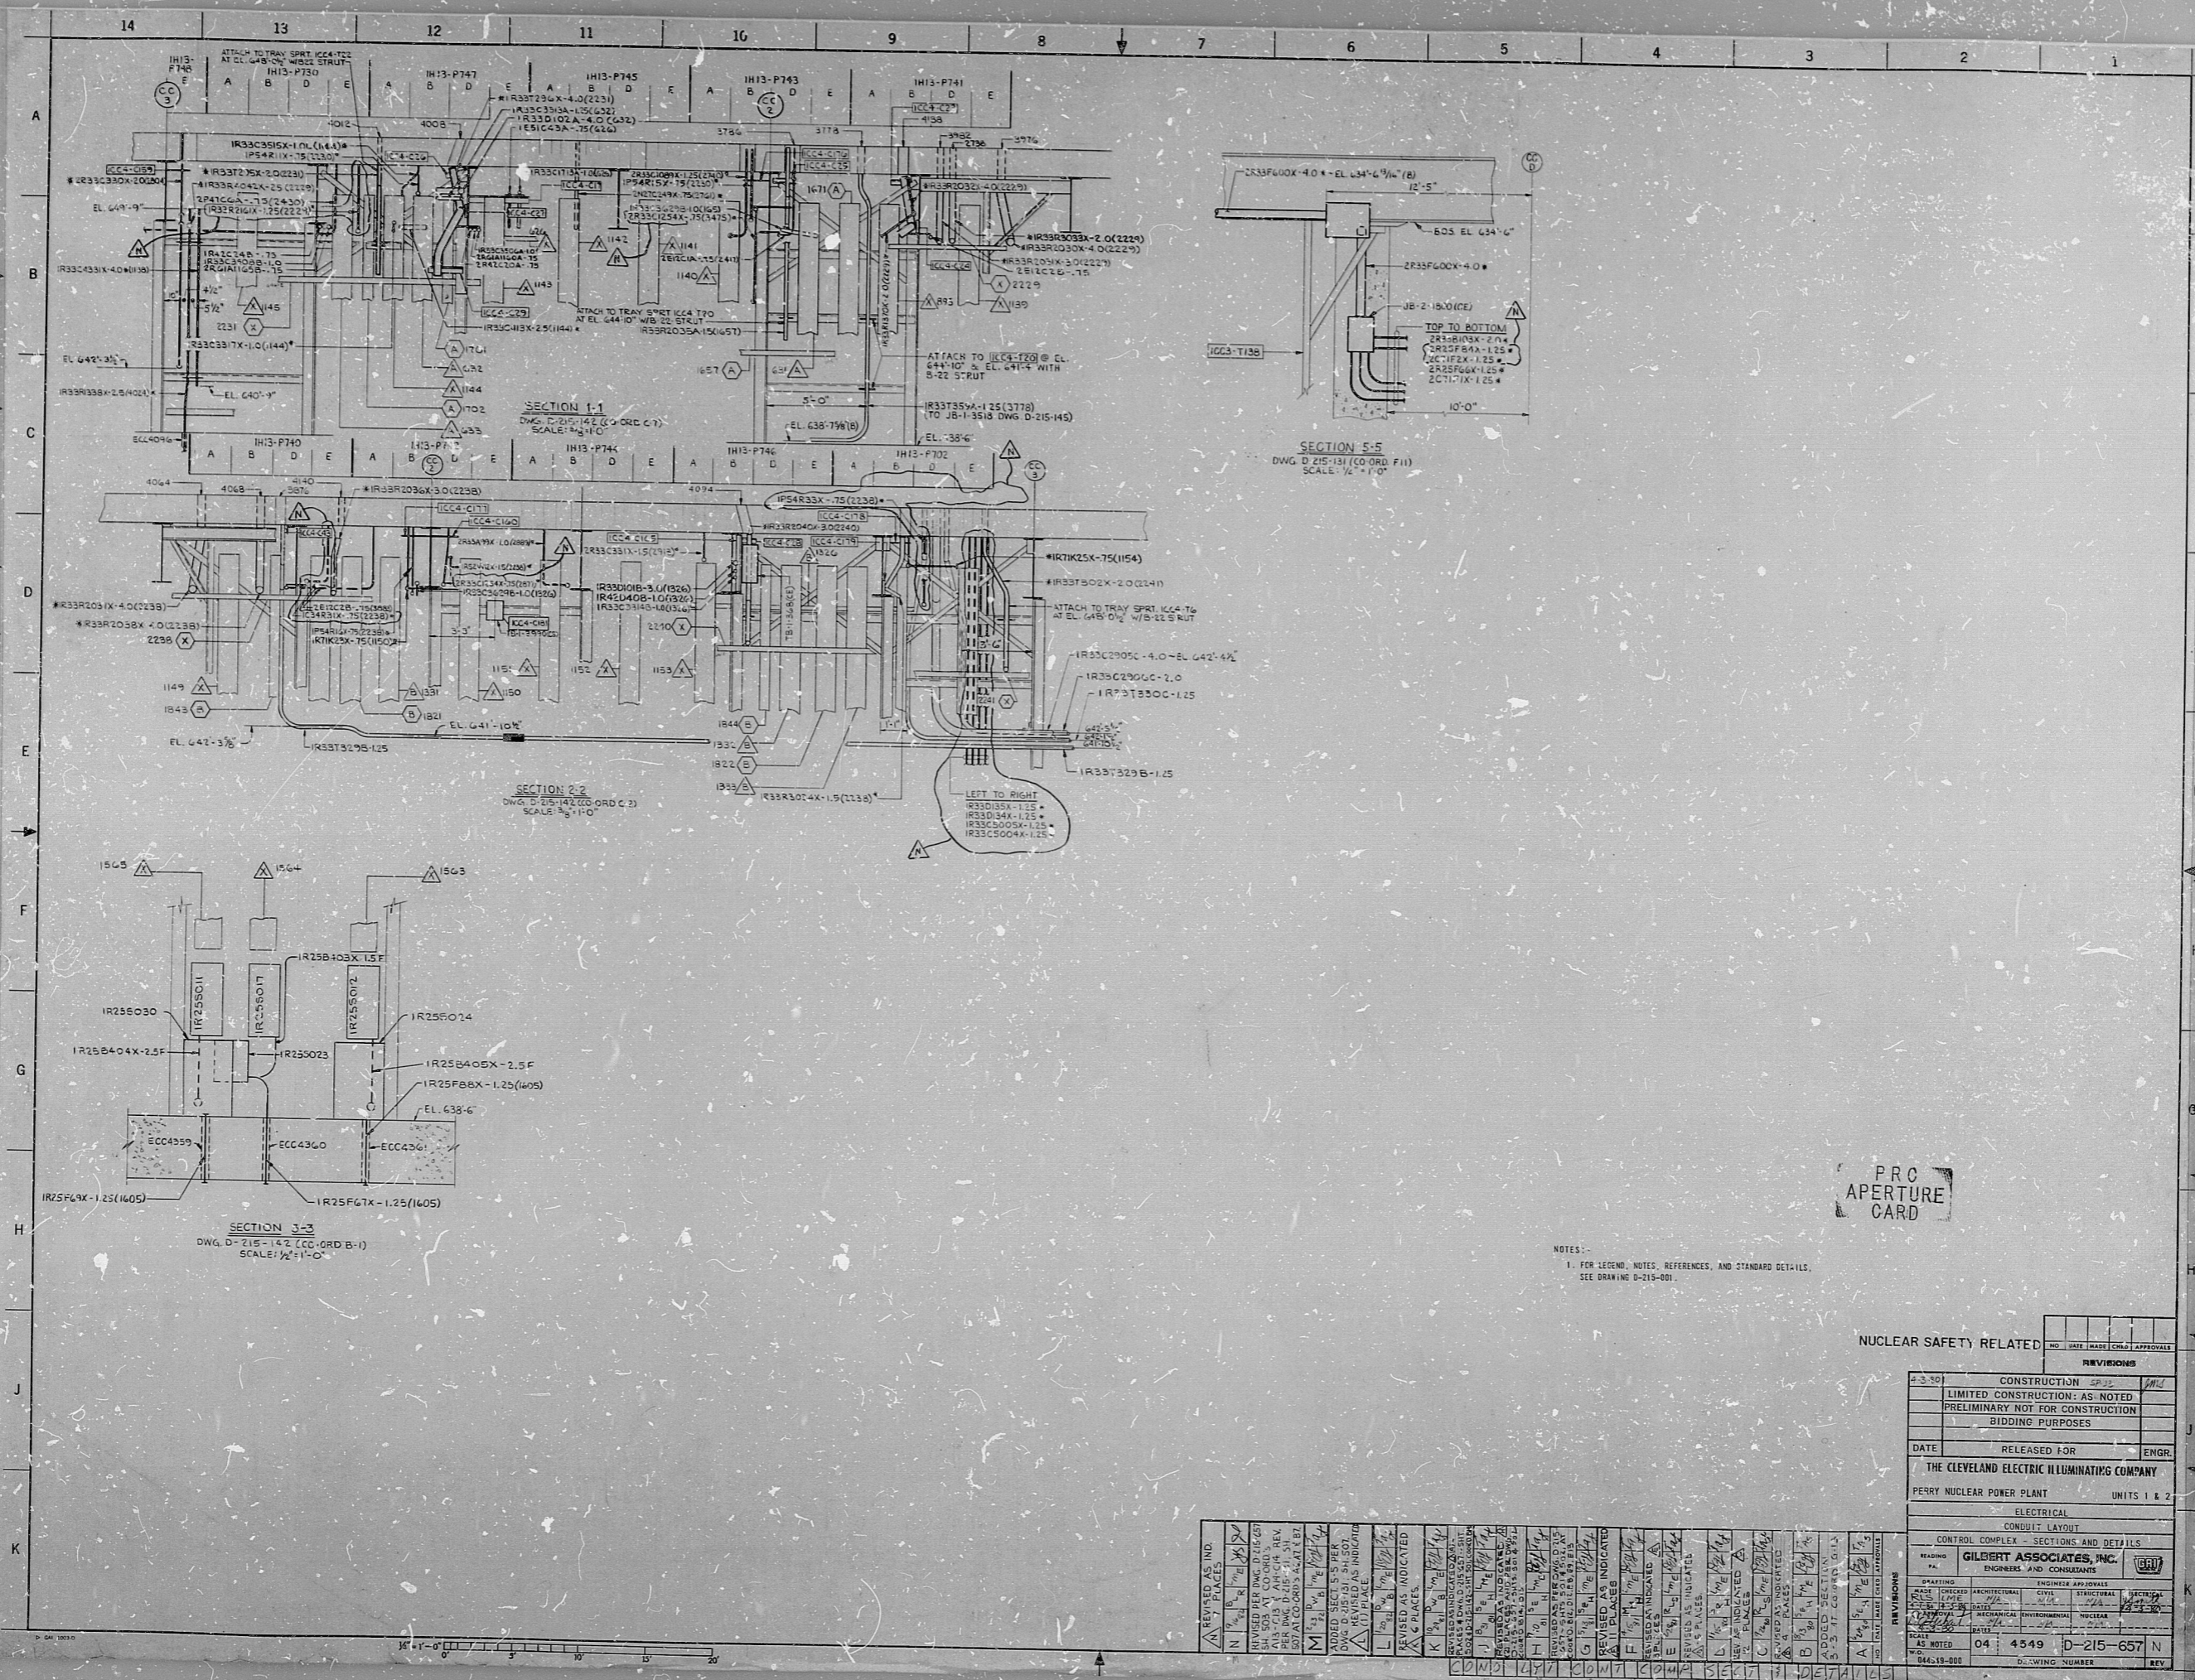

PRC APERTURE CARD

NOTES: 1. FOR LEGEND, NOTES, REFERENCES, AND STANDARD DET-115, SEE DRAWING D-215-001.

| REVISIONS | | NO. | DATE | BY | CHKD. | APPROVAL |
|-----------|----------------------------------|-----|------|-----------|-------|----------|
| 1 | CONSTRUCTION | 04 | 4549 | D-215-657 | N | |
| 2 | LIMITED CONSTRUCTION: AS NOTED | | | | | |
| 3 | PRELIMINARY NOT FOR CONSTRUCTION | | | | | |
| 4 | BIDDING PURPOSES | | | | | |

DATE: RELEASED FOR ENGR

THE CLEVELAND ELECTRIC ILLUMINATING COMPANY

PERRY NUCLEAR POWER PLANT UNITS 1 & 2

ELECTRICAL

CONDUIT LAYOUT

CONTROL COMPLEX - SECTIONS AND DETAILS

READING: GILBERT ASSOCIATES, INC. ENGINEERS AND CONSULTANTS

DATE: 04 4549 D-215-657 N

NO: 044-19-000 DRAWING NUMBER REV


RIDS

8212100326

