



14 13 12 11 10 9 8 7 6 5 4 3 2 1

A
B
C
D
E
F
G
H
J
K

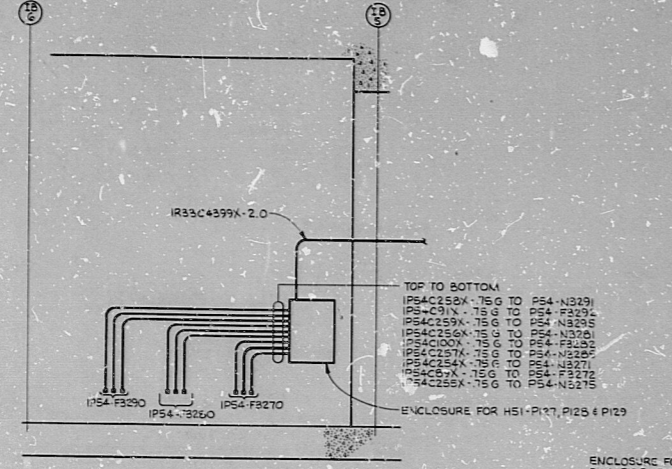

SECTION 2-2
D-215-471
SCALE: 1/4" = 1'-0"

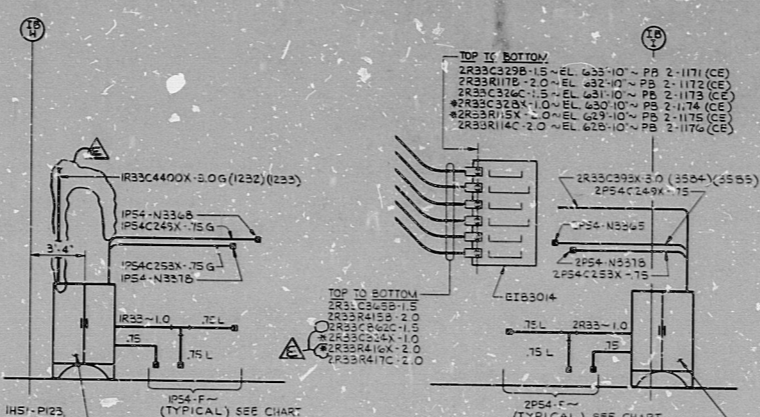


SECTION 6-6
D-215-481







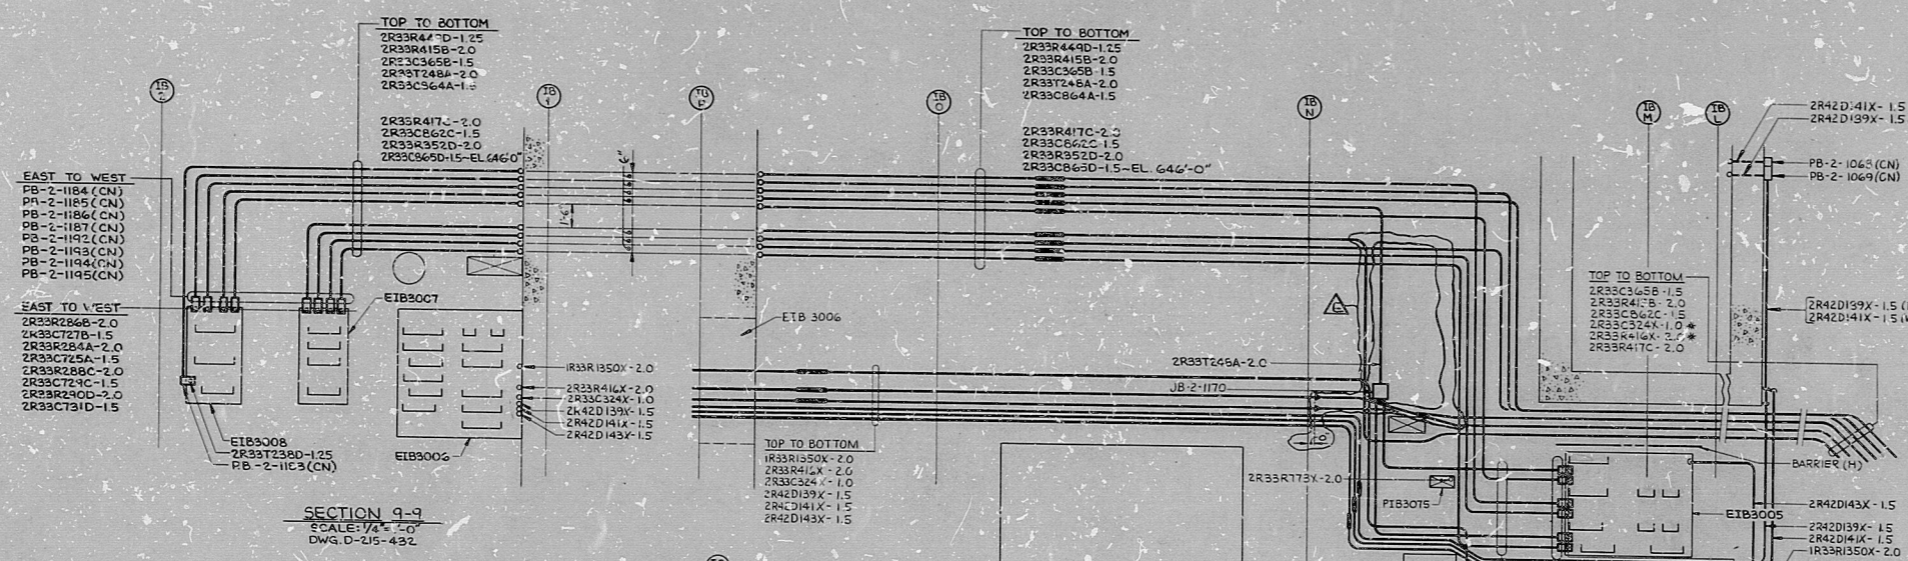

SCALE: 1/4" = 1'-0"
DWG. D-215-432

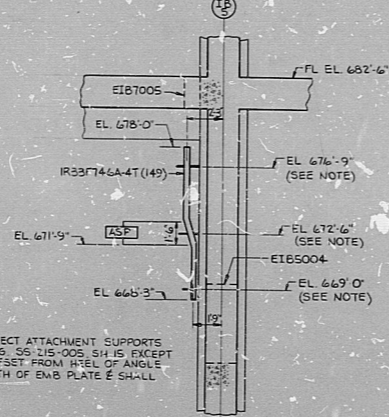

DETAIL 'B'
LOOKING SOUTH
D-215-451, COORD. E11

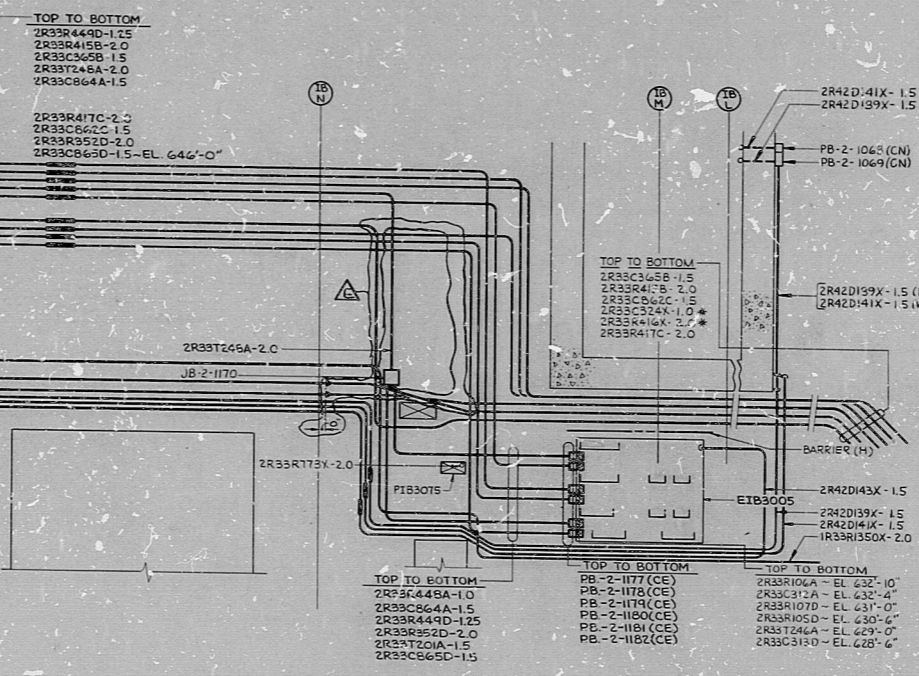

SECTION 8-8
SCALE: 1/4" = 1'-0"
DWG. D-215-432

NOTES:
1. FOR LEGEND, NOTES, REFERENCES, AND STANDARD DETAILS, SEE DRAWING D-215-001.

REVISIONS AS INDICATED BY 3 PLACES

NO.	DATE	BY	REVISION

NUCLEAR SAFETY RELATED

CONSTRUCTION 5-33

LIMITED CONSTRUCTION: AS NOTED

PRELIMINARY NOT FOR CONSTRUCTION

BIDDING PURPOSES

DATE RELEASED FOR: ENGR.

THE CLEVELAND ELECTRIC ILLUMINATING COMPANY


ELECTRICAL

CONDUIT LAYOUT

INTERMEDIATE BUILDING SECTIONS (X) DETAILS

DRAWING NO. GILBERT ASSOCIATES, INC.

ENGINEERS AND CONSTRUCTORS

SCALE: 1/4" = 1'-0"

DATE: 04-4549

D-215-671

REV

INTER-BLOCK SECTIONS & DETAILS

RIDS

82-2100357

