

37

38

22

22

17

17

11

11

8.5

8.5

8.5

8.5

11


11

17

17

22

22

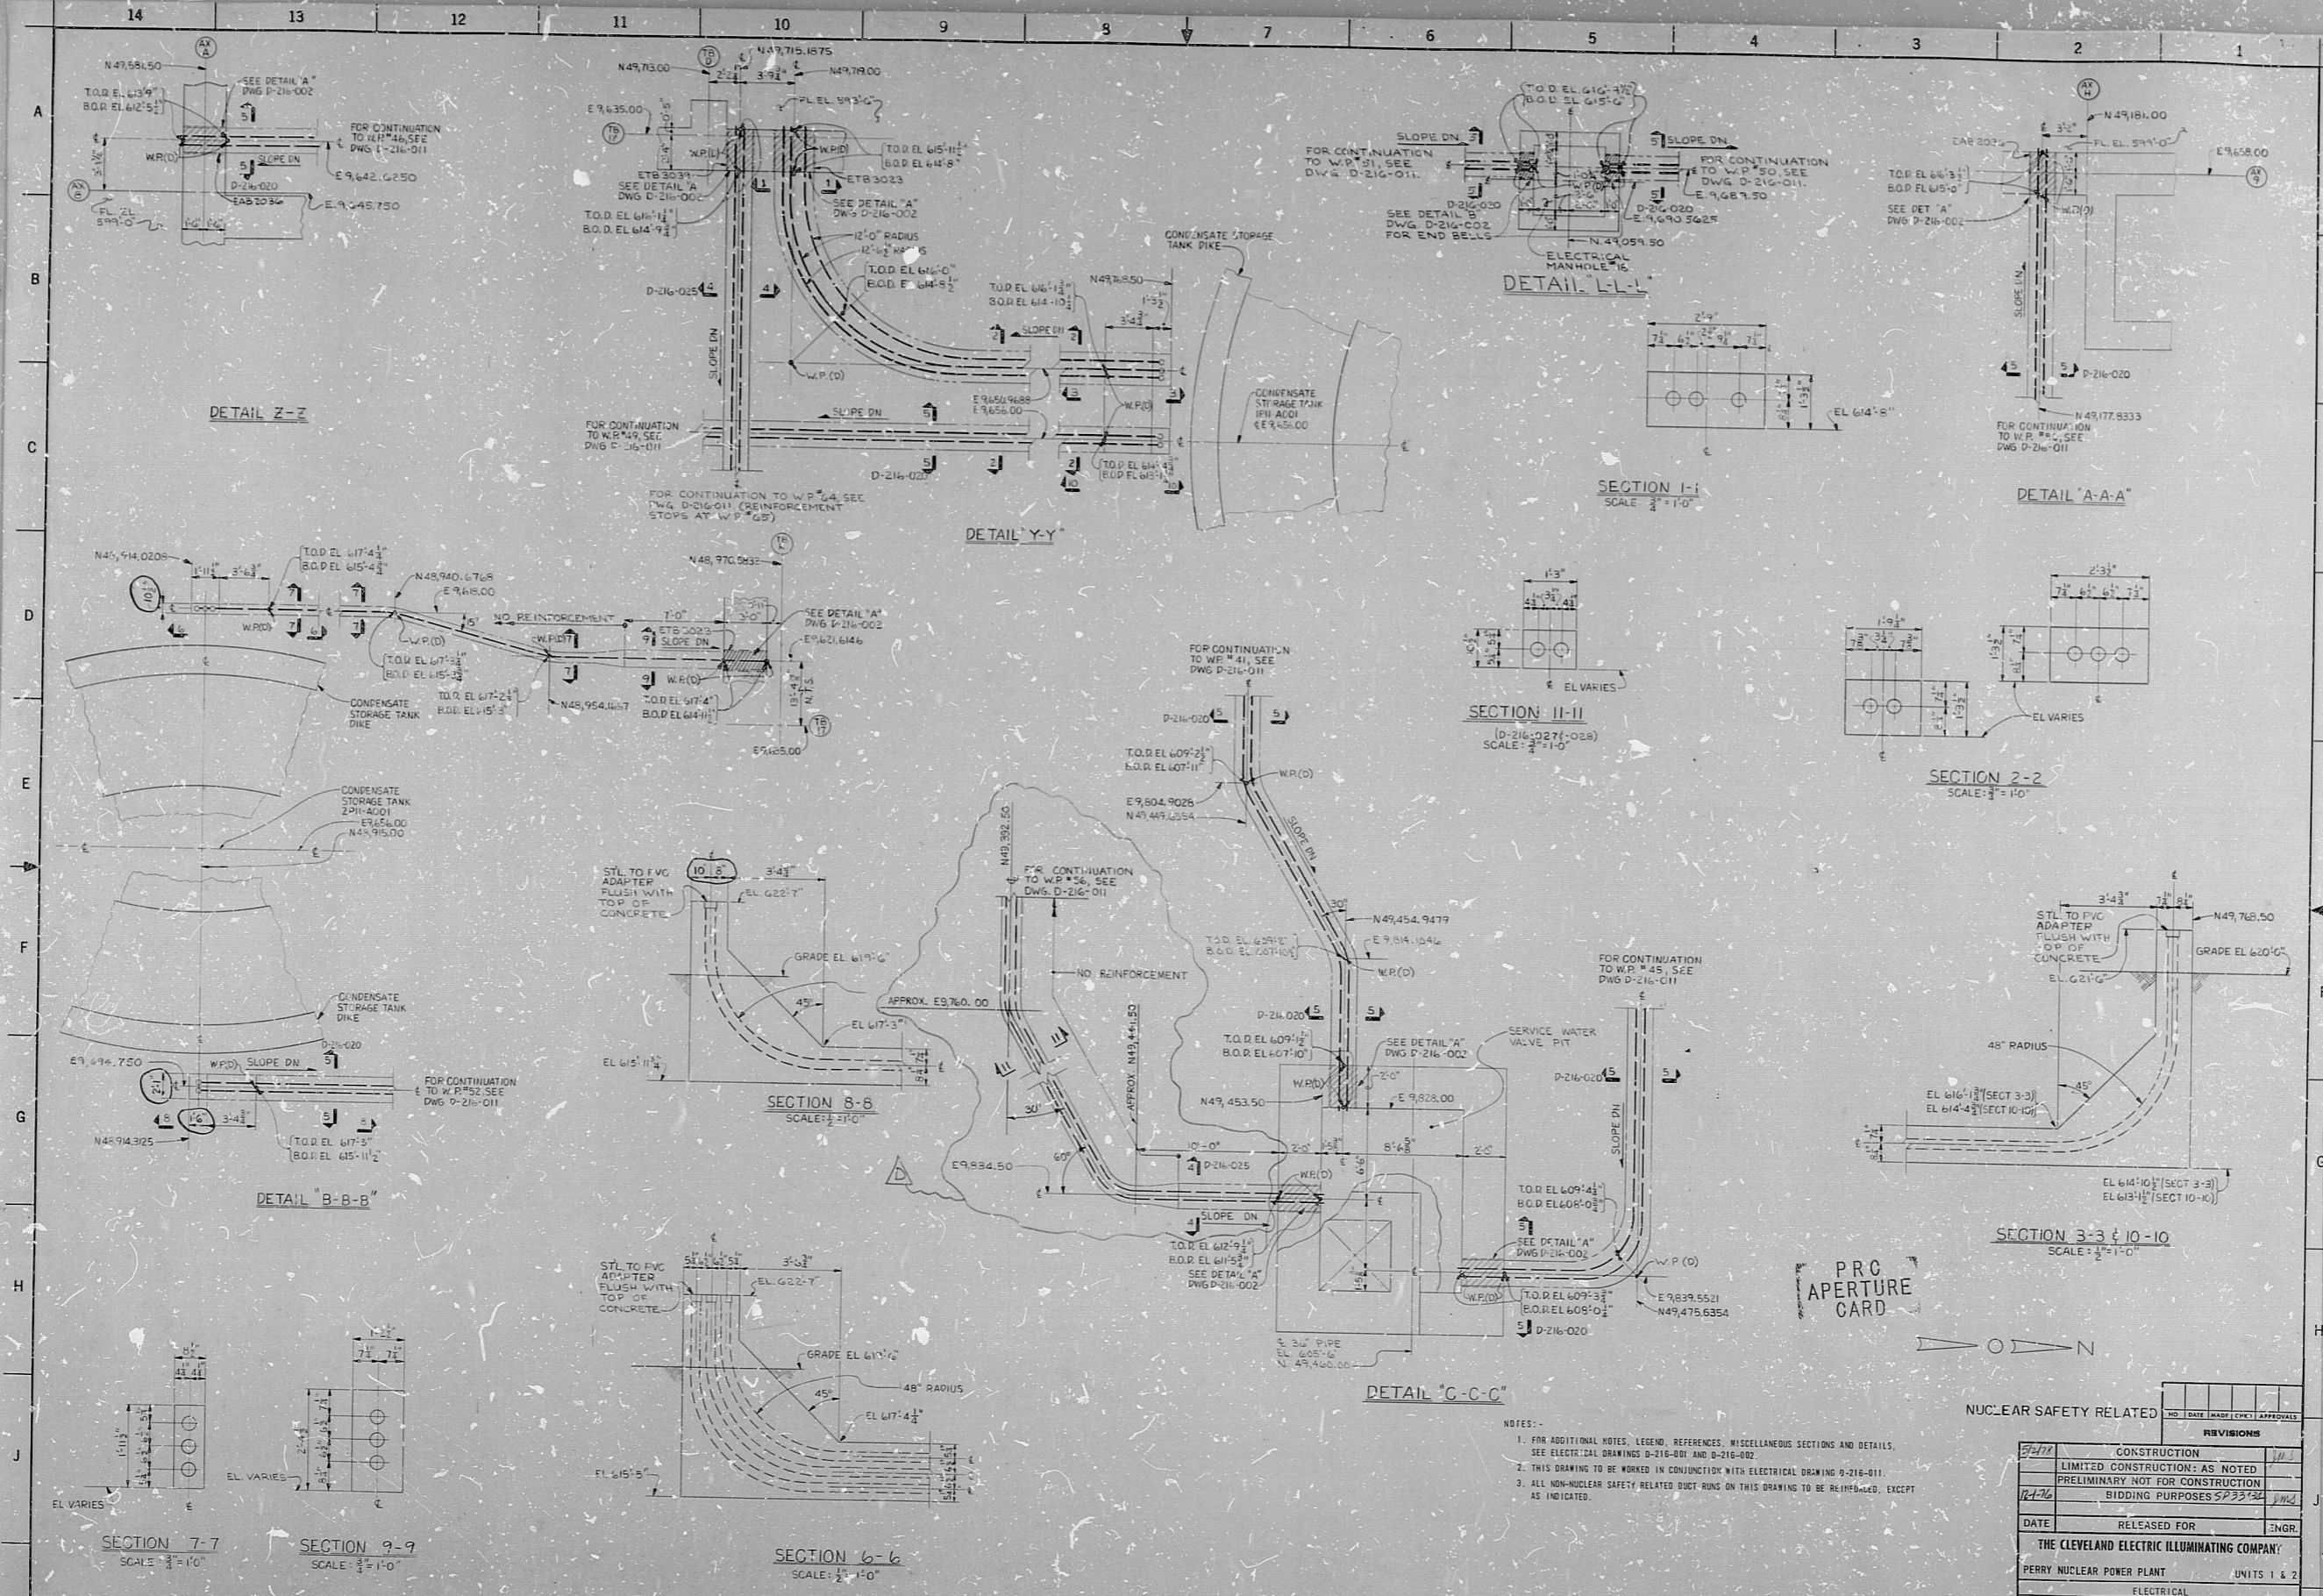

DETAIL Z-Z

DETAIL Y-Y

DETAIL B-B-B

DETAIL C-C-C

SECTION 7-7
SCALE: 1/2" = 1'-0"

SECTION 9-9
SCALE: 1/2" = 1'-0"

SECTION 6-6
SCALE: 1/2" = 1'-0"

SECTION 1-1
SCALE: 1/2" = 1'-0"

DETAIL A-A-A

SECTION 2-2
SCALE: 1/2" = 1'-0"

SECTION 3-3
SCALE: 1/2" = 1'-0"

SECTION 10-10
SCALE: 1/2" = 1'-0"

PRC APERTURE CARD

- NOTES:
- FOR ADDITIONAL NOTES, LEGEND, REFERENCES, MISCELLANEOUS SECTIONS AND DETAILS, SEE ELECTRICAL DRAWINGS D-216-001 AND D-216-002.
 - THIS DRAWING TO BE WORKED IN CONJUNCTION WITH ELECTRICAL DRAWING D-216-011.
 - ALL NON-NUCLEAR SAFETY RELATED DUCT RUNS ON THIS DRAWING TO BE REINFORCED, EXCEPT AS INDICATED.

NUCLEAR SAFETY RELATED

NO.	DATE	BY	CHKD.	APP'D.
5/2/77				
REVISIONS				
5/2/77				
CONSTRUCTION				
LIMITED CONSTRUCTION AS NOTED				
PRELIMINARY NOT FOR CONSTRUCTION				
BIDDING PURPOSES 5/2/77				
DATE RELEASED FOR INGR				
THE CLEVELAND ELECTRIC ILLUMINATING COMPANY				
PERRY NUCLEAR POWER PLANT UNITS 1 & 2				
ELECTRICAL				
UNDERGROUND DUCT RUNS				
MISCELLANEOUS DUCT RUNS EAST SIDE OF PLANT				
DRAWING NO.	GILBERT ASSOCIATES, INC.			
ENGINEER	ENGINEERS AND CONSULTANTS			
DWG. NO.	04 4549 D-216-028 D			
DRAWING NUMBER				

UNDUCT R UN S DUCT S EAST OF PLANT

RIDS

8212100389

