


PLAN  
CONDENSATE STORAGE TANK  
UNIT 1

SECTION 1-1

SECTION 2-2

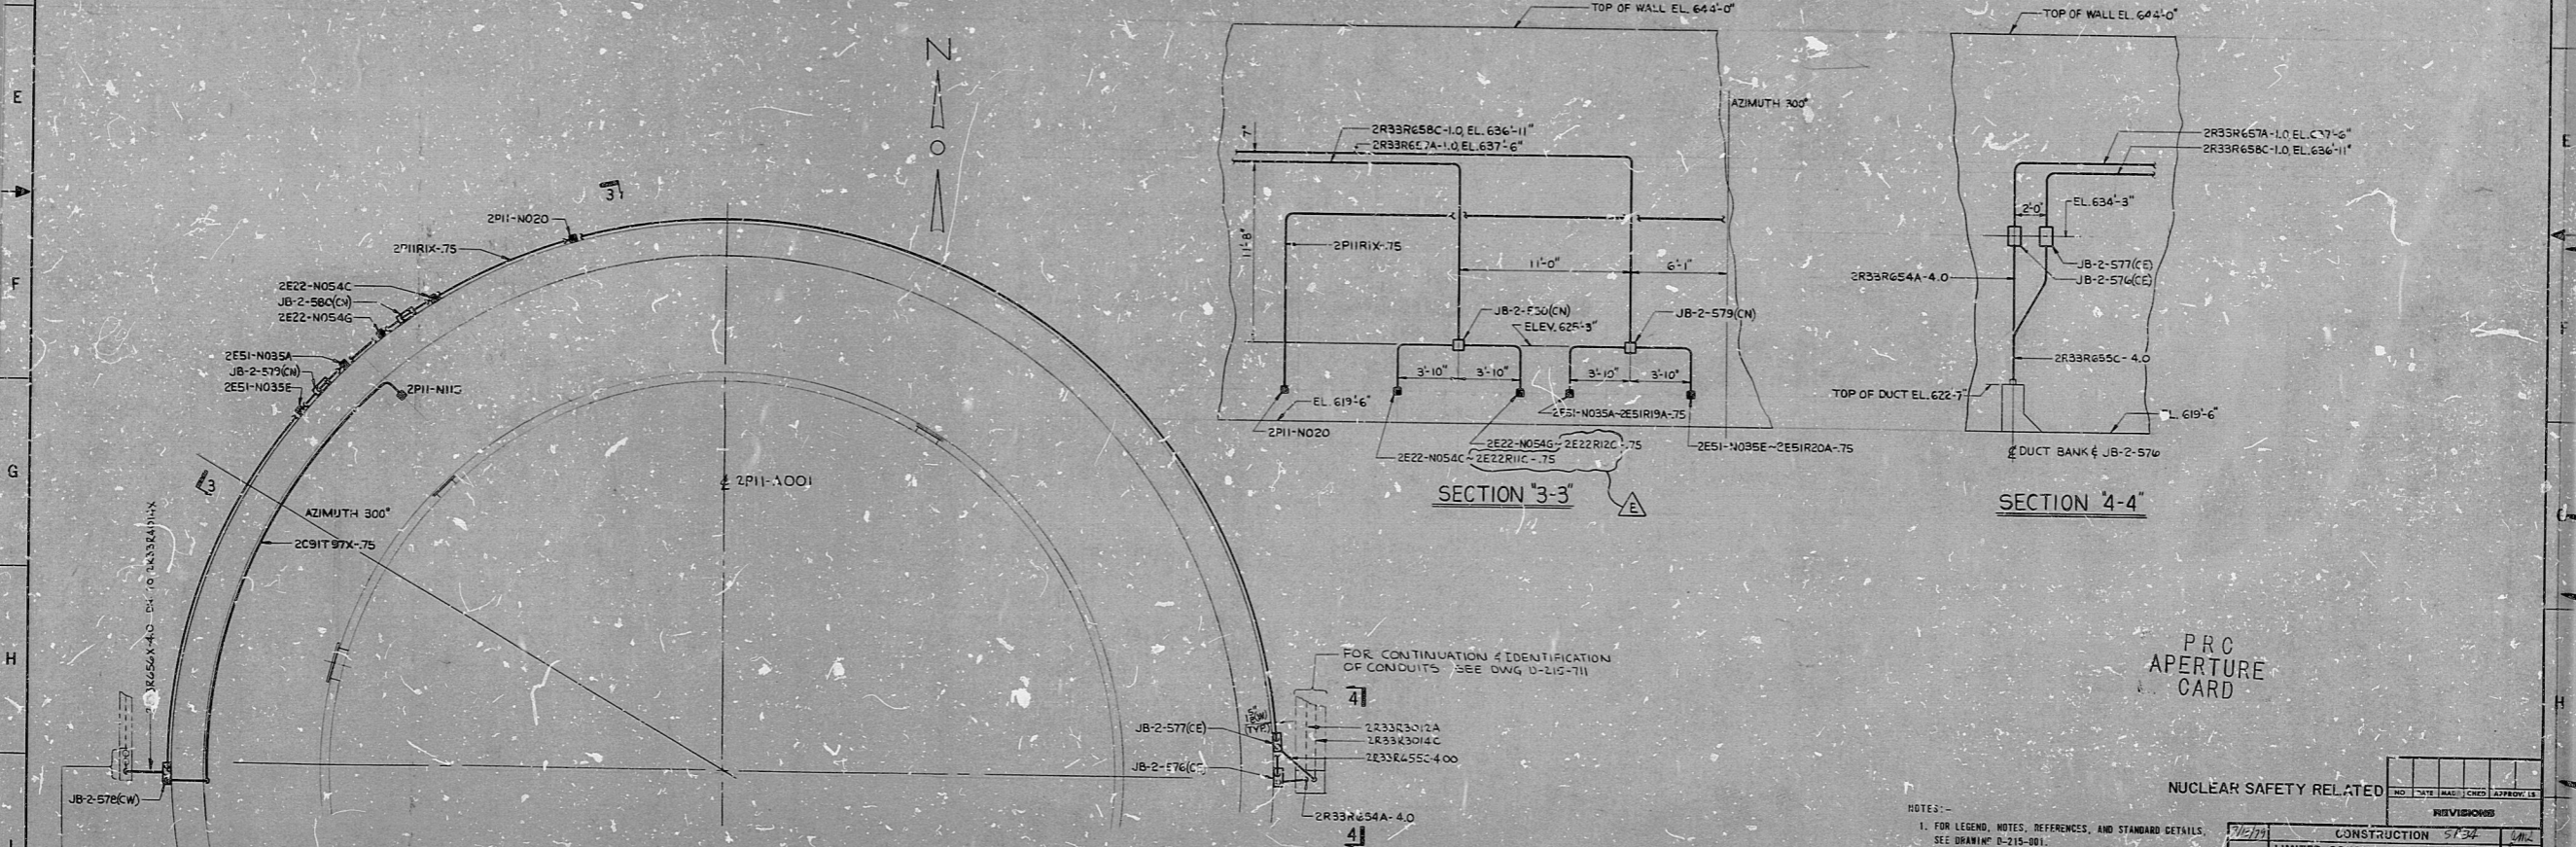

PLAN  
CONDENSATE STORAGE TANK  
UNIT 2

SECTION 3-3

SECTION 4-4

PRC  
APERTURE  
CARD

NUCLEAR SAFETY RELATED

NOTES:  
1. FOR LEGEND, NOTES, REFERENCES, AND STANDARD DETAILS,  
SEE DRAWING D-215-001.

REVISIONS			
NO.	DATE	BY	APPROVED BY
1	5/15/71	[Signature]	[Signature]

DATE	RELEASED FOR	ENGR.
	THE CLEVELAND ELECTRIC ILLUMINATING COMPANY	
	PERRY NUCLEAR POWER PLANT	UNITS 1 & 2
	ELECTRICAL	
	CONDUIT LAYOUT	
	YARD AREA	
DRAWING NO.	D-270-002	REV. E
DRAWING NUMBER		

REVISIONS	DATE	BY	APPROVED BY
REVISED AS IND.			
REVISED AS PER			
REVISED AS INDICATED			

CND L Y T YARD AREA

RIDS

82.2100419

