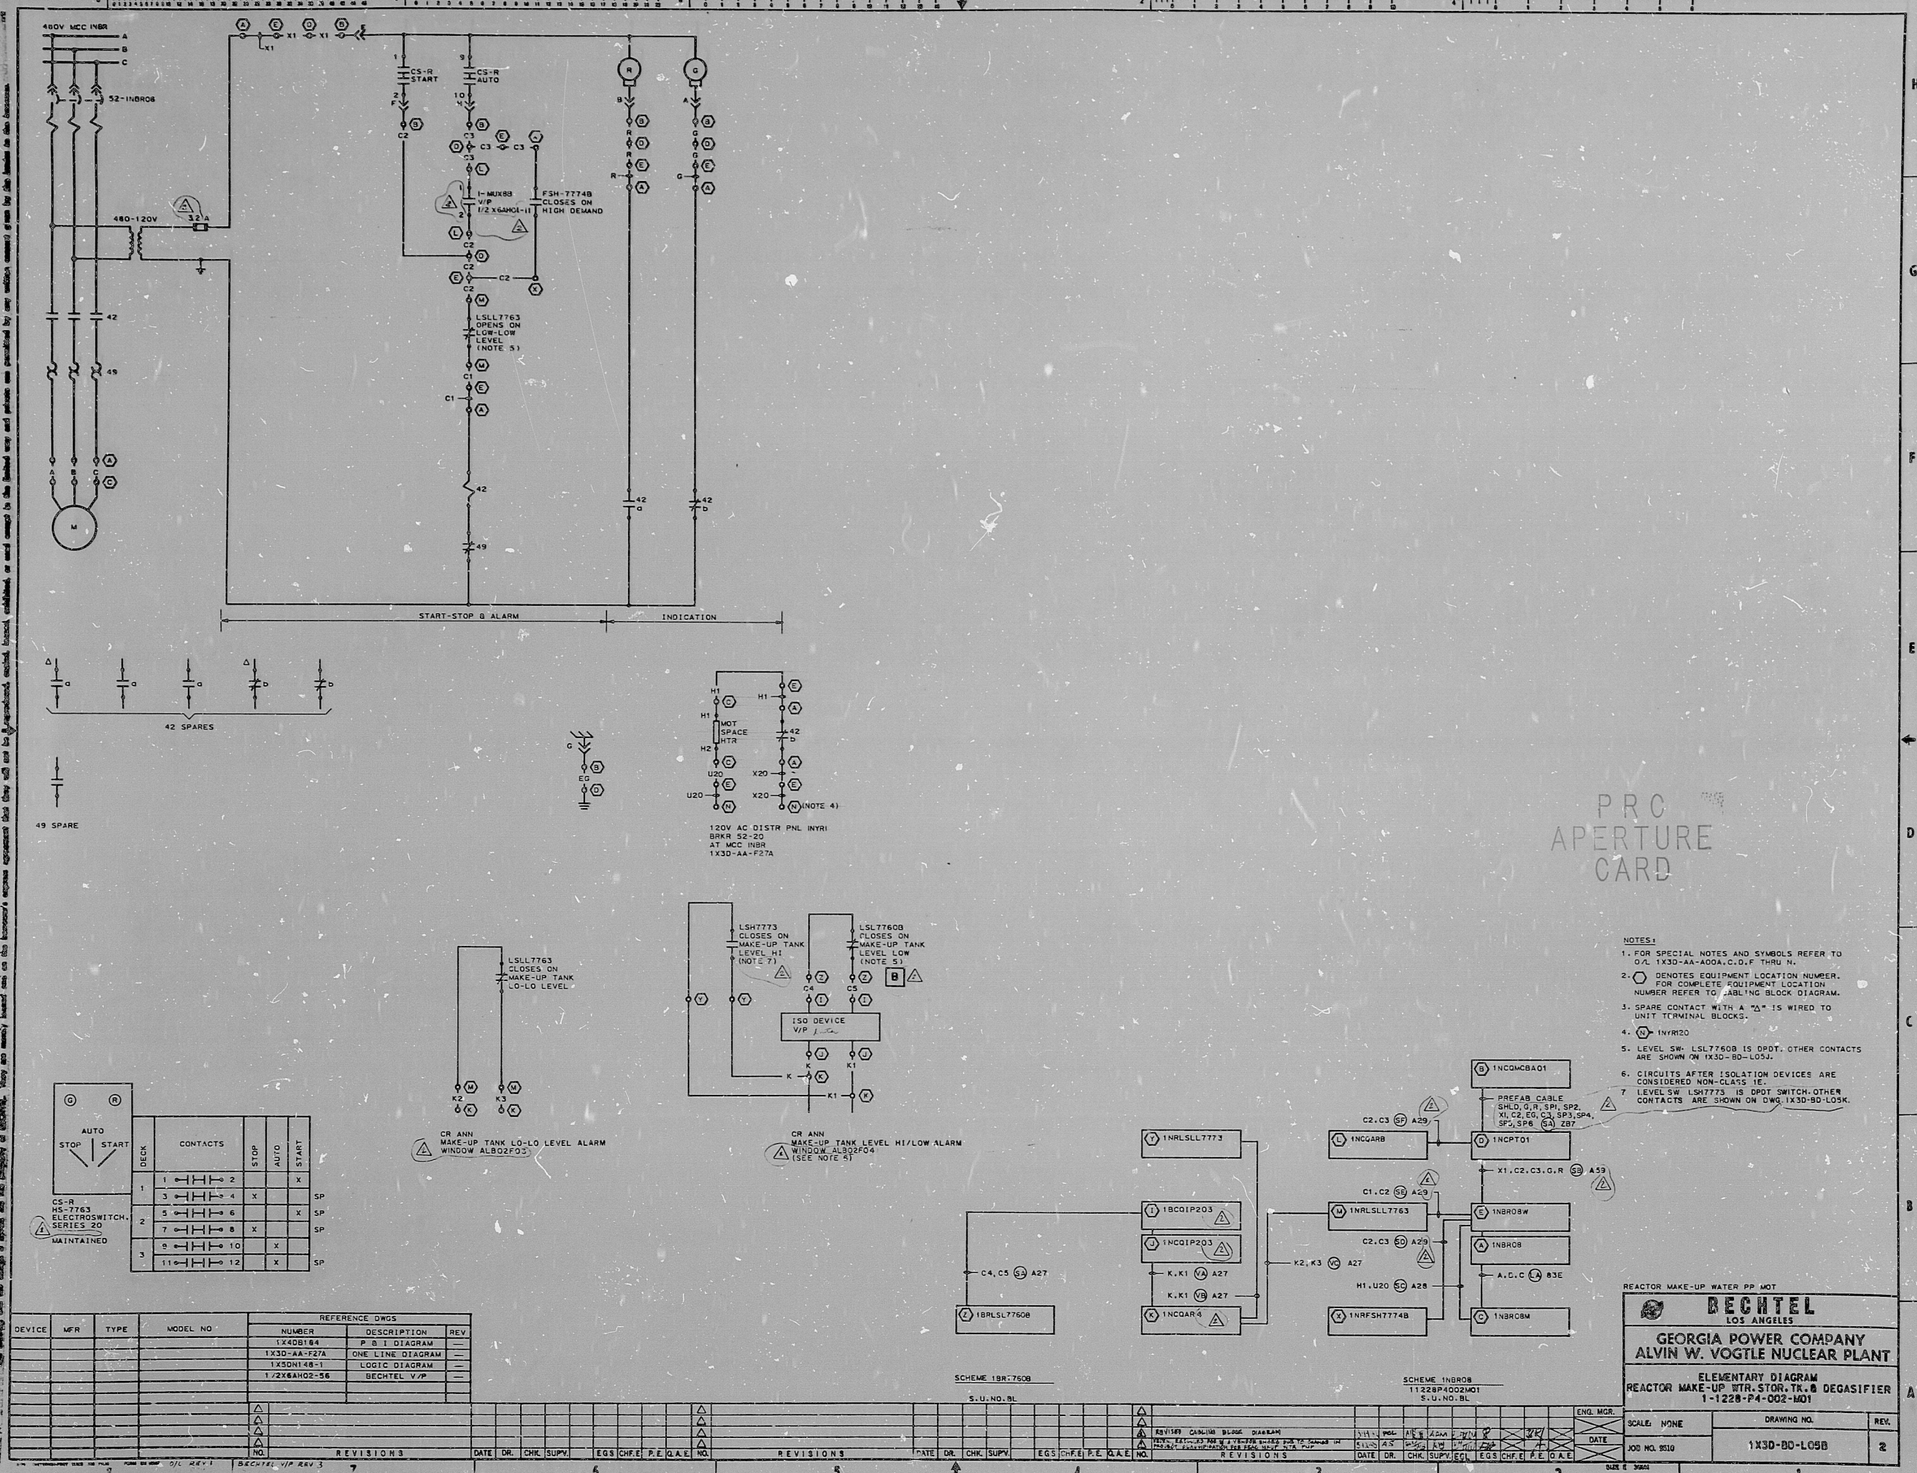

NOTES:

1. FOR SPECIAL NOTES AND SYMBOLS REFER TO O/L 1X3D-AA-A00A,C,D,F THRU N.
2. ⬡ DENOTES EQUIPMENT LOCATION NUMBER. FOR COMPLETE EQUIPMENT LOCATION NUMBER REFER TO CABLING BLOCK DIAGRAM.
3. SPARE CONTACT WITH A "Δ" IS WIRED TO UNIT TERMINAL BLOCKS.
4. (N) = 1NYR120
5. LEVEL SW- LSL7760B IS DPDT. OTHER CONTACTS ARE SHOWN ON 1X3D-BD-L05J.
6. CIRCUITS AFTER ISOLATION DEVICES ARE CONSIDERED NON-CLASS 1E.
7. LEVEL SW LSH7773 IS DPDT SWITCH. OTHER CONTACTS ARE SHOWN ON DWG. 1X3D-BD-L05K.

DEVICE	MFR	TYPE	MODEL NO	REFERENCE DWGS NUMBER	DESCRIPTION	REV
				1X4DB164	P & I DIAGRAM	—
				1X3D-AA-F27A	ONE LINE DIAGRAM	—
				1X5DN148-1	LOGIC DIAGRAM	—
				1/2X6AH02-56	BECHTEL V/P	—

REACTOR MAKE-UP WATER PP MOT

BECHTEL
LOS ANGELES

GEORGIA POWER COMPANY
ALVIN W. VOGTLE NUCLEAR PLANT

ELEMENTARY DIAGRAM
REACTOR MAKE-UP WTR.STOR.TK.& DEGASIFIER
1-1228-P4-002-M01

SCALE: NONE	DRAWING NO.	REV.
JOB NO. 9510	1X3D-BD-L05B	2

REVISED CABLING BLOCK DIAGRAM

O/L REV 1 BECHTEL V/P REV 3

PRC APERTURE CARD

RIDS

8310030487

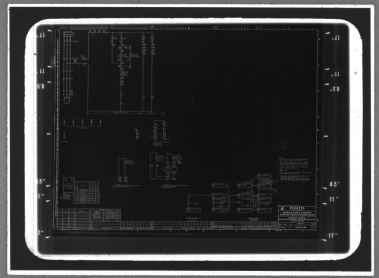

MMM 5824 — FILMSORT® Brand Aperture & Camera Cards and DUPLICARD® Brand Copy Cards — Product of 3M Company, St. Paul, Minn.