


ENERGIZED WHEN DRYWELL HIGH PRESSURE GREATER THAN SETPOINT
 ENERGIZED WHEN REACTOR WATER BELOW LEVEL 1
 ENERGIZES WHEN RHR "A" OR LPCS PUMP RUNNING
 ENERGIZED WHEN REACTOR WATER BELOW LEVEL 3

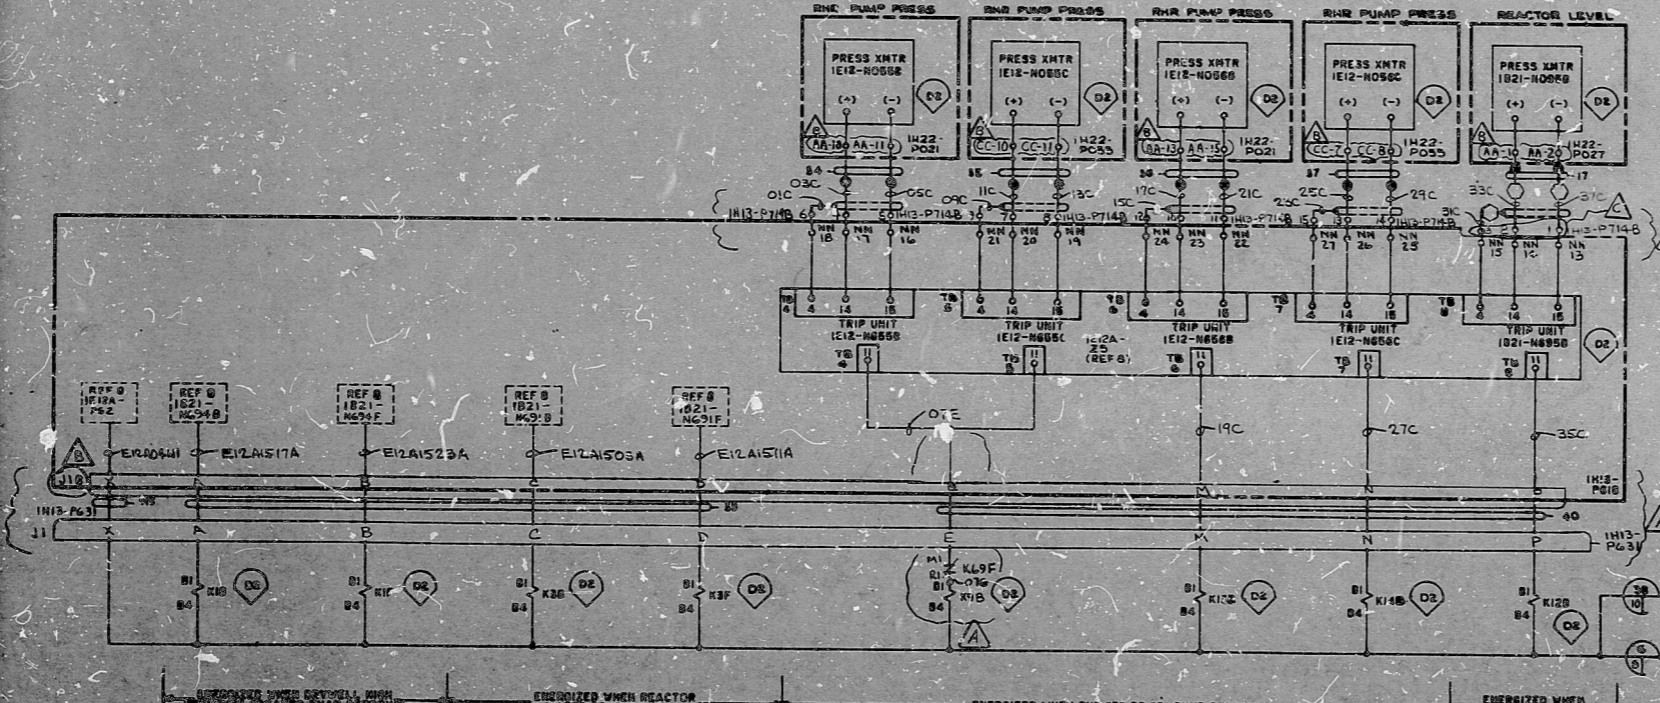

ENERGIZED WHEN DRYWELL HIGH PRESSURE GREATER THAN SETPOINT
 ENERGIZED WHEN REACTOR WATER BELOW LEVEL 1
 ENERGIZES WHEN RHR "B" OR "C" PUMP RUNNING
 ENERGIZED WHEN REACTOR WATER BELOW LEVEL 5

- NOTES:
1. IH3-PT4B TERMINATION CABINET
LINE CODE 34-37, 17 TM004
 2. IH3-PT15A TERMINATION CABINET
LINE CODE 27-31 TM025

PRC APERTURE CARD

LINE CODES: 27-37, 17, 35, 40, 914, 915

NUCLEAR SAFETY RELATED

THE CLEVELAND ELECTRIC ILLUMINATING CO.

PERRY NUCLEAR POWER PLANT

ELECTRICAL-ELEMENTARY DIAGRAM

AUTOMATIC DEPRESSURIZATION SYSTEM
RELAY LOGIC, ANALOG DEVICES

CHANGED TERM INFORMAT
ADDED JR

REVISED PER G.E. DWG

ADDED FITS INFORMATION
AND PLUGS PER GE G.

GILBERT ASSOCIATES, INC.
ENGINEERS AND CONSULTANTS

REV	DATE	BY	CHKD	APPROVALS	DATE	REV	DATE	BY	CHKD	APPROVALS	DATE	REV	DATE	BY	CHKD	APPROVALS	DATE	WORK ORDER	MADE	CHKD	DR. APR.	RHS. APR.	DATE	
1	11/1/77	JR	AM			2	1/11/78	JR	AM			3	4/16/78	JR	AM			044549-000	IC6	GAG	DEG			04/14/79

ELEM DIAG IB21C REL LOG ANAL CKTS

Rids

8212130321

