


PRC
APERTURE
CARD

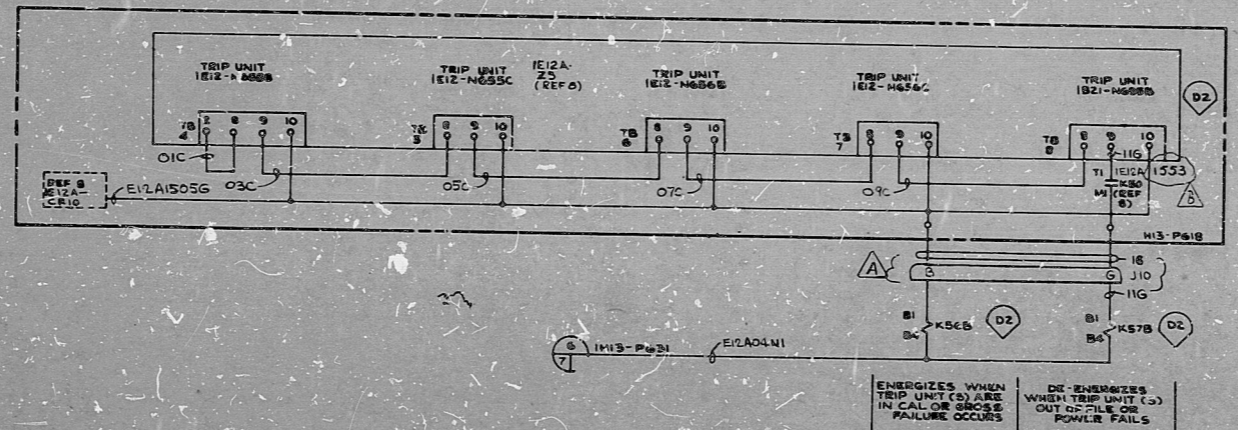

LINE CODES: 41,16

NUCLEAR SAFETY RELATED

THE CLEVELAND ELECTRIC ILLUMINATING CO.

PERRY NUCLEAR POWER PLANT UNIT 1

ELECTRICAL-ELEMENTARY DIAGRAM

AUTOMATIC DEPRESSURIZATION SYSTEM
RELAY LOGIC, ANALOG CIRCUITS

GENERAL INFORMATION
R2B226CA
SHEET 51, REV. L
AUTOMATIC DEPRESSURIZATION SYS
PROJECT NUMBER 000

9-21-78
CONSTRUCTION
PRELIMINARY
DATE RELEASED FOR ENGR.

ADDEN PANEL INFORMATION

ADDED PLUGS OR GAGE REV. L

READING PA. GILBERT ASSOCIATES, INC. ENGINEERS AND CONSULTANTS

REV	MADE	CHKD	APPROVALS	DATE	REV	MADE	CHKD	APPROVALS	DATE	REV	MADE	CHKD	APPROVALS	DATE	REV	MADE	CHKD	APPROVALS	DATE	WORK ORDER	MADE	CHKD	DR. APP.	ENGR. APP.	DATE	DRAWING NUMBER	SYSTEM	SHEET NO.	TOTAL SHEETS		
																										04	4540	B-208-011	B31	608	8

ELEM DIAG IBZIC REL LOG, ANAL CCTS

Rids

8212130323

