




RIDS

8106290489

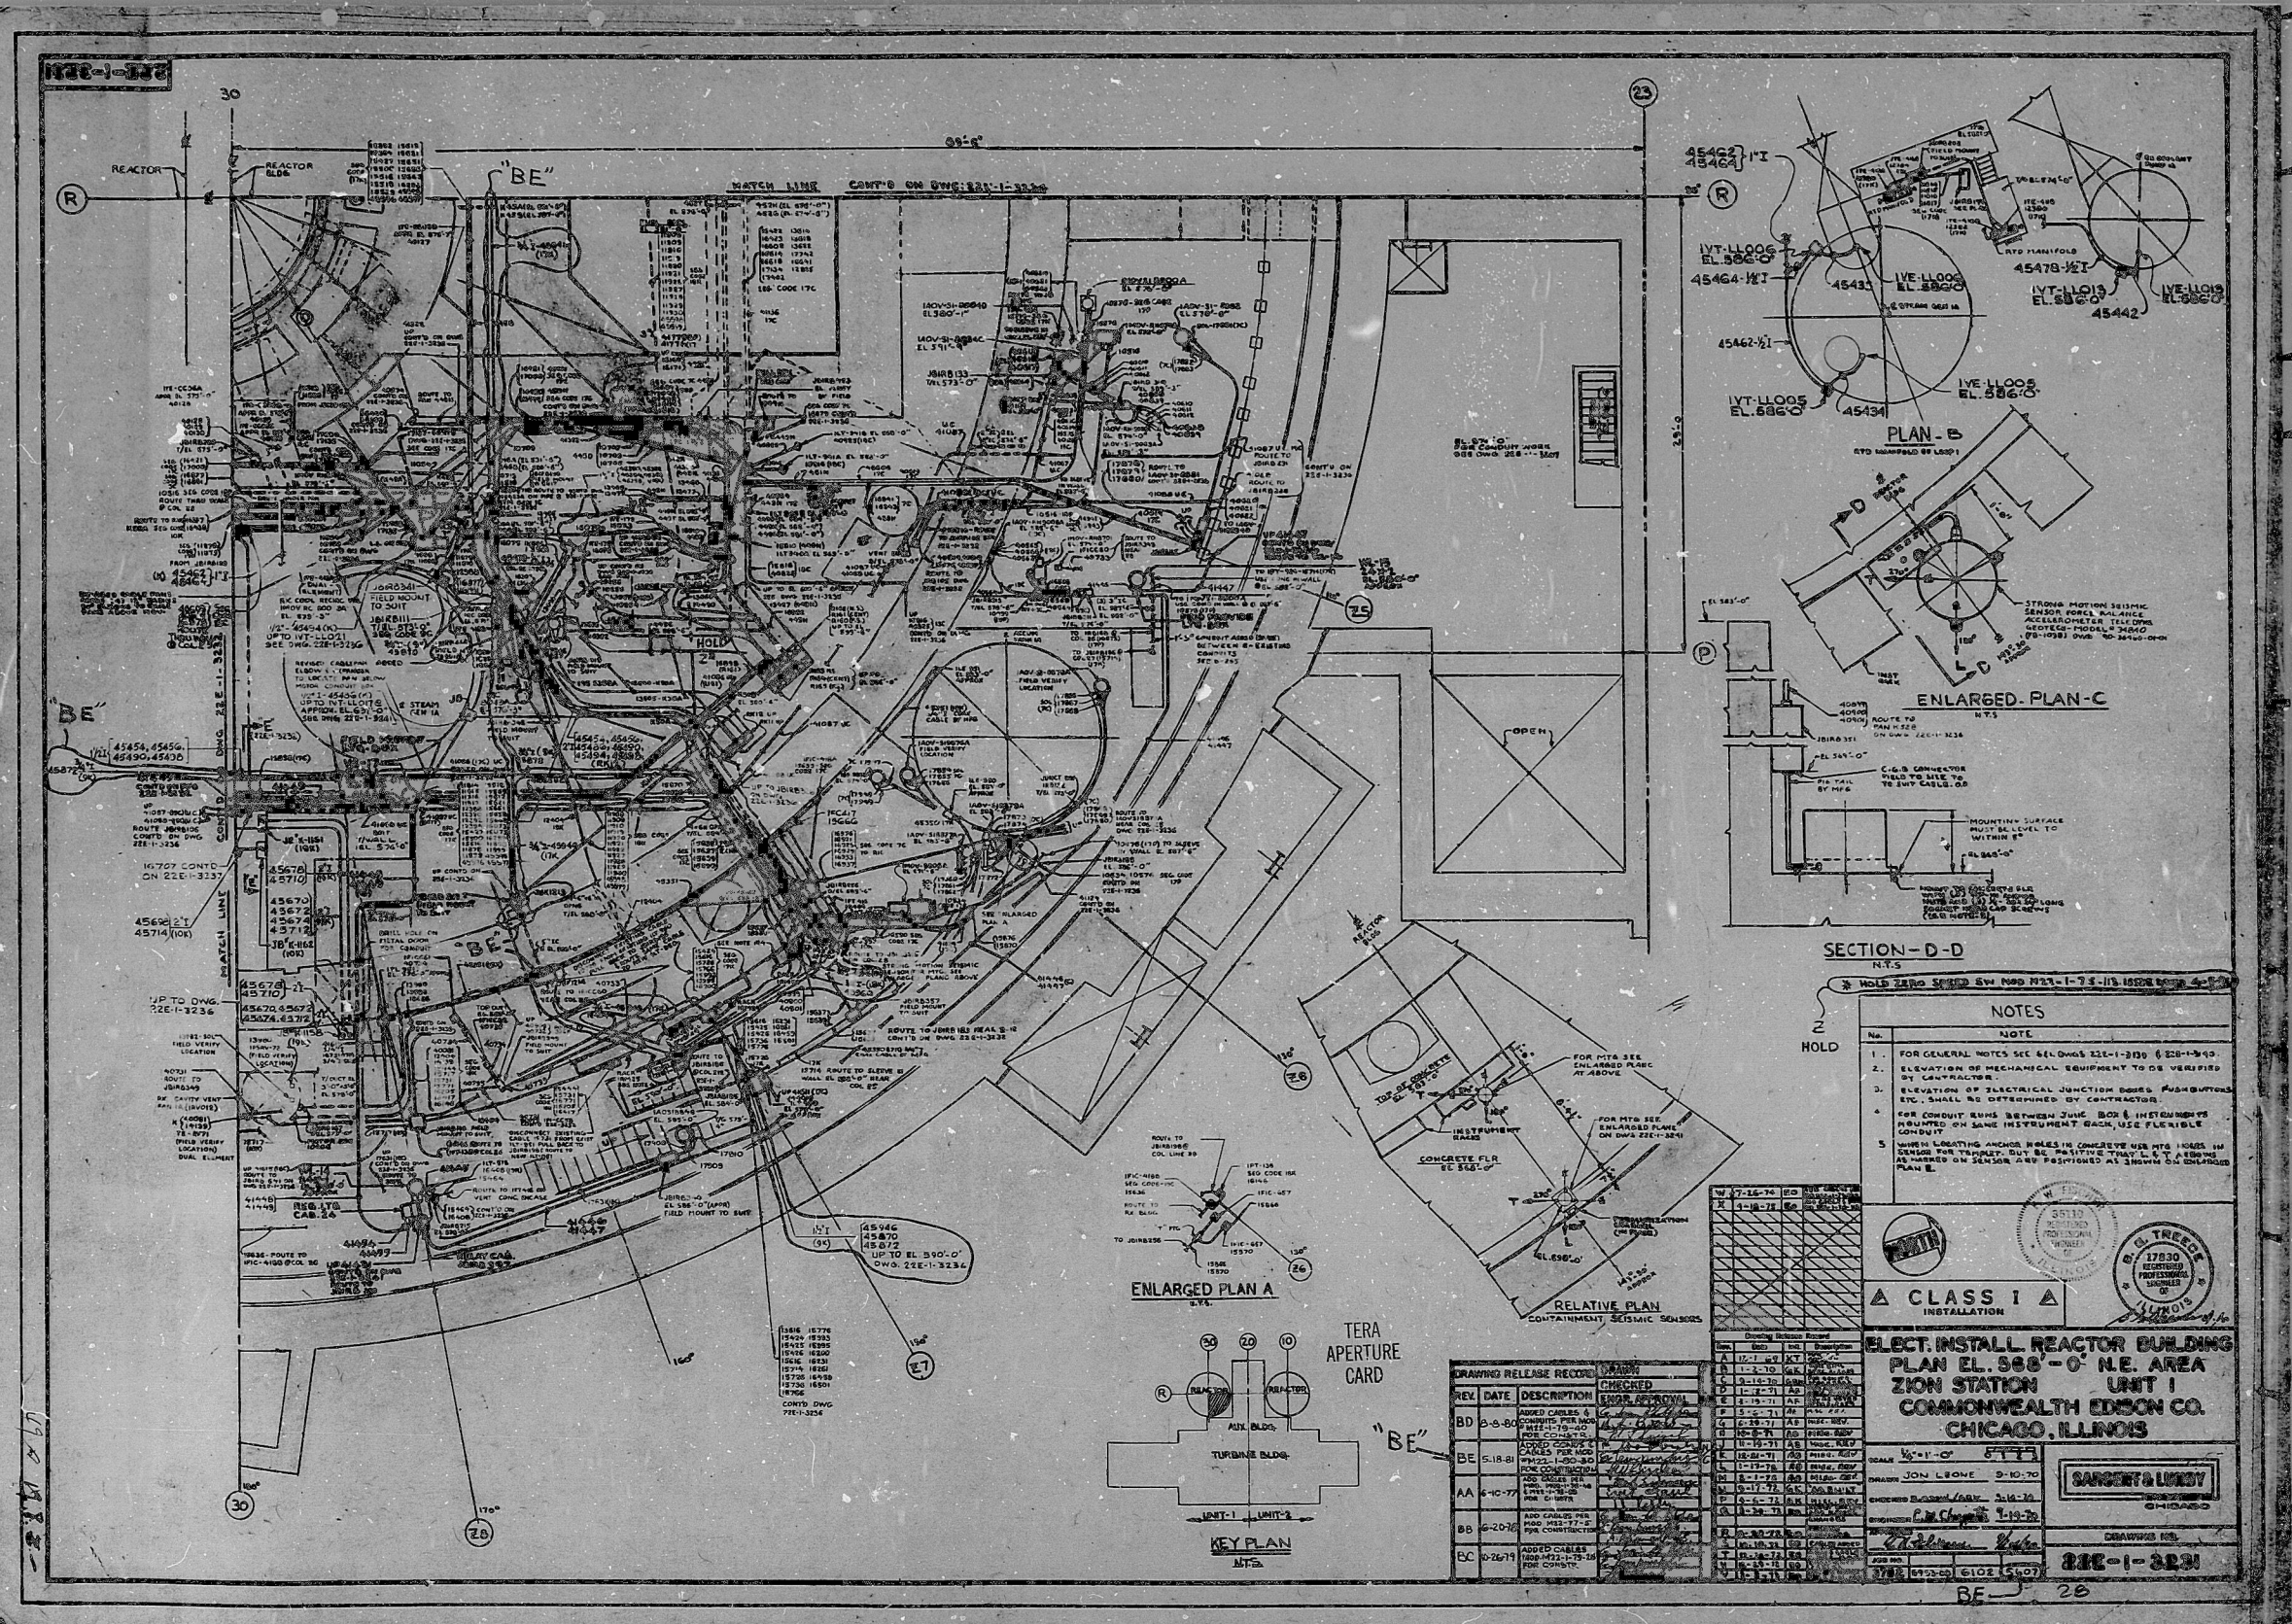