


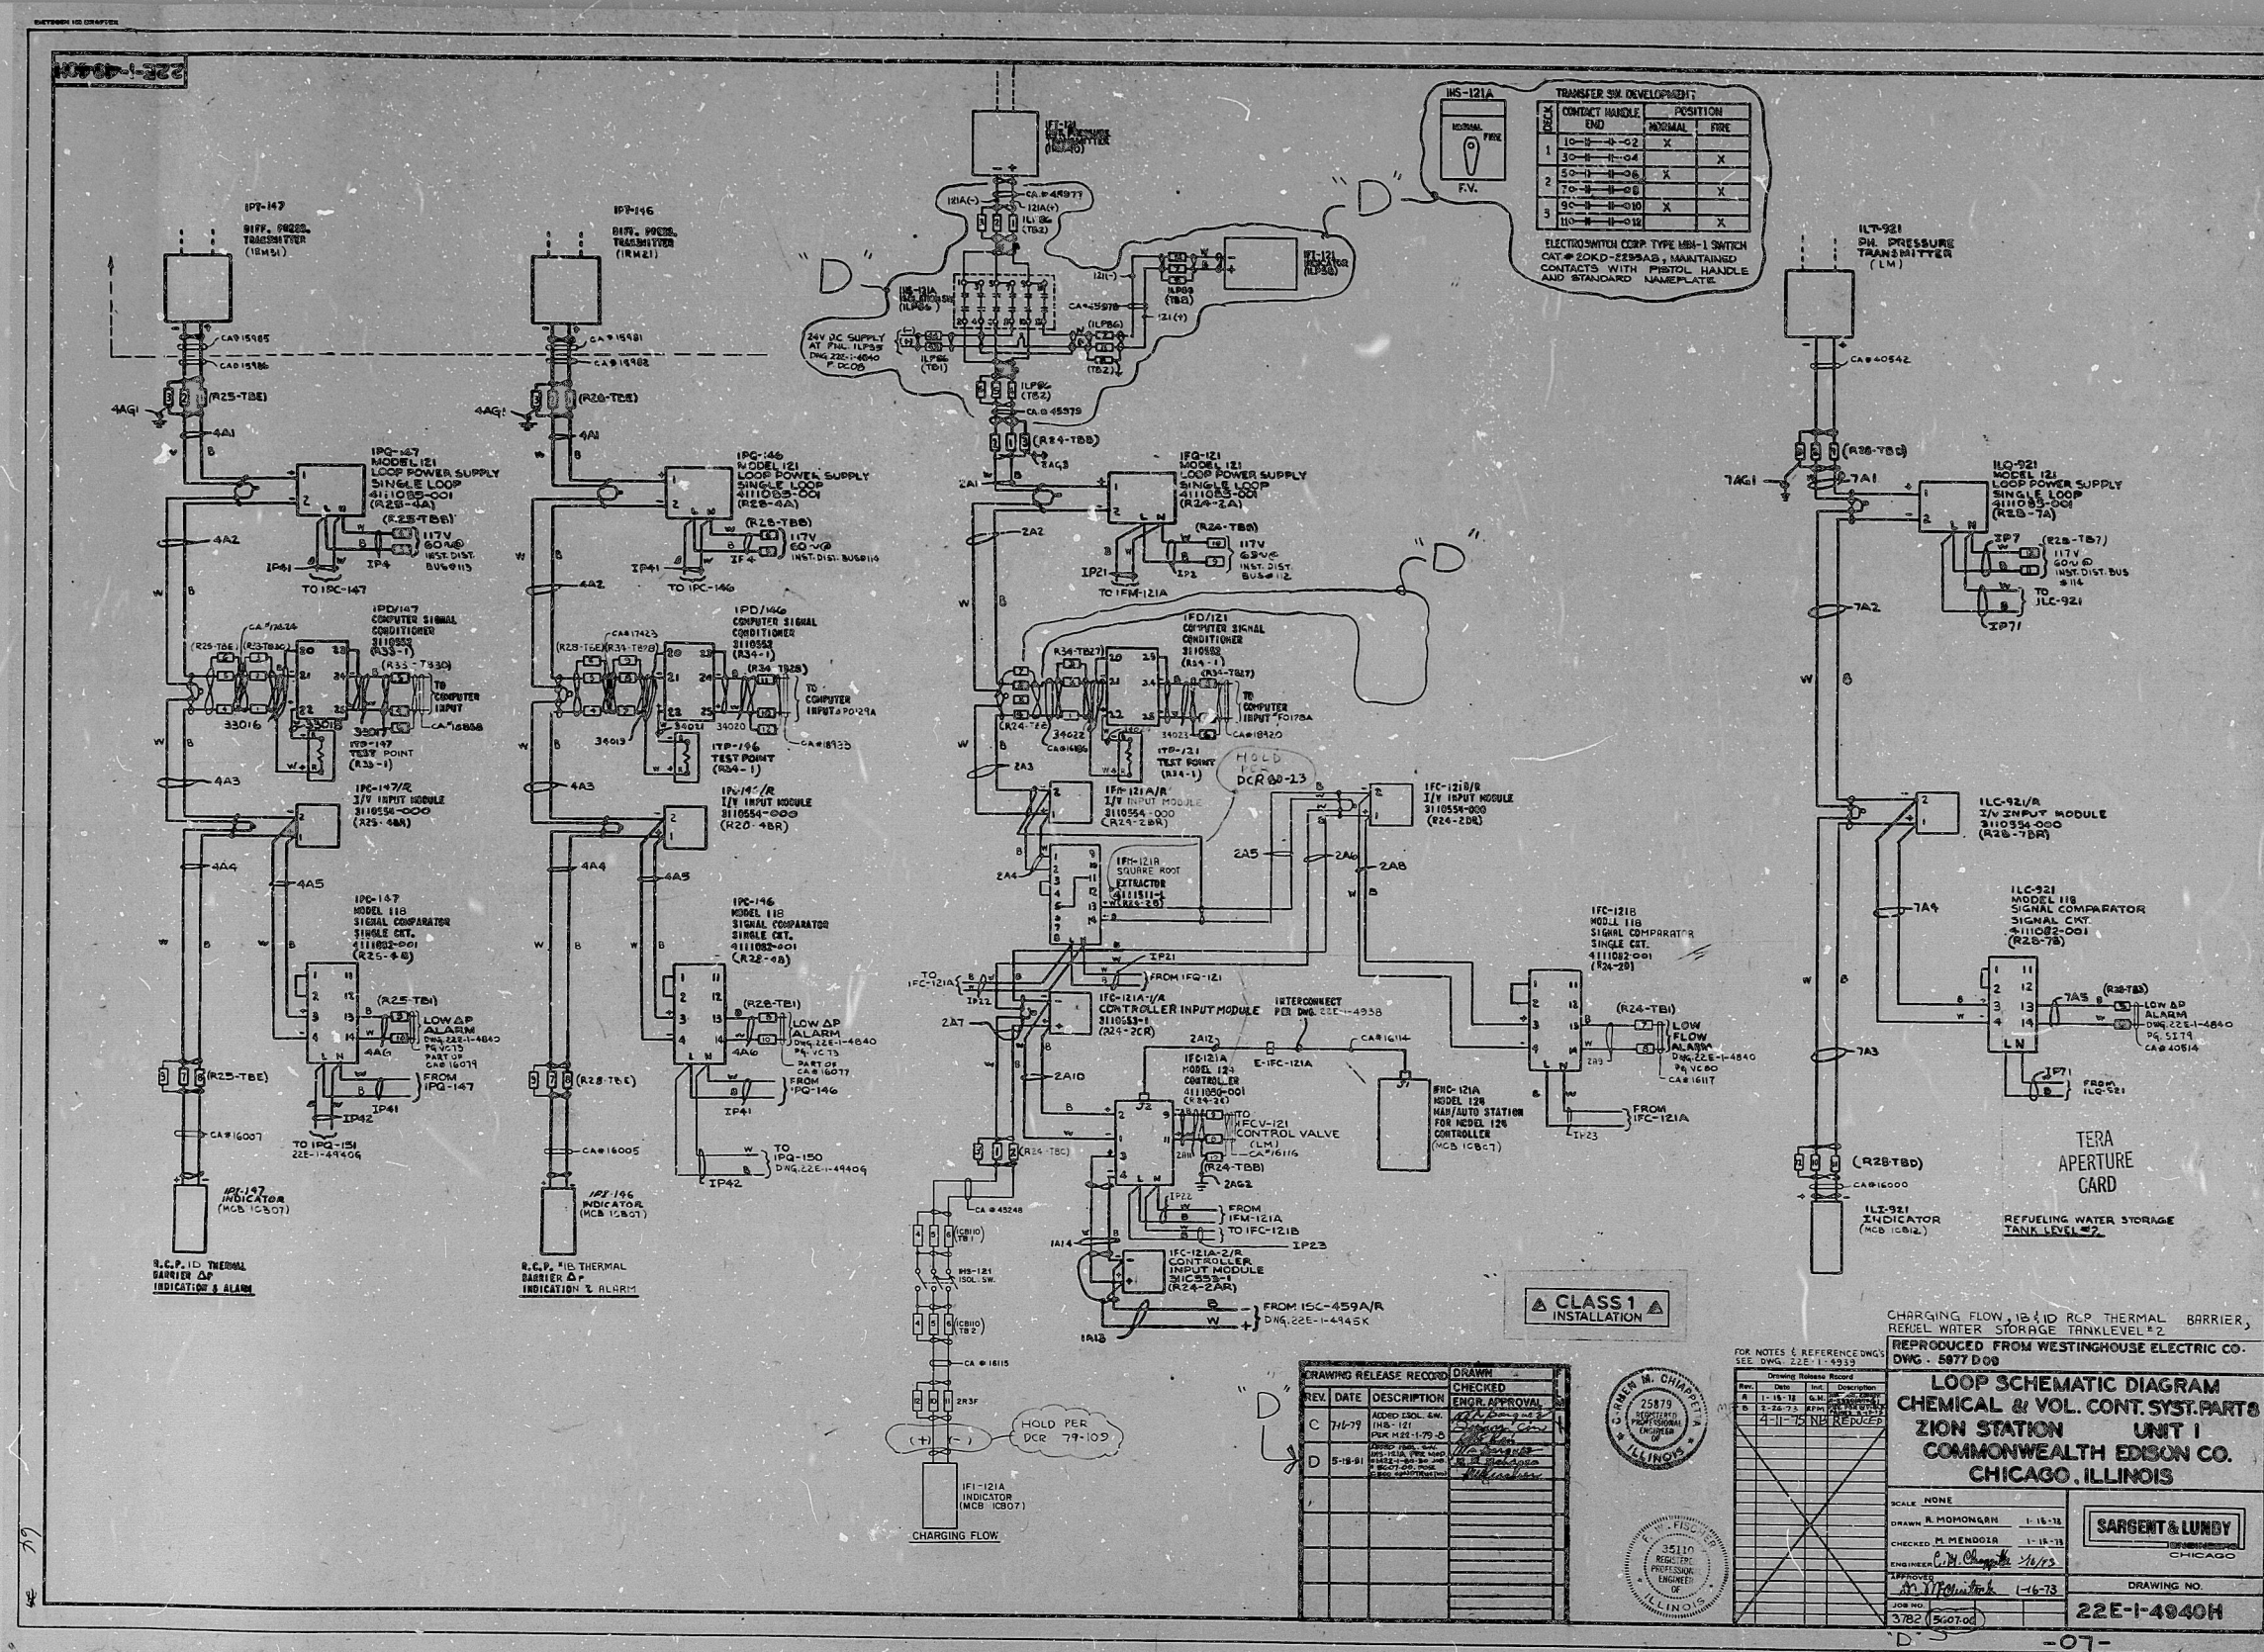

TRANSFER SW DEVELOPMENT

CONTACT	HANDLE	POSITION

ELECTROSWITCH CORP. TYPE HSB-1 SWITCH
CAT # 204-D-2288AD, MAINTAINED
CONTACTS WITH PISTON HANDLE
AND STANDARD NAMEPLATE

DRAWING RELEASE RECORD

REV	DATE	DESCRIPTION	CHECKED	ENGR. APPROVAL

FOR NOTES & REFERENCE ONLY


REPRODUCED FROM WESTINGHOUSE ELECTRIC CO.
DWG. 5877 D00

**LOOP SCHEMATIC DIAGRAM
CHEMICAL & VOL. CONT. SYST. PART 8
ZION STATION UNIT 1
COMMONWEALTH EDISON CO.
CHICAGO, ILLINOIS**

SCALE: NONE
DRAWN: A. MOMONEN
CHECKED: M. MENDON
ENGINEER: C. J. CHAPMAN
DATE: 1-18-78

SARGENT & LUNDY
CHICAGO

DRAWING NO.
22E-1-4940H

RXDS

8106300096

