
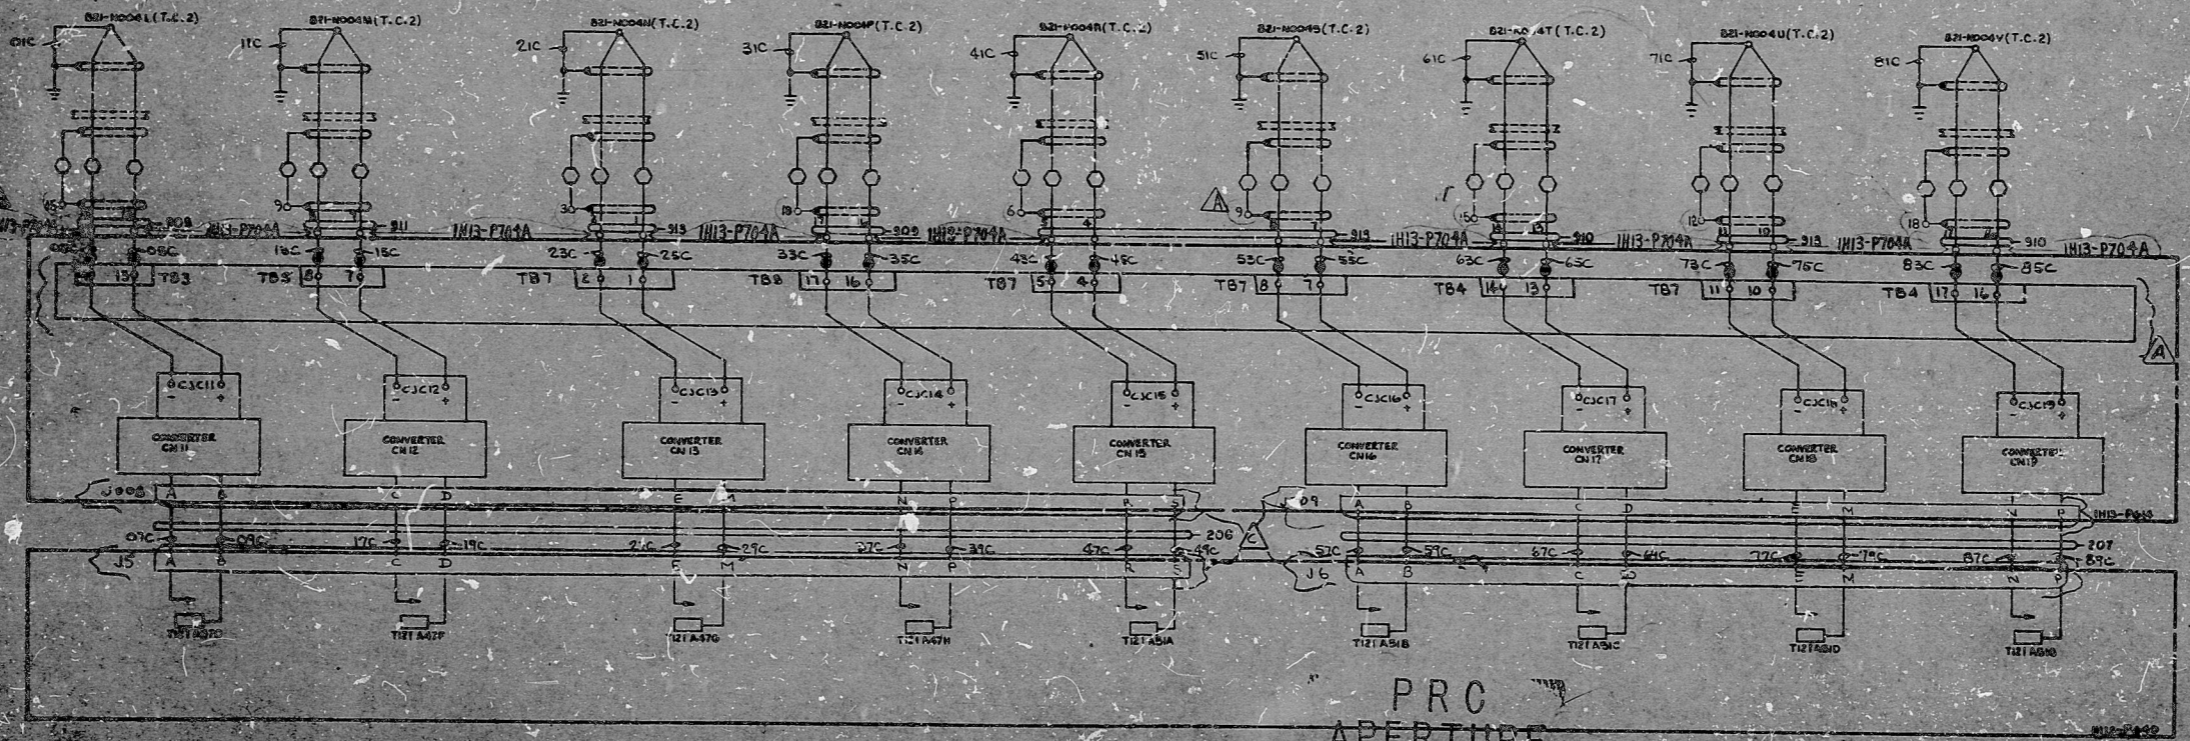



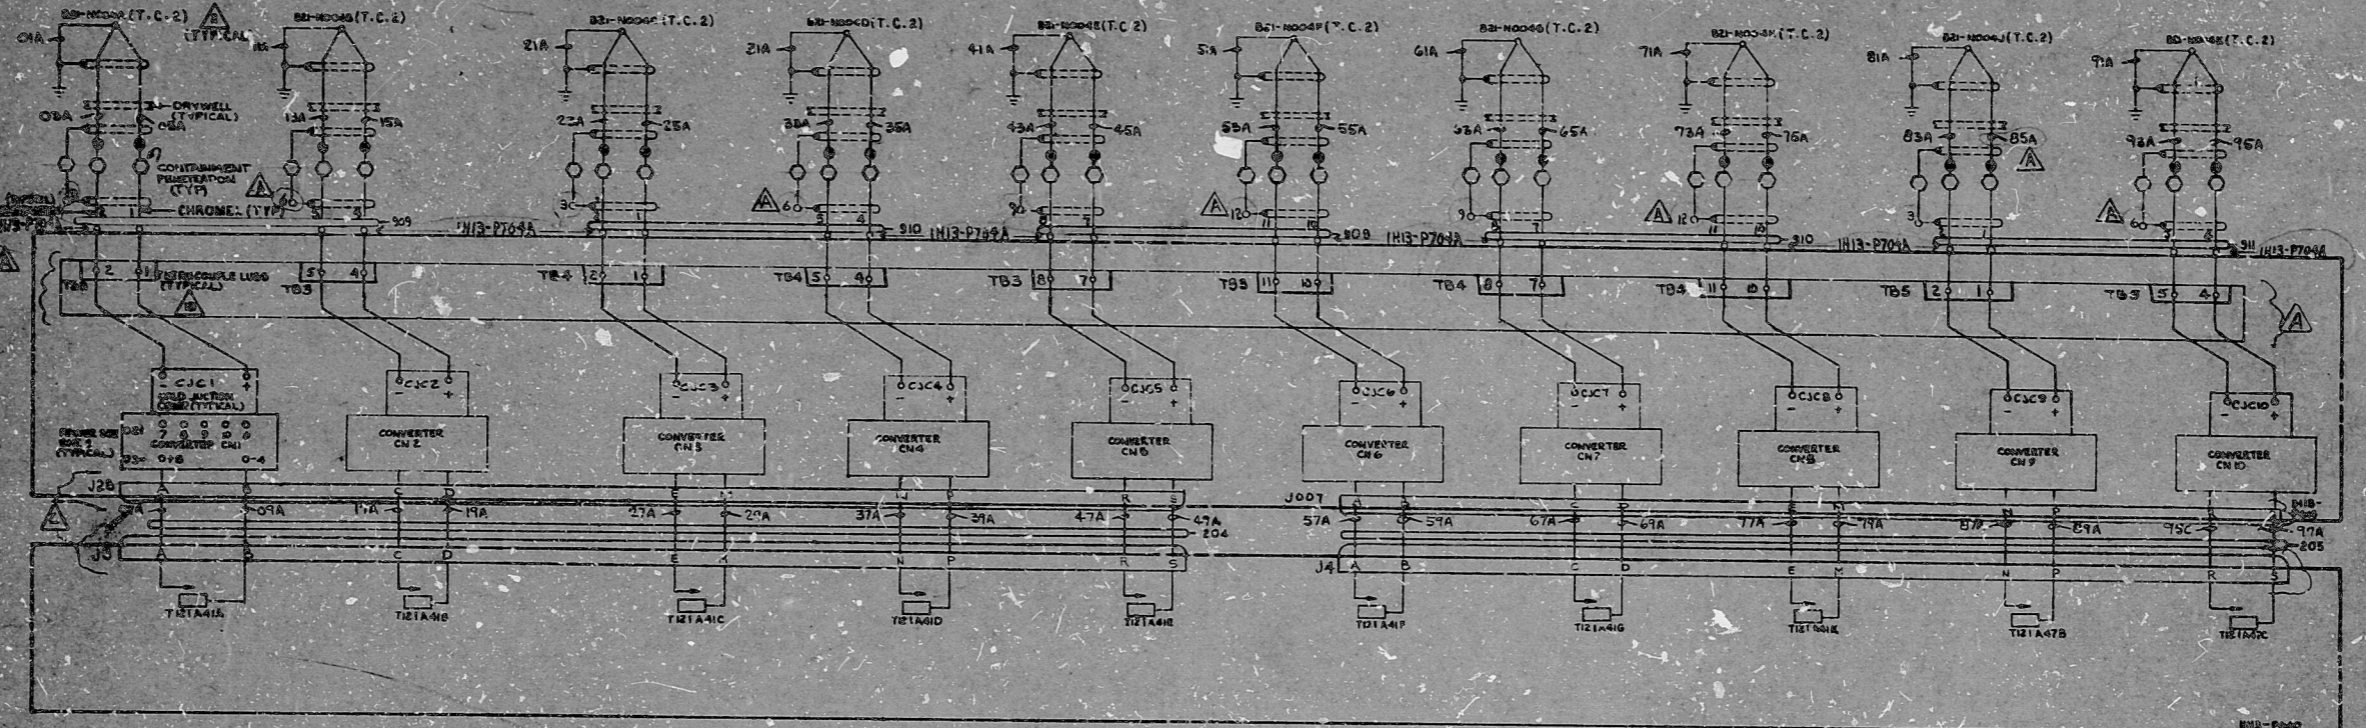

PRC  
APERTURE  
CARD

NOTES

- 1 IN13-P704A TERMINATION CABINET
- LINE CODE 911 TB005
- LINE CODE 910 TB004
- LINE CODE 909 TB003
- LINE CODE 918 TB007


THE CLEVELAND ELECTRIC ILLUMINATION CO. CLEVELAND, OHIO

ADDED 15, 16, 1001, 1000, 1009, 1010	REVISED FITS TERM. NO. 902 66 REVISION	ADDED FITS INFORMATION	READING PA.	GILBERT ASSOCIATES INC. ENGINEERS AND CONSULTANTS	DATE RELEASED FOR	CONSTRUCTION	PRELIMINARY	DATE	REVISION	THE CLEVELAND ELECTRIC ILLUMINATION CO. CLEVELAND, OHIO
C	Y	Z	T	M	D	C	B	A	1	1

66 L  
66  
66 S  
8  
11  
1

66 L  
66  
66 S  
8.5"  
11"  
8.5"  
11"  
17"

Rids

8212130386

