K9A SH. 14	K9A SH. 6	----	SP	SP	SP	SP	----	R6135601	K9C SH. 14	K9C SH. 6	----	SP	SP	SP	SP	----	R6135617
K10A SH. 6	K10A SH. 6	----	R6135701	----	SP	SP	SP	SP	K10C SH. 6	K10C SH. 6	----	R6135717	----	SP	SP	SP	SP
K10A SH. 6	K10A SH. 6	----	----	R6105801	----	COMP SH. 4	SP	SP	K10C SH. 6	K10C SH. 6	----	----	R6105817	----	COMP SH. 4	SP	SP
K9A SH. 14	K9A SH. 6	----	----	R6135801	SP	SP	SP	SP	K9C SH. 14	K9C SH. 6	----	----	R6135817	SP	SP	SP	SP
K9A SH. 6	K9A SH. 10	----	K96A SH. 8	----	K94A SH. 11	----	K9A SH. 6	----	K9C SH. 6	K9C SH. 10	----	K96B SH. 8	----	K94B SH. 11	----	K9C SH. 6	----
K10A SH. 6	K10A SH. 6	----	----	R6135901	SP	SP	SP	SP	K10C SH. 6	K10C SH. 6	----	----	R6135917	SP	SP	SP	SP
K9A SH. 6	K9A SH. 8	----	K66A SH. 12	----	----	R6136021	K7A SH. 6	----	K9C SH. 6	K9C SH. 8	----	----	R6136037	K73A SH. 12	----	K7C SH. 6	----
K9A SH. 6	K9A SH. 6	----	K73A SH. 12	----	SP	SP	SP	SP	K9C SH. 6	K9C SH. 6	----	K7EA SH. 12	----	SP	SP	SP	SP
K10A SH. 8	K10A SH. 13	----	R6136129	----	SP	SP	SP	SP	K10C SH. 12	K10C SH. 6	----	SP	SP	SP	SP	SP	SP
K10A SH. 14	K10A SH. 6	----	SP	SP	SP	SP	SP	SP	K12C In. 14	K3C SH. 6	----	SP	SP	SP	SP	SP	SP
K12A SH. 14	K3A SH. 6	----	SP	SP	SP	SP	SP	SP	K12C SH. 14	SP	SP	K3C SH. 6	----	SP	SP	SP	SP
K12A SH. 14	SP	SP	K3A SH. 6	----	SP	SP	SP	SP	K12C SH. 14	SP	SP	SP	SP	K3C SH. 6	----	SP	SP
K12A SH. 14	SP	SP	SP	SP	SP	K3A SH. 6	----	SP	K12C SH. 14	SP	SP	SP	SP	SP	SP	K3C SH. 6	----
K12A SH. 14	SP	SP	SP	SP	SP	SP	K3A SH. 6	----	K12C SH. 14	K129B SH. 12	----	SP	SP	SP	SP	SP	SP
K12A SH. 14	K129A SH. 12	----	SP	SP	SP	SP	SP	SP	K12C SH. 14	SP	SP	SP	SP	----	R6133109	SP	SP
K12A SH. 14	SP	SP	SP	SP	----	R6135628	SP	SP	K12C SH. 14	SP	SP	SP	SP	SP	SP	R6133231	----
K12A SH. 14	SP	SP	SP	SP	SP	SP	R6135629	----									
K66A SH. 14	K27 SH. 12	----	K66A SH. 7	----	K72A SH. 12	----	SP	SP	K14GC SH. 6	K26 SH. 12	----	K129 SH. 12	----	------	SEE SH. 17	K72B SH. 12	----
K66A SH. 6	K27 SH. 12	----	K129A SH. 12	----	------	SEE SH. 17	K72A SH. 12	----	K14FC SH. 6	SP	SP	SP	SP	------	SEE SH. 17	SP	SP
K129A SH. 6	SP	SP	R6136103	----	STATUS LIGHTS SH. 3A	----	R6136009	----	K14GC SH. 14	K26 SH. 12	----	K66B SH. 7	----	K72B SH. 12	----	SP	SP
K31 SH. 13	K31 SH. 13	----	SP	SP	K21-R623A SH. 13	K21-R623A SH. 12	R6138601	----	K14HC SH. 14	SP	SP	R6136103	----	STATUS LIGHTS SH. 3	----	R6136009	----
K10TA SH. 16	SP	SP	SP	SP	----	SEE SH. 17	SP	SP									


PRC APERTURE CARD

ORIGINAL DRAWING	B23E445CA
M. ELECT. DESIG.	SH. 1B REV. 10
NUC STEAM SUPPLY SHUTOFF SYSTEM	
FOR MAC. REF.	

3/6/78	CONSTRUCTION		
	PRELIMINARY		
DATE	RELEASED FOR	BY	CHK.

THE CLEVELAND ELECTRIC ILLUMINATING CO.

PERRY NUCLEAR POWER PLANT — UNIT 1

ELECTRICAL-ELEMENTARY DIAGRAM

NUCLEAR STEAM SUPPLY SHUTOFF SYSTEM

RELAY TABULATIONS

GILBERT ASSOCIATES, INC. ENGINEERS AND CONSULTANTS

READING PA.

044949-000 | B | A | 7-25-77 | UNIT 1 | -206-010

CHANGED TABULATION

REVISED K31 & K32 PER GE REV. 6

B | Y2 | Tan | Dec | Mar 2/1/82 | A | Fam | DPB | DEC | Fam | 7-25-77

REV. | MADE BY | CHKD | APPROVED | DATE | REV. | MADE BY | CHKD | APPROVED | DATE

DRAWING | MAGNETIC | CHKD | APPROVED | DATE

RELAY TABULATIONS

Rids

8212130391

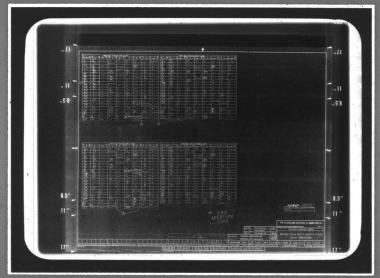

MMM 5624 — FILMSORT® Brand Aperture & Camera Cards and DUPLICARD® Brand Copy Cards — Product of 3M Company, St. Paul, Minn.