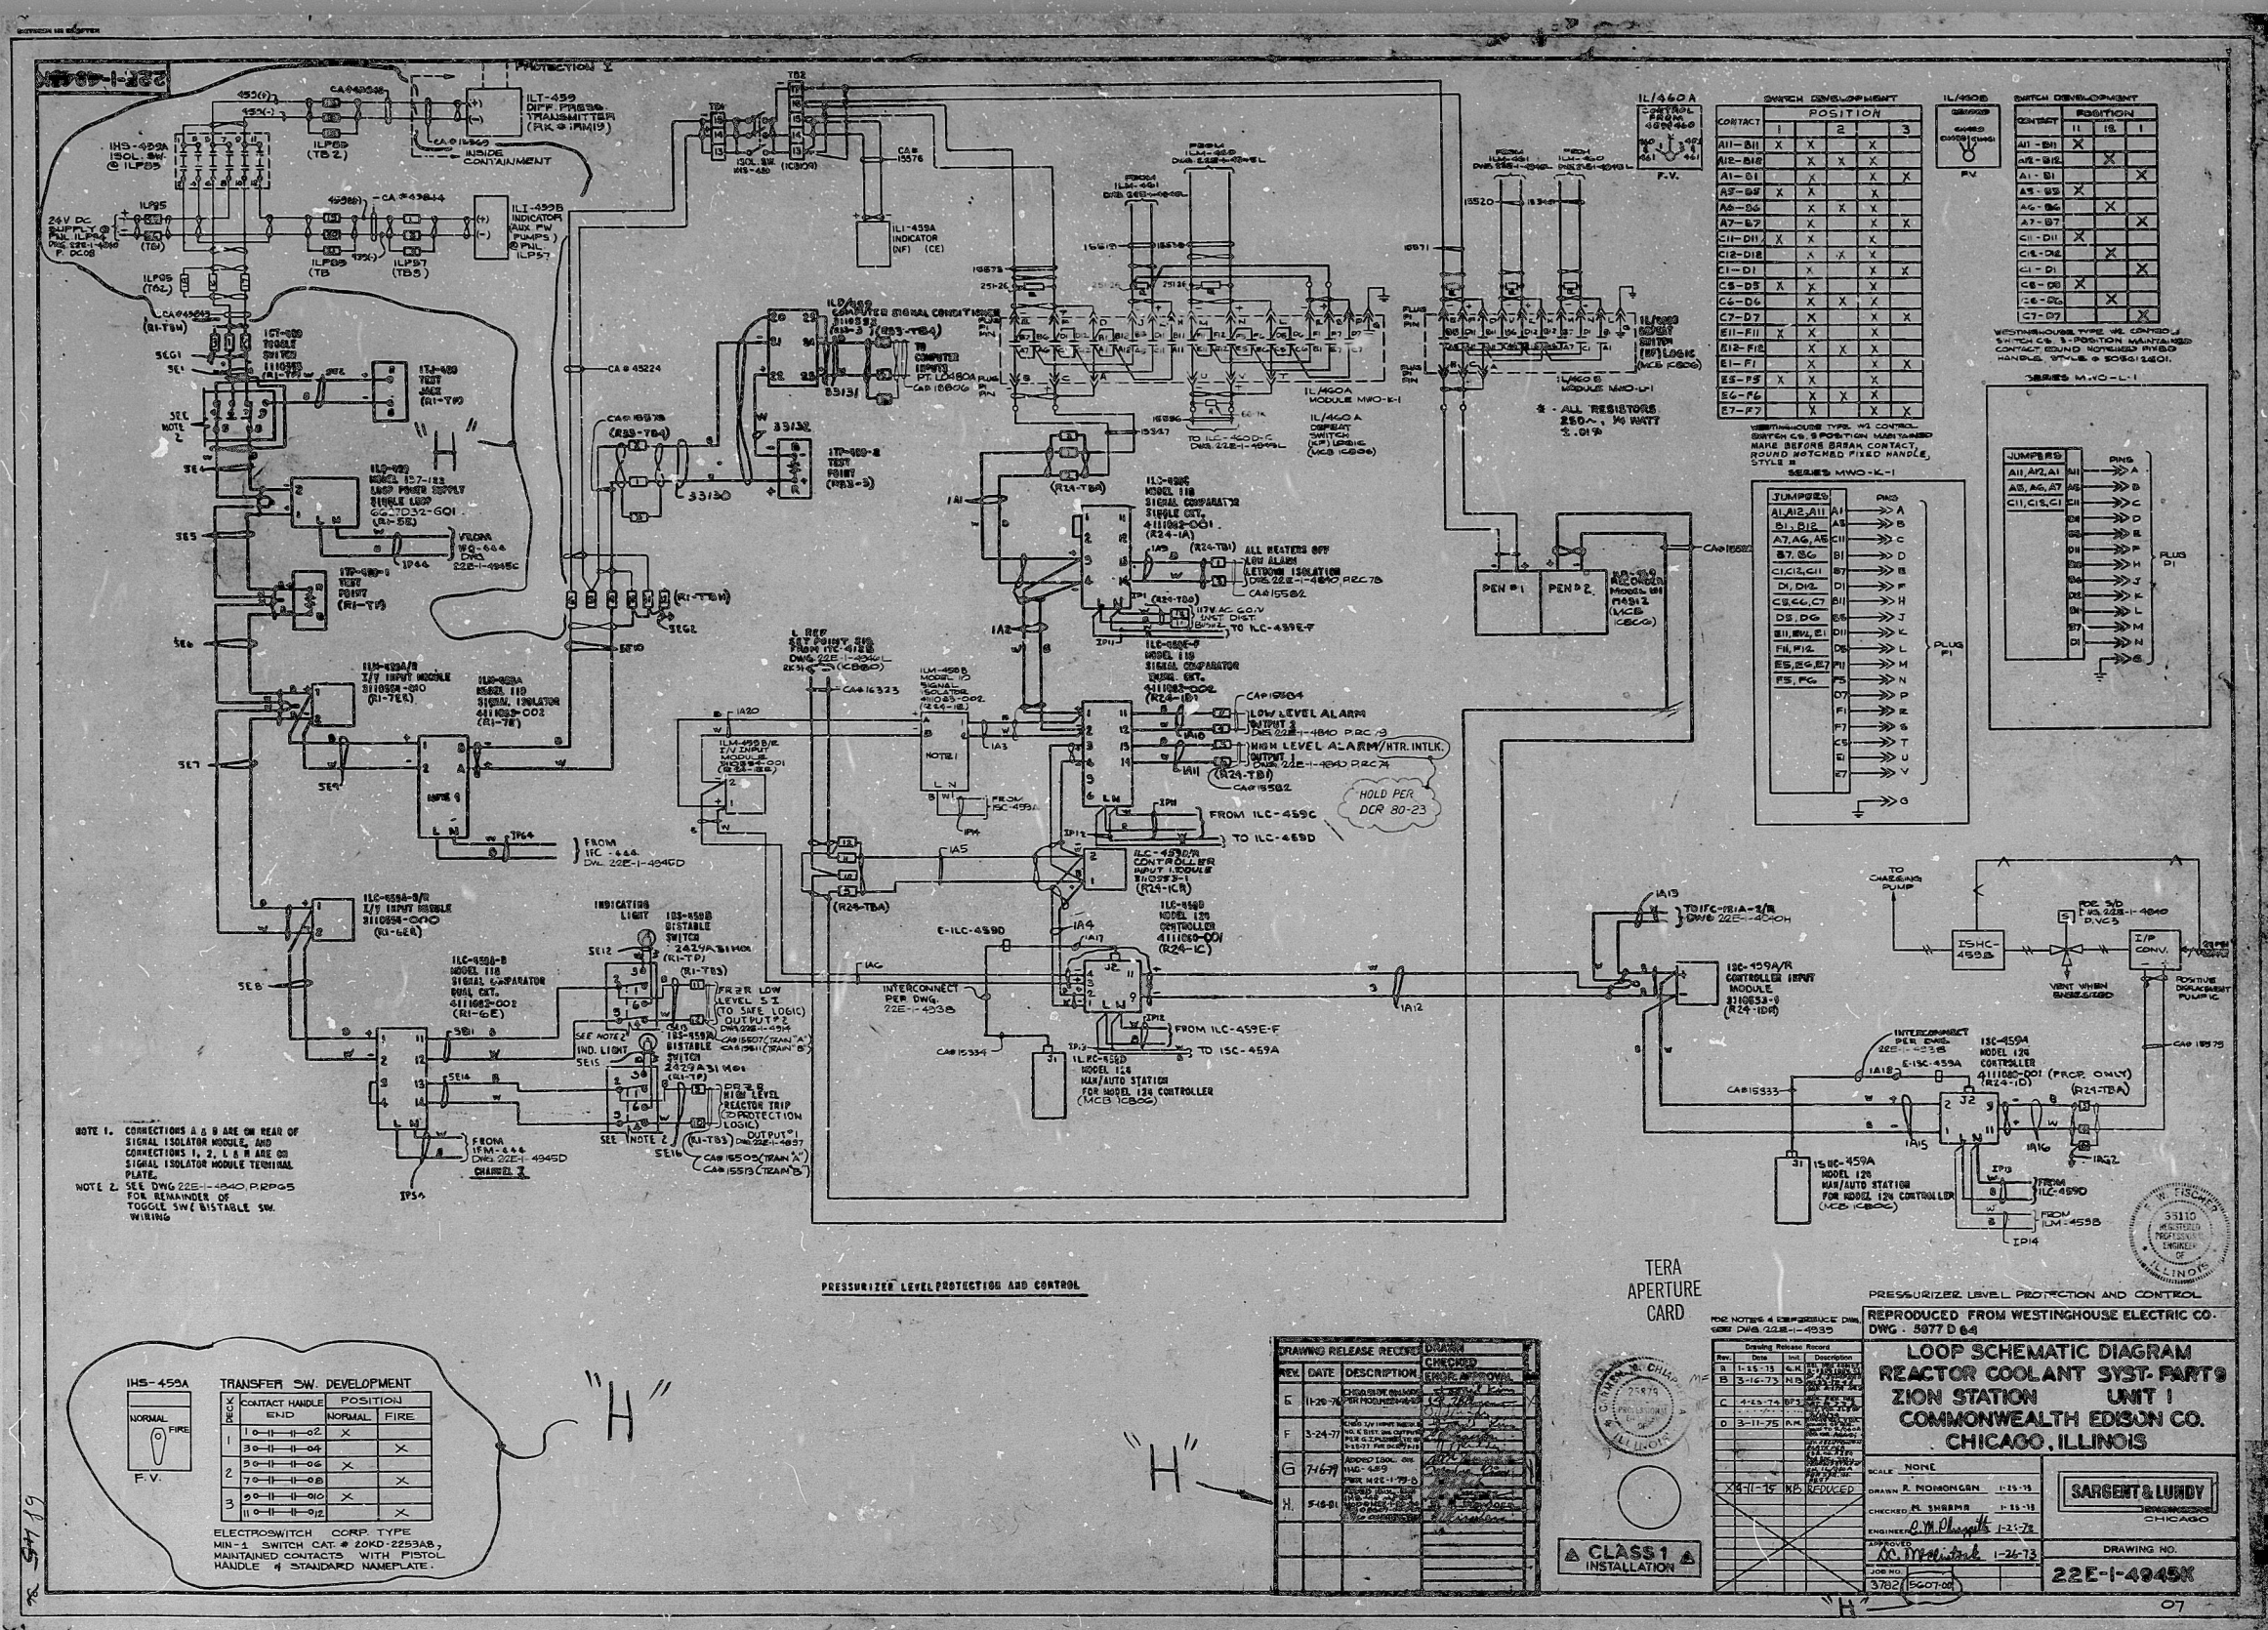


TRANSFER SW DEVELOPMENT

CONTACT HANDLE	POSITION	END	NORMAL	FIRE

MAINTAINED CONTACTS WITH PISTON
HANDLE & STANDARD NAMEPLATE.

CLASS 1 INSTALLATION

REL	DATE	DESCRIPTION	CHECKED
REPRODUCED FROM WESTINGHOUSE ELECTRIC CO. DWG. 5977D 64

LOOP SCHEMATIC DIAGRAM
REACTOR COOLANT SYST. PARTS
ZION STATION UNIT 1
COMMONWEALTH EDISON CO.
CHICAGO, ILLINOIS

SCALE: NONE

DATE: 1-24-73

DRAWING NO. 22E-1-4945X

PIDS

8106300107

