
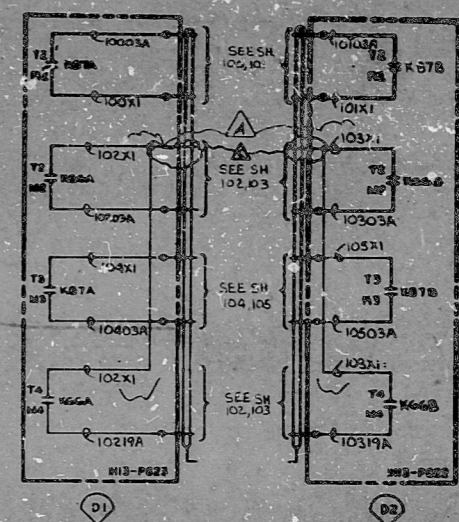
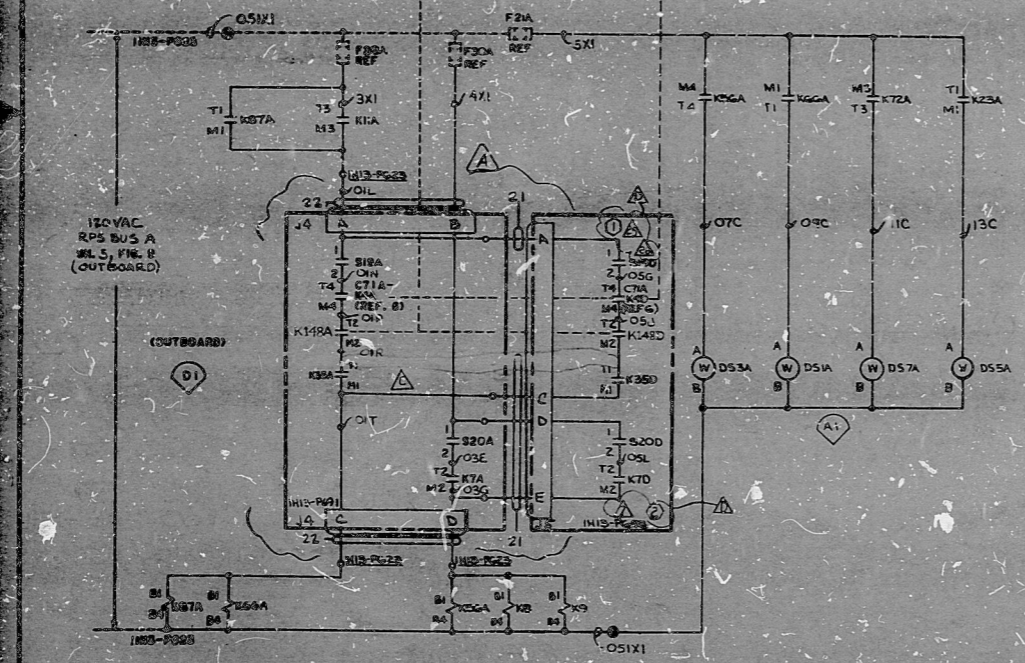


11  
8.5  
11  
17

11  
8.5  
11  
17

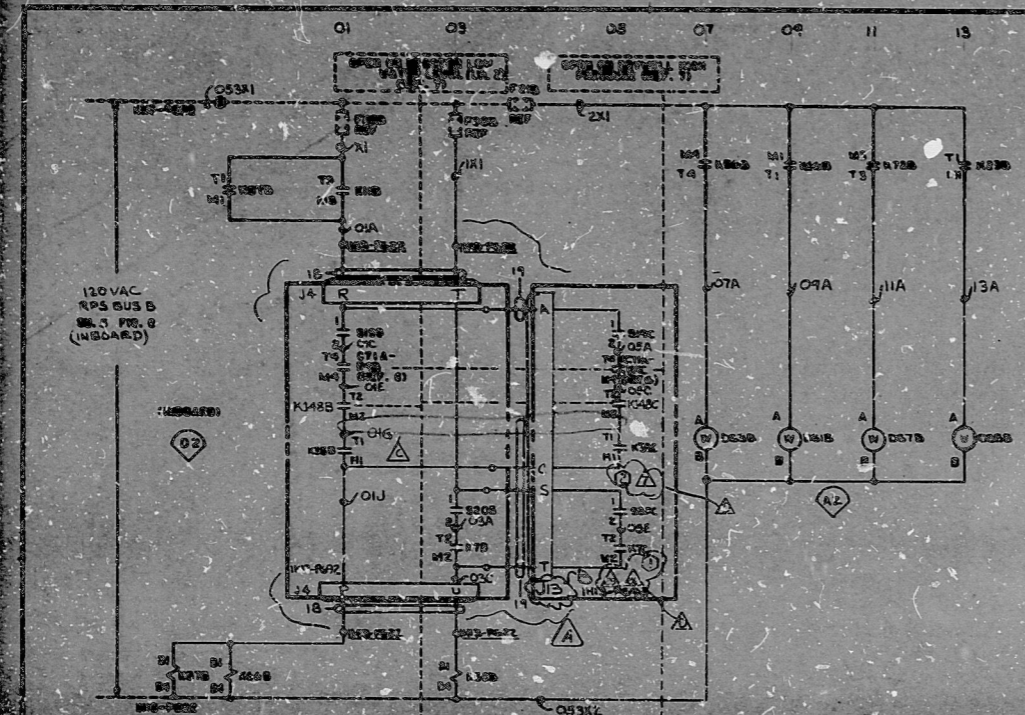

ISOLATION SIGNALS  
CONTACTS OPEN ON DRYWELL HIGH  
PRESSURE OR REACTOR VESSEL WATER  
LEVEL 2 (REF 4)

- 1. CLOSE ISLD VALVES.
- 2. START SGYS.
- 3. CLOSE DRYWELL PURGE 2  
INLET VALVES.
- 4. INITIATE & PURSUE  
COMPRESSOR UNIT SYS.  
(REF 5).

PRC  
APERTURE  
CARD

- ① NOTE Δ APPLIES TO RELAYS ONLY
- ② NOTE △ APPLIES TO CONTROL SWITCHES  
ONLY

LINE CODES: 18, 19, 21, 22, 24, 26

NUCLEAR SAFETY RELATED  
THE CLEVELAND ELECTRIC ILLUMINATING CO.  
PERRY NUCLEAR POWER PLANT UNIT 1  
ELECTRICAL-ELEMENTARY DIAGRAM  
NUCLEAR STEAM SUPPLY SHUTOFF SYSTEM  
RADWASTE SYSTEM TRIP LOGIC &  
STATUS LIGHT

828445CA  
SH 7 REV 12  
NUC STEAM SUPPLY SHUTOFF SYSTEM

3/6/78	CONSTRUCTION	3/24/78
	PRELIMINARY	
	RELEASED FOR	ENGR

GILBERT ASSOCIATES, INC.  
ENGINEERS AND CONSULTANTS

REVISED PER GE DRAWING REV 12	ADDED WIRES AND DELETED WIRES AS PER GE DWG REV 11	REVISED J9 TO J13 PER GE REVISION 7	ADDED FLGS PER GE REV 6	READING PA	044549-000	BS	DES	ON	3599	B-208-013	021	000	D
D SMH	C YZ	B CAM	T RAY										
REV MADE CHKD APPROVALS DATE	REV MADE CHKD APPROVALS DATE	REV MADE CHKD APPROVALS DATE	REV MADE CHKD APPROVALS DATE	WORK ORDER	MADE	CHKD	DR	APP	DATE	PRINTING NUMBER	SYSTEM	REV	

ELEM DIAG W/ATH TRIP LOGIC STAT LIT



Aids

82-2130399

