


YB NO.	FIXED	0-90	100-100	USE
7	11	X	X	VALV CLOSED IND
8	9	X	X	SP
13	10	X	X	RPS REF G
14	17	X	X	RPS REF G
19	18	X	X	RPS REF G
20	19	X	X	RPS REF G
25	23	X	X	VALV OPEN IND
26	24	X	X	DCS
27	25	X	X	TRANSMIT TEST
28	26	X	X	SP
35	27	X	X	MSIV LCS
36	28	X	X	MSIV LCS

(X: CONTACT CLOSED)  
 MAIN STEAM LINE LIMIT SWITCH DEVELOPMENT

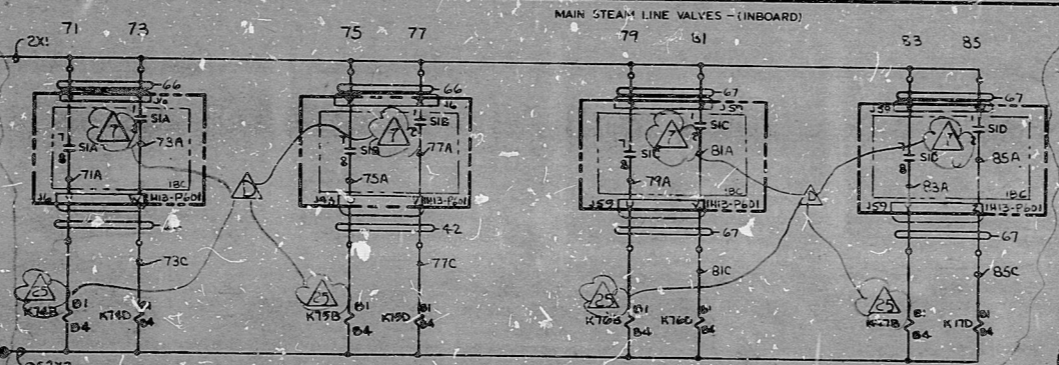

NOTES  
 1. IHS-P710A TERMINATION CABINET  
 LINE CODE 55 - TM011  
 LINE CODE 64 - TM013  
 LINE CODE 65 - TM015

PRC APERTURE CARD

LINE CODES: 42, 55, 60-67

82BE4450A  
 SH-10-REV-12  
 NUC STEAM SUPPLY SHUTOFF SYSTEM

NUCLEAR SAFETY RELATED

THE CLEVELAND ELECTRIC ILLUMINATING CO.

PERRY NUCLEAR POWER PLANT UNIT 1

ELECTRICAL-ELEMENTARY DIAGRAM

NUCLEAR STEAM SUPPLY SHUTOFF SYSTEM

MAIN STEAM LINE ISOLATION VALVES

INBOARD F022A, F022B, F022C, F022D

REV	MADE	CHKD	APPROVALS	DATE	REV	MADE	CHKD	APPROVALS	DATE	REV	MADE	CHKD	APPROVALS	DATE	REV	MADE	CHKD	APPROVALS	DATE	WORK ORDER	MADE	CHLD.	DR. APP.	ENG. APP.	DATE	04	4549	B-208-013	B21	H10	D		
D	SLM	TAM	RAM	8/1/82	C	YZ	TAM	DEC	RAM	11/1/82	B	CAM	RAM	DEC	RAM	1-4-82	A	RAM	DEC	RAM	7-25-79	044549-000	BS	DHS	DEC	YMS	2/18/76	04	4549	B-208-013	B21	H10	D

ELEM DIAG I1821-F022A, B, C, D

11

11

11

8.5"

11"

17

11

11

11

8.5"

11"

17

Rids

8212130403

