



SCALING RULES

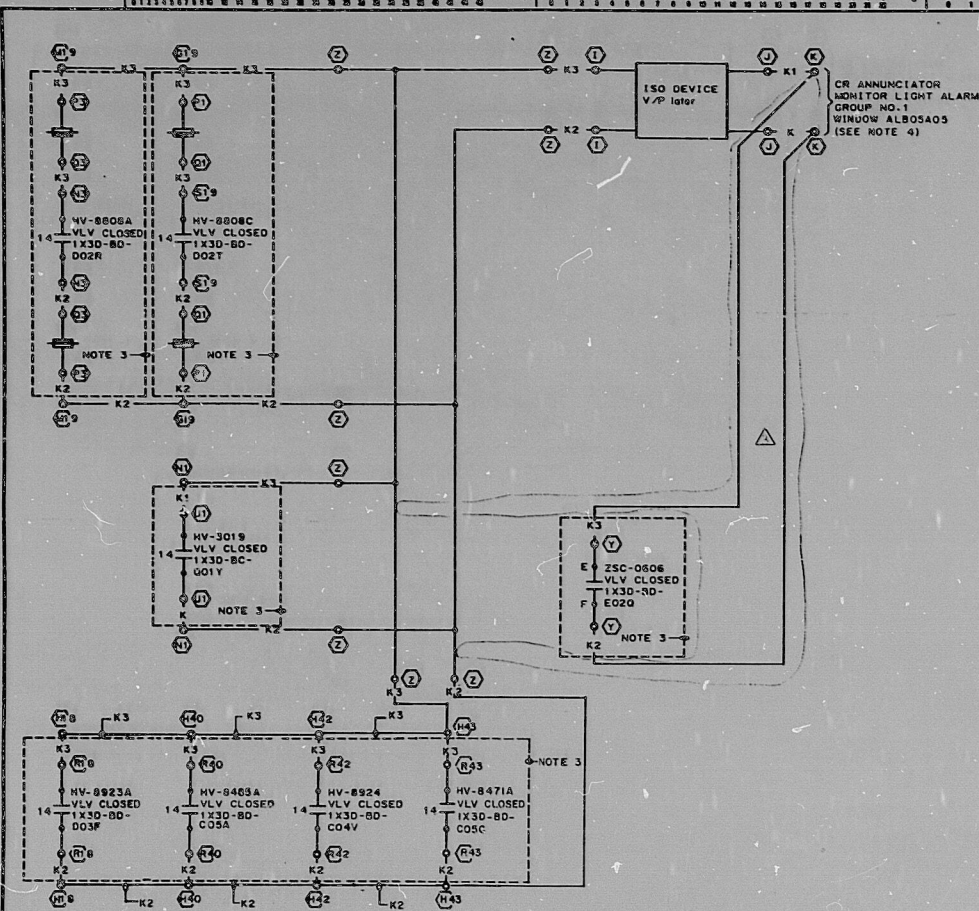

PRC
APERTURE
CARD

- NOTES:
1. FOR SPECIAL NOTES AND SYMBOLS REFER TO D/L 1X30-AA-000A/C,D,F THRU R.
 2. ○ DENOTES EQUIPMENT LOCATION NUMBER. FOR COMPLETE EQUIPMENT LOCATION NUMBER REFER TO CABLING BLOCK DIAGRAM.
 3. CIRCUIT SHOWN WITHIN DOTTED LINES CARRIES THE SCHEME NUMBER OF REFERENCED E/D.
 4. CIRCUIT AFTER THE ISOLATION DEVICE IS CONSIDERED NON-CLASS 1E.

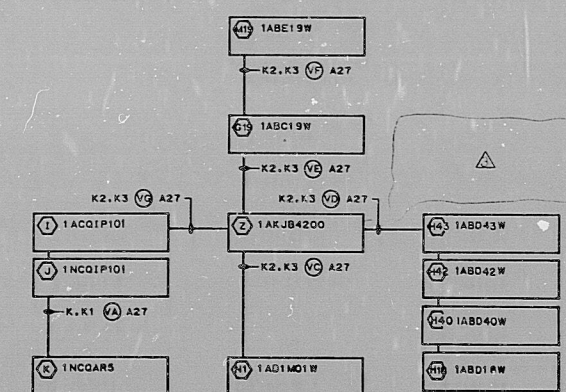

NUCLEAR SAFETY RELATED [A]

BECHTEL
LOS ANGELES

GEORGIA POWER COMPANY
ALVIN W. VOGTLE NUCLEAR PLANT

ELEMENTARY-DIAGRAM
MONITOR LIGHT ALARM
GROUP 1-TRAIN A

NO.	REVISIONS	DATE	DR.	CHK.	APP.	EGS	CHK.	P.E.	Q.A.	NO.	REVISIONS	DATE	DR.	CHK.	APP.	EGS	CHK.	P.E.	Q.A.	NO.
1											1									

SCALB: NCHE
JOB NO. 5530
DRAWING NO. 1X30-BE-M03A
REV. 3

KIDS

8310030554

