

11

11

8.5

8.5

11

17

11

11

8.5

8.5

11

17

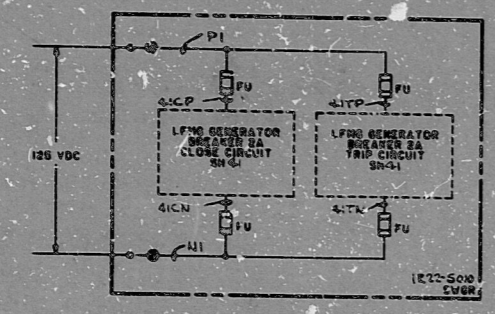


FIG. 10

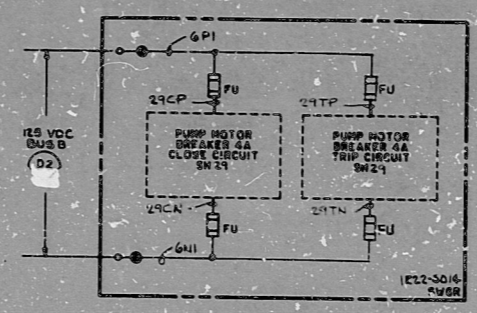
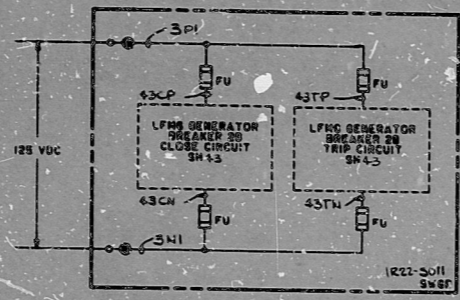


FIG. 12

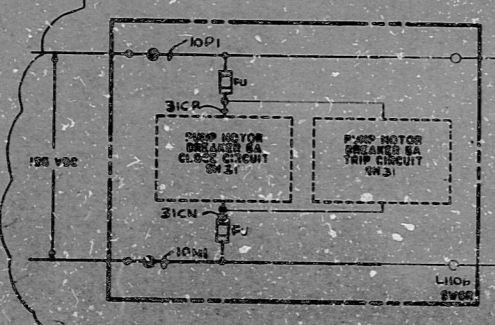
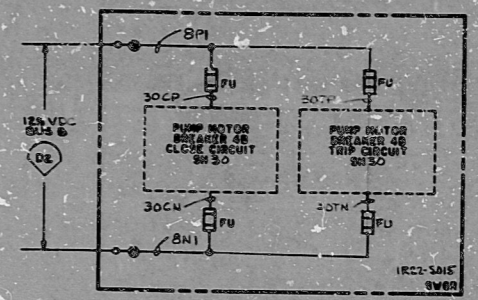


FIG. 14

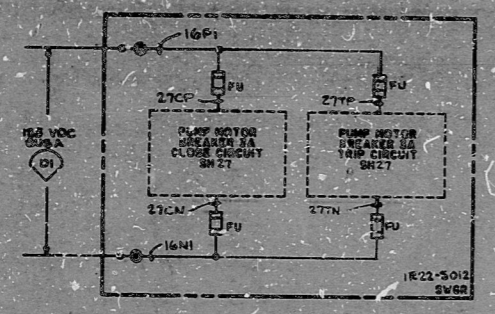
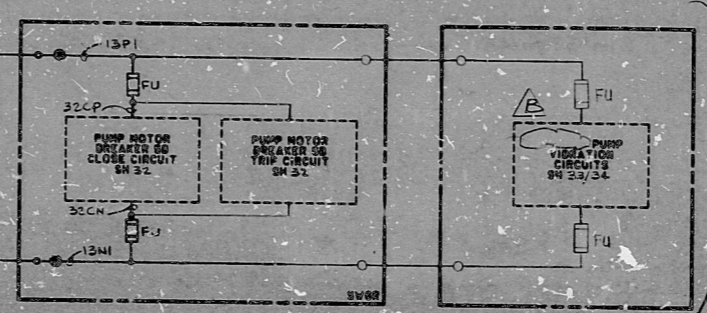
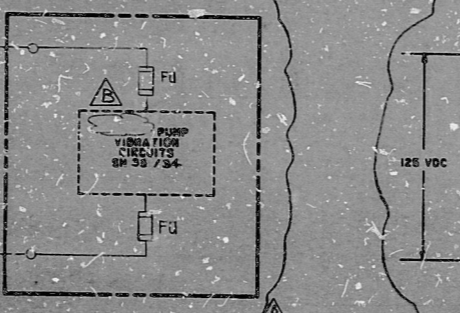


FIG. 17



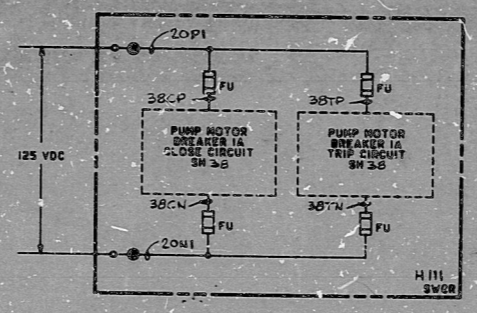


FIG. 19

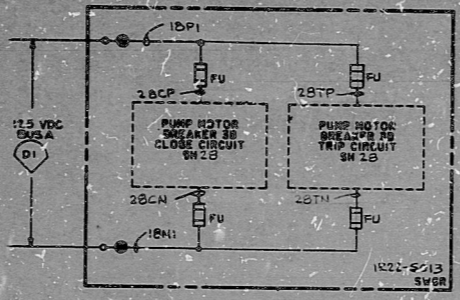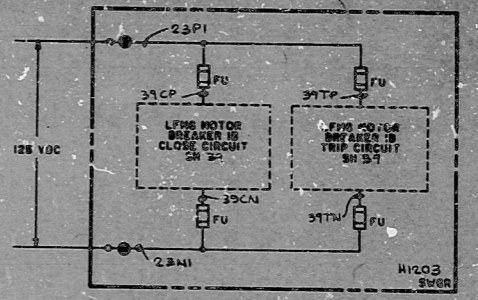

PRC APERTURE CARD

LINE CODES: NONE THIS SHEET

NUCLEAR SAFETY RELATED

THE CLEVELAND ELECTRIC ILLUMINATING CO.

PERRY NUCLEAR POWER PLANT

ELECTRICAL REACTOR SYSTEM

826E443CA  
5th REV 10

5-20 CONSTRUCTION  
PRELIMINARY

DATE RELEASED FOR

REVISED ATWS CIRCUITRY  
REV PER CE DRAWING

GILBERT ASSOCIATES, INC.  
ENGINEERS AND CONSULTANTS

01 YC 100 B Amelko A Rys Rev 10/77 044540-000 WU 1/5

