


LEGEND:
 (A) WIRE LOCATED IN 1103-SR1-SL19-F9
 (B) EXTERNAL WIRE MARK (SEE NOTE 213)
 (C) MISC TERMINAL (WITH DRAWING PROVISION)
 (D) CLASS IC DIV. 1 THIS SHEET
 (E) PENETRATION THRU CONTAINMENT
 (F) K22A - CASUALTY CONTROL RELAY TYPE 0101M
 (G) IH13-P601 - ECC'S BENCHBOARD
 (H) IH13-P632 - DIV. 1 LEAK DETECTION PUMP ON-LL
 (I) IH13-P713F - PELL TERM. CAB. TM001
 (J) IH13-P715E - PELL TERM. CAB. TM001

REFERENCE:
 G.E. CO. DWG. 024820004M 04, REV. 2

NOTES:
 1. ALL DEVICES WITHOUT LOCATION MARKS ARE LOCATED IN MCC.
 2. ALPHABETICAL WIRE MARKS ARE PREFIXED BY: SUB-SYSTEM NO., SHEET NO. (LINE NO. (EXAMPLE: C41A 0501A))
 3. POTENTIAL WIRE MARKS ARE PREFIXED BY: SYSTEM NO. & SHEET NO. (EXAMPLE: C41A 05 11)
 4. DEVICE DESIGNATIONS ARE PREFIXED BY: UNIT & SYSTEM NO. (EXAMPLE: X41-001A) EXCEPT AS NOTED. (SEE NOTE 6)
 5. FOR GRAPHIC STANDARDS REFER TO DRAWING B-208-001
 6. THE FOLLOWING DEVICES ARE PREFIXED BY C41A:
 F3 - FUSE
 K2A - RELAY
 S1A - SWITCH
 K22A - RELAY

7. FOR 34A SW. DEV., SEE SH. 01

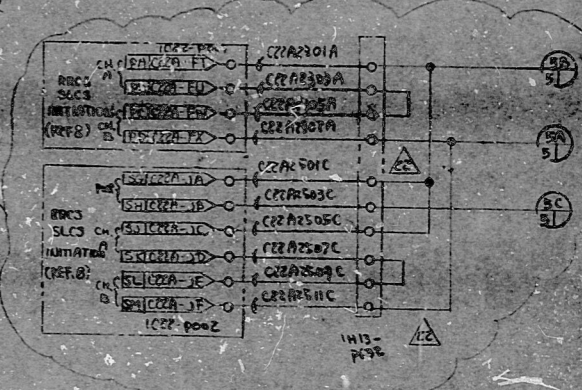

S1A / IH13-P601		CONTROL SWITCH		CONTACT LOCATION
CR130-UN100D (CAM 9)	OPERATOR	NAMEPLATE (F.V.)		
TR 1 2		OFF	ON	02 25
TR 3 4		X	X	01
BF 5 6		X		SPARE
SR 7 8		X	X	03
TRT 9 10		X		03 17
TRT 11 12		X	X	03 08
BPT 13 14		X		SPARE
BRT 15 16			X	SPARE
TANDEM BLOCK CR130-UN107		X - CLOSED CONTACT		
KEYLOCK SW. KEY REMOVABLE IN OFF POS.				

PRC APERTURE CARD

NUCLEAR SAFETY RELATED

THE CLEVELAND ELECTRIC ILLUMINATING CO.
 PERRY NUZ. EAR POWER PLANT
 ELECTRICAL-ELEMENTARY DIAGRAM
 STANDBY LIQUID CONTROL SYSTEM
 STANDBY LIQUID CONTROL PUMP
 C001A


Rids

8212140026

